

VICINITY MAP

N.T.S.

THE CITY OF
CORONA, CALIFORNIA
DEPARTMENT OF WATER AND POWER
**RESIN TREATMENT OF
NITRATE SOURCES**
WELLS 32 AND 33 EQUIPPING
PROJECT NO. 70330507
JULY 2017



CITY COUNCIL

DICK HALEY, MAYOR


KAREN SPIEGEL, VICE MAYOR

JASON SCOTT

EUGENE MONTANEZ

RANDY FOX

INDEX OF SHEETS

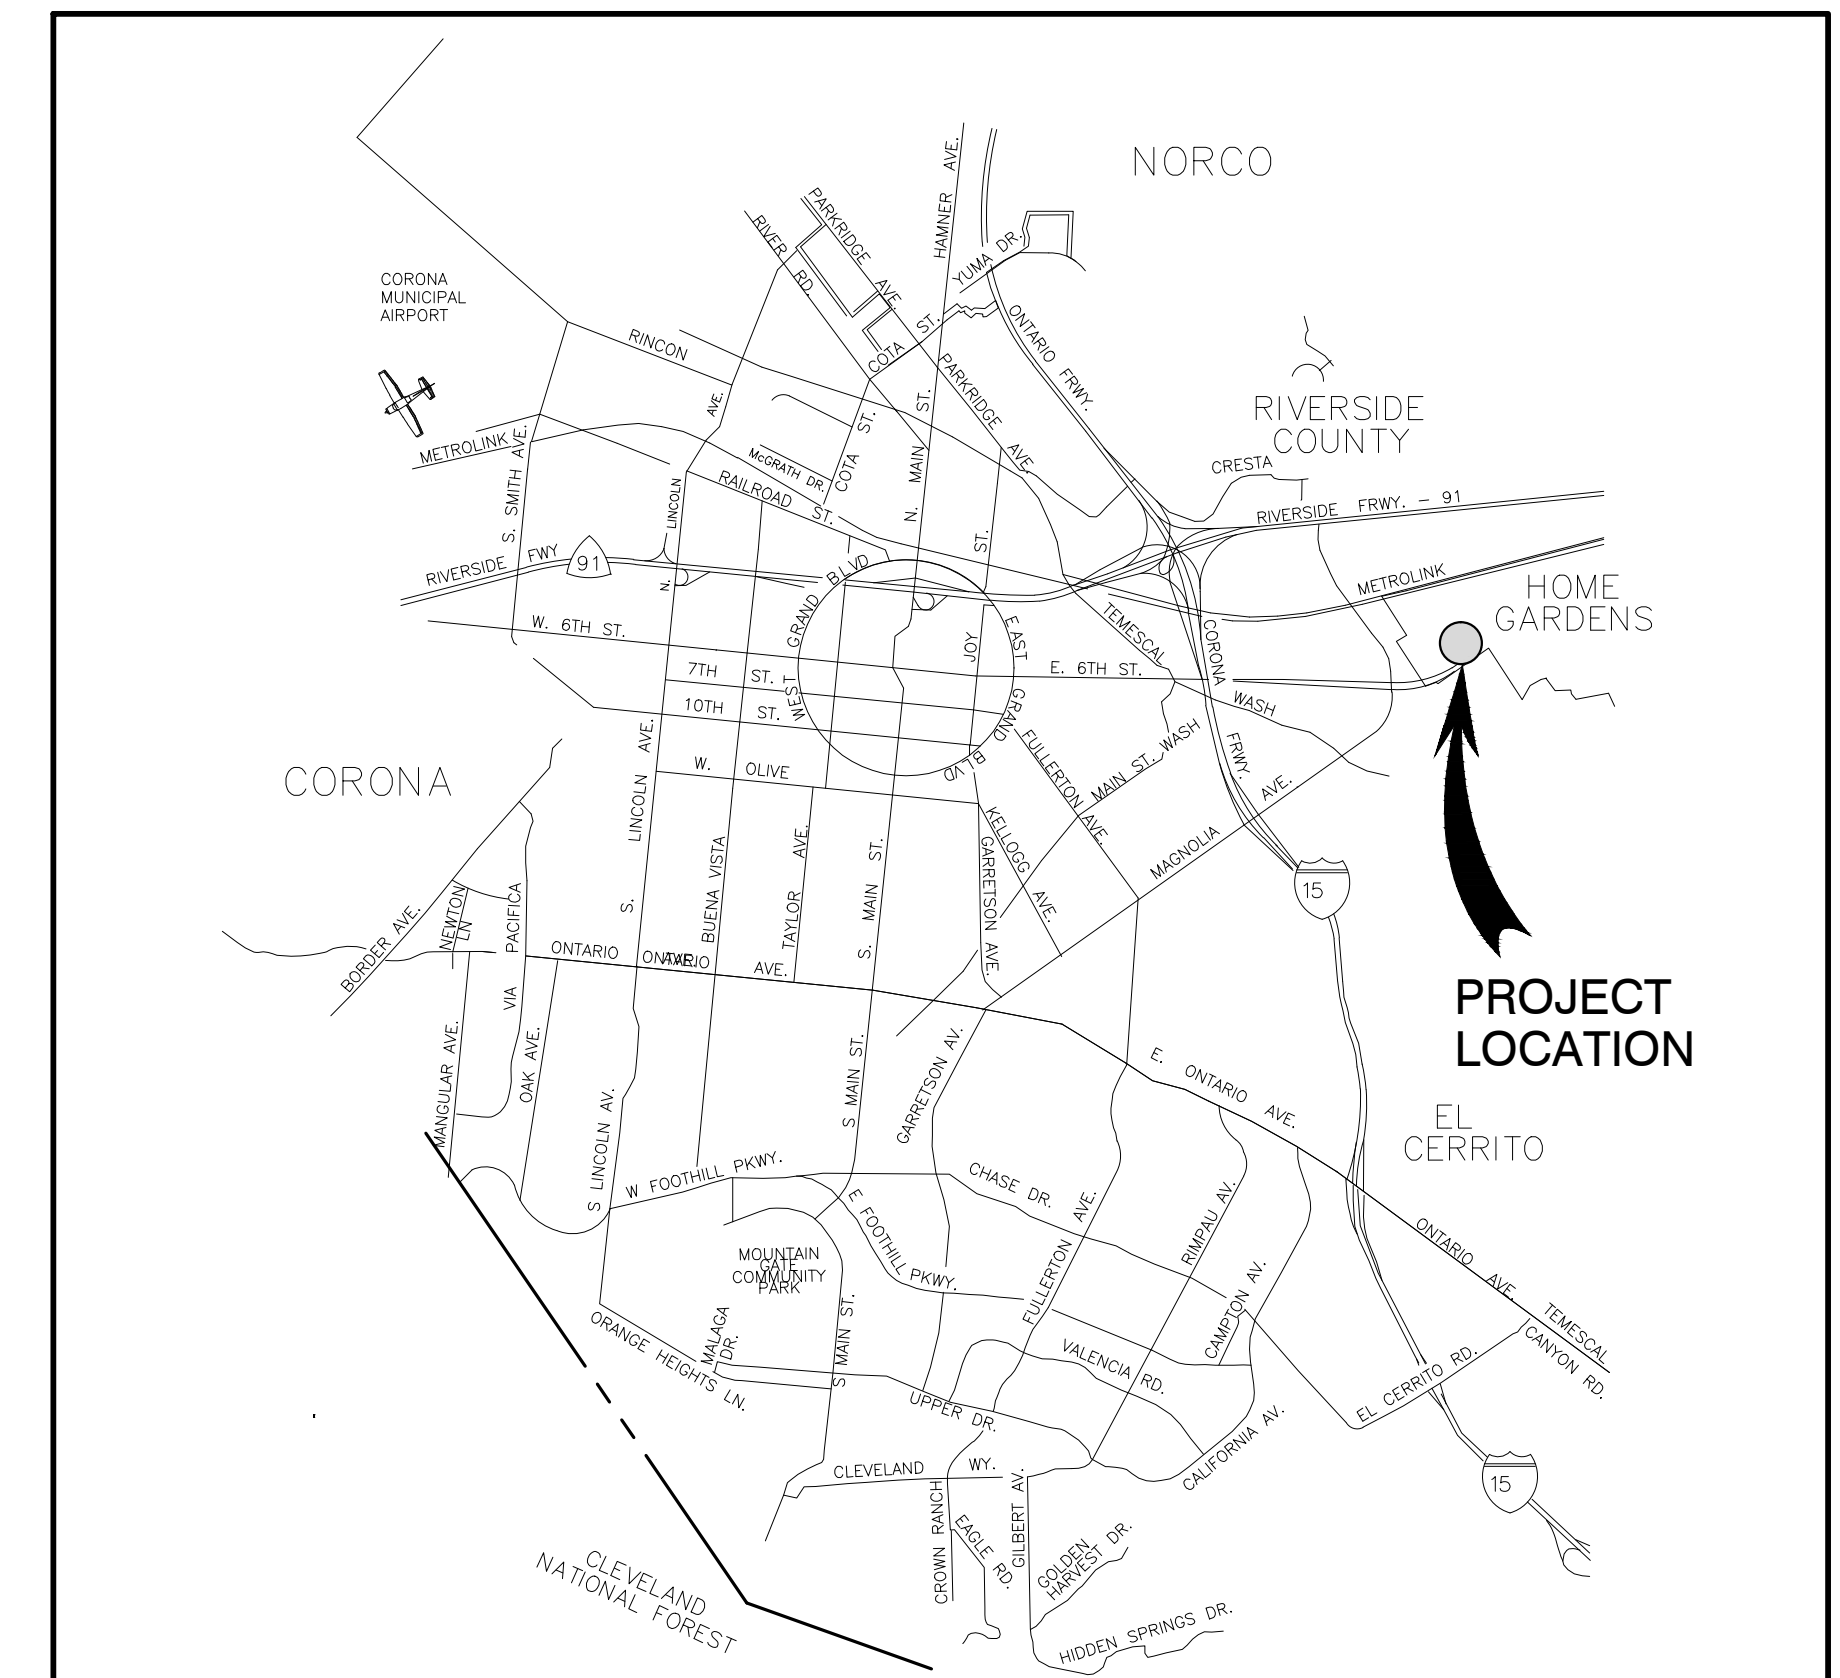

LOCATION MAP

N.T.S.


DWG NO.	SHEET NO.	DESCRIPTION	DWG NO.	SHEET NO.	DESCRIPTION
T-1	1	TITLE SHEET, VICINITY AND LOCATION MAPS AND INDEX OF SHEETS	S-1	12	WELLHOUSE GENERAL STRUCTURAL NOTES
T-2	2	GENERAL NOTES, ABBREVIATIONS AND LEGEND	S-2	13	FOUNDATION AND ROOF FRAMING PLANS
C-1	3	SITE PLAN	S-3	14	STRUCTURAL DETAILS
C-2	4	SITE IMPROVEMENT DETAILS	E-1	15	ELECTRICAL SYMBOLS AND LEGEND
C-3	5	YARD PIPING AND FINISHED GRADE ELEVATIONS	E-2	16	ELECTRICAL SINGLE LINE DIAGRAM AND CONTROL DIAGRAMS
M-1	6	WELL PUMP MECHANICAL PLAN	E-3	17	CONDUIT PLAN
M-2	7	WELL PUMP MECHANICAL SECTIONS	E-4	18	LIGHTING PLAN
M-3	8	MECHANICAL DETAILS	E-5	19	WELL VFD CONTROL DIAGRAM I
A-1	9	FLOOR AND ROOF PLANS	E-5A	19A	WELL VFD CONTROL DIAGRAM II
A-2	10	BUILDING ELEVATIONS AND SECTIONS	E-6	20	GENERAL ELECTRICAL DETAILS
A-3	11	ARCHITECTURAL DETAILS	L-1	21	LANDSCAPING AND IRRIGATION PLAN

Underground Service Alert
Call: TOLL FREE

TWO WORKING DAYS BEFORE YOU DIG

[illegible]

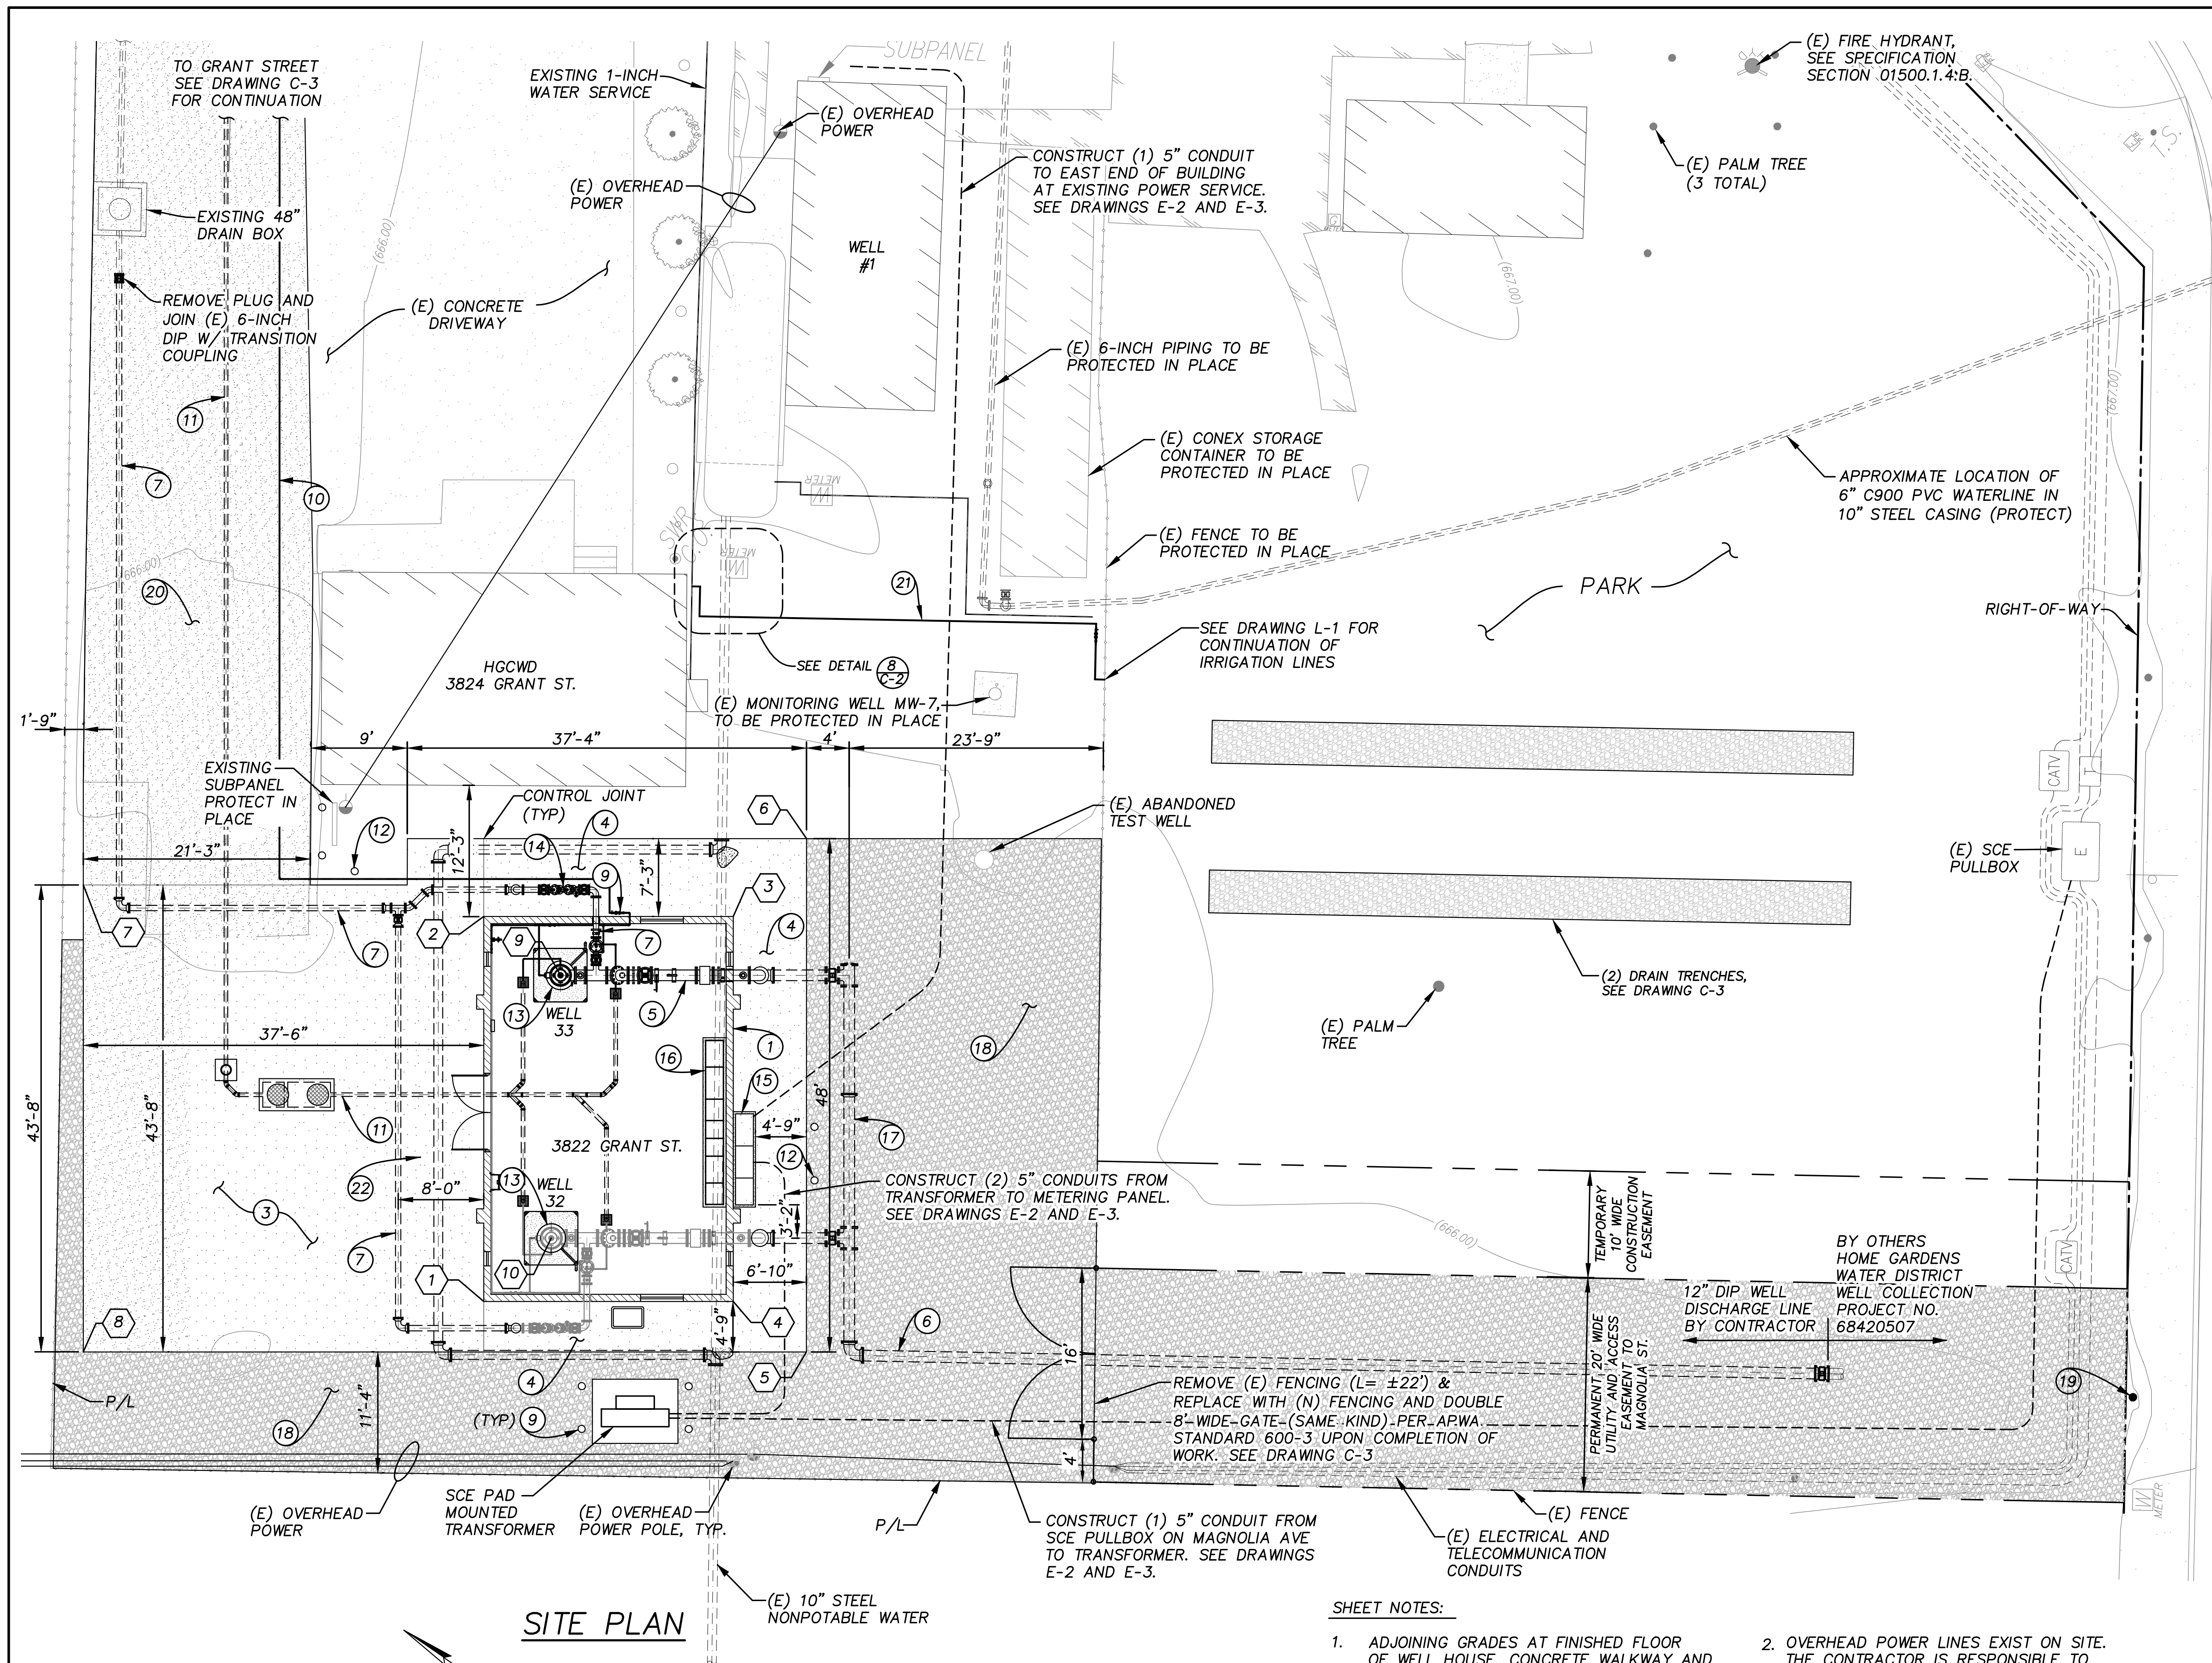

PUMP STATION COORDINATE TABLE			
No.	DESCRIPTION	NORTHING	EASTING
1	NORTH-WEST CORNER OF BUILDING	2265600.58	6175710.24
2	NORTH-EAST CORNER OF BUILDING	2265621.07	6175739.84
3	SOUTH-EAST CORNER OF BUILDING	2265601.89	6175753.12
4	SOUTH-WEST CORNER OF BUILDING	2265581.40	6175723.52
5	SOUTH-WEST CORNER OF SIDEWALK	2265573.08	6175723.54
6	SOUTH-EAST CORNER OF SIDEWALK	2265600.41	6175763.01
7	NORTH-EAST CORNER OF DRIVEWAY	2265653.55	6175720.94
8	NORTH-WEST CORNER OF DRIVEWAY	2265628.69	6175685.04
9	CENTER OF WELL 33	2265612.05	6175739.40
10	CENTER OF WELL 32	2265598.77	6175718.70

- CONSTRUCTION/DESTRUCTION NOTES:**
1. CONSTRUCT WELL PUMP BUILDING PER ARCHITECTURAL AND STRUCTURAL DRAWINGS.
 2. NOT USED.
 3. CONSTRUCT 6-INCH CONCRETE OVER 6-INCH CRUSHED AGGREGATE BASE (COMPACTED TO 95% RELATIVE DENSITY) BUILDING ACCESS ROAD PER DETAIL 3 ON DRAWING C-2.
 4. CONSTRUCT CONCRETE SIDEWALK AROUND PROPOSED BUILDING (WEST, SOUTH, AND EAST SIDES) PER DETAIL 2 ON DRAWING C-2.
 5. PROVIDE AND INSTALL PUMP DISCHARGE PIPING INSIDE THE BUILDING PER DRAWING M-2.
 6. CONSTRUCT 12-INCH D.I. CLASS 350 BELOW GRADE PUMP DISCHARGE PIPING PER DRAWING C-3.
 7. CONSTRUCT 6-INCH CLASS 54 DUCTILE IRON PUMP TO WASTE LINE PER DRAWING C-3 AND M-2.
 8. PROVIDE AND INSTALL 1-INCH WATER METER PER CITY OF CORONA STANDARD DETAIL 414 (SEE C-3 FOR LOCATION).
 9. PROVIDE AND INSTALL 1-INCH REDUCED PRESSURE PRINCIPLE BACKFLOW ASSEMBLY PER THE CITY OF CORONA STANDARD DETAIL 428. ALL PIPING DOWNSTREAM OF RP DEVICE SHALL BE ABOVE GRADE.
 10. PROVIDE AND INSTALL 1-INCH COPPER LINE FROM PROPOSED METER TO THE WELL BUILDING. SEE DETAIL 1 ON SHEET M-1 FOR INSIDE THE BUILDING PIPING AND CONNECTION TO WELL PUMPS.
 11. CONSTRUCT BUILDING DRAIN SYSTEM PER DRAWINGS C-3 AND M-2.
 12. PROVIDE AND INSTALL PROTECTIVE BARRIERS PER SCE REQUIREMENTS (TYP OF 9).
 13. CONSTRUCT WELL HEAD PER DRAWINGS M-3.
 14. PROVIDE AND INSTALL CITY AND SWRCB-DDW APPROVED 6-INCH REDUCED PRESSURE PRINCIPLE BACKFLOW PREVENTER DEVICE (FEBCO MASTER SERIES LF860).
 15. PROVIDE AND INSTALL SCE METER AND PULL SECTION PER DRAWING E-2.
 16. INSTALL CITY PROVIDED MOTOR CONTROL CENTER AND PLC/SCADA PER DRAWING E-2.
 17. CONSTRUCT 12-INCH D.I. CLASS 54 BELOW GRADE PUMP DISCHARGE PIPING PER DRAWINGS C-3 AND M-2.
 18. INDICATES REMOVE AND LEGALLY DISPOSE OF TOP 8-INCH OF SOIL (±110CY) OFF SITE. INSTALL 8-INCHES OF ¾-INCH CRUSHED ROCK. PROVIDE AND INSTALL GEOTEXTILE FABRIC BETWEEN NATIVE SOIL AND CRUSHED ROCK.
 19. REMOVE AND LEGALLY DISPOSE OF THE TREE OFF SITE.
 20. REMOVE AND REPLACE EXISTING PCC PAVEMENT DRIVEWAY PER DETAIL 3 DRAWING C-2. SEE DRAWING C-3 FOR EXTENT OF REPLACEMENT.
 21. CONSTRUCT DRIP IRRIGATION SYSTEM PER DRAWING L-1 AND TIE-IN TO (E) WATER SUPPLY PER DETAIL 8, DRAWING C-2.
 22. JOIN (E) 10" STEEL PIPE (2 PLACES) PER DETAIL 6, DRAWING C-2. RELOCATE BY CONSTRUCTING 10" CL. 350 DUCTILE IRON PIPE, DOUBLE WRAPPED IN 8-MIL POLYETHYLENE, PER PLAN. REMOVE ALL (E) PIPE BETWEEN CUTS. MAINTAIN 30" MIN. COVER. COORDINATE WITH HOME GARDENS COUNTY WATER DISTRICT DURING TIE-IN.

AKM JOB No. 0761209.00



Underground Service Alert
Call: TOLL FREE

CAUTION! OVERHEAD POWER LINES

SCALE IN FEET
1 inch = 8 ft.


0 1/2 1 2 3/4 1 1/2 2 3/4 3 1/2 4 5 6 7 8 9 10 11 12 13 14 15

- SHEET NOTES:**
1. ADJOINING GRADES AT FINISHED FLOOR OF WELL HOUSE, CONCRETE WALKWAY AND HOUSEKEEPING PADS SHALL BE 0.5-FT BELOW FINISHED FLOOR/TOP OF PAD. GROUND SHALL BE SLOPED AWAY AT 2% (MIN.) IN ALL DIRECTIONS FROM STRUCTURES FOR A MINIMUM DISTANCE OF 10-FT. OVERALL SITE SHALL MAINTAIN THE ORIGINAL EXISTING DRAINAGE PATTERN.
 2. OVERHEAD POWER LINES EXIST ON SITE. THE CONTRACTOR IS RESPONSIBLE TO MAINTAIN SAFE WORKING CLEARANCES IN ACCORDANCE WITH THE CODE OF FEDERAL REGULATIONS TITLE 29, VOLUME 8, PART 1926 AND CALIFORNIA CODE OF REGULATIONS TITLE 8, SECTION 2946.
 3. PIPING SHOWN AS SCREENED (WELL 32) SHALL BE INSTALLED IN THE FUTURE AND IS FOR REFERENCE ONLY.

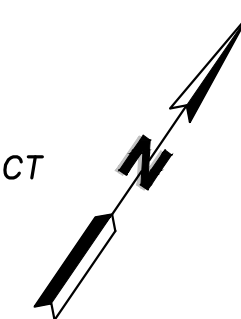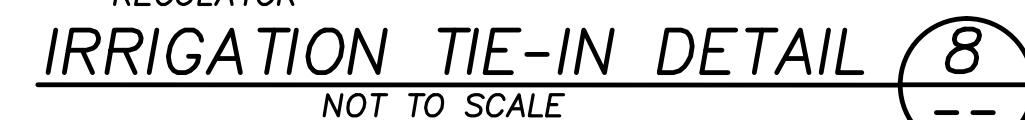

Sht. 4 of 2



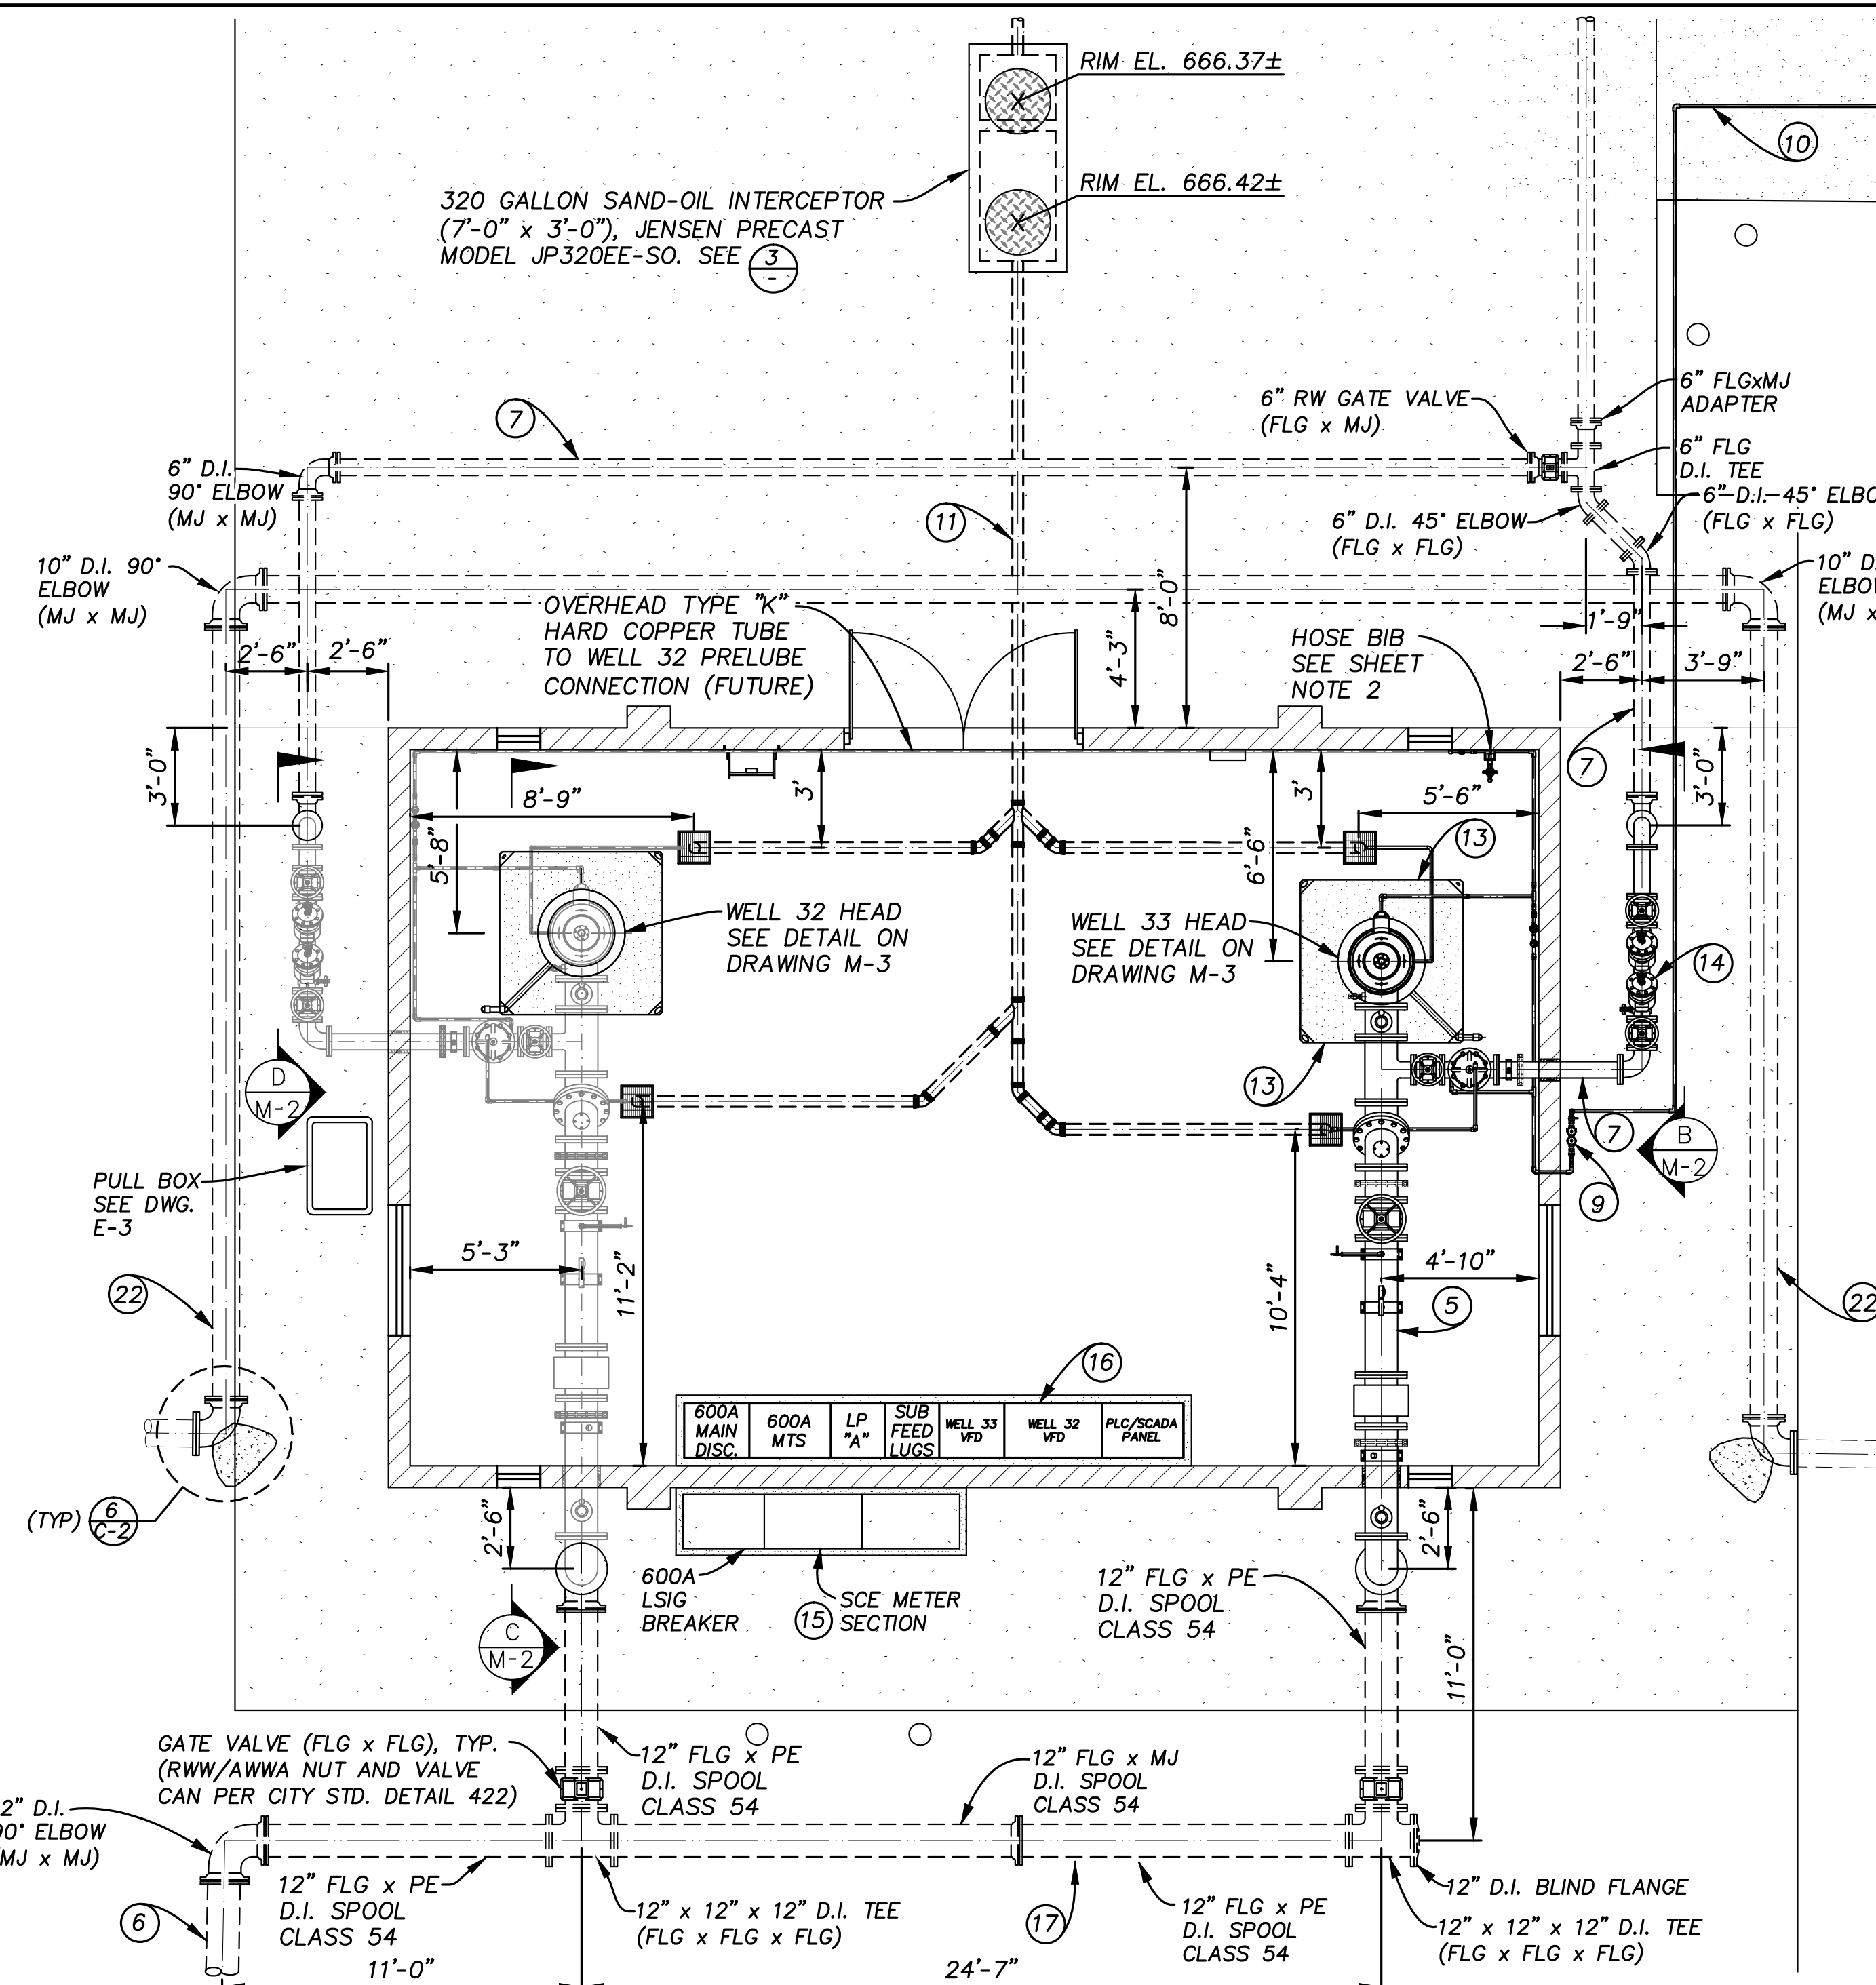


MECHANICAL LAYOUT
SCALE: 1/4" = 1'-0"

CONSTRUCTION NOTES:


- (5) PROVIDE AND INSTALL PUMP DISCHARGE PIPING INSIDE THE BUILDING PER DRAWING M-2.
- (6) CONSTRUCT 12-INCH D.I. CLASS 350 BELOW GRADE PUMP DISCHARGE PIPING PER DRAWING C-3.
- (7) CONSTRUCT 6-INCH CLASS 54 DUCTILE IRON PUMP TO WASTE LINE PER DRAWING C-3.
- (9) PROVIDE AND INSTALL 1-INCH REDUCED PRESSURE PRINCIPLE BACKFLOW ASSEMBLY PER THE CITY OF CORONA STANDARD DETAIL 428. ALL PIPING DOWNSTREAM OF RP DEVICE SHALL BE ABOVE GRADE.
- (10) PROVIDE AND INSTALL 1-INCH COPPER LINE FROM PROPOSED METER TO THE WELL BUILDING. SEE DETAIL 1 ON SHEET M-1 FOR INSIDE THE BUILDING PIPING AND CONNECTION TO WELL 33 PUMP.
- (11) CONSTRUCT BUILDING DRAIN SYSTEM PER DRAWINGS C-3 AND M-2.
- (13) CONSTRUCT WELL HEAD PER DRAWING M-3.
- (14) PROVIDE AND INSTALL CITY AND SWRCB-DDW APPROVED 6-INCH REDUCED PRESSURE PRINCIPLE BACKFLOW PREVENTER DEVICE (FEBCO MASTER SERIES LF860).
- (15) PROVIDE AND INSTALL SCE METER AND PULL SECTION PER DRAWINGS E-2.
- (16) INSTALL CITY PROVIDED MOTOR CONTROL CENTER AND PLC/SCADA PER DRAWINGS E-2.
- (17) CONSTRUCT 12-INCH D.I. CLASS 54 BELOW GRADE PUMP DISCHARGE PIPING PER DRAWINGS C-3 AND M-2.
- (22) JOIN (E) 10" STEEL PIPE (2 PLACES) PER DETAIL 6, DRAWING C-2. RELOCATE BY CONSTRUCTING 10" CL. 350 DUCTILE IRON PIPE, DOUBLE WRAPPED IN 8-MIL POLYETHYLENE, PER PLAN. REMOVE ALL (E) PIPE BETWEEN CUTS. MAINTAIN 30" MIN. COVER. COORDINATE WITH HOME GARDENS COUNTY WATER DISTRICT DURING TIE-IN.

1" SERVICE FROM PROPOSED METER.
SEE DWG C-3 FOR LOCATION.

NOTE: INSTALL 1-INCH BALL VALVE AND
END CAP DOWN STREAM OF HOSE BIB FOR
FUTURE CONNECTION TO WELL 32 PIPING

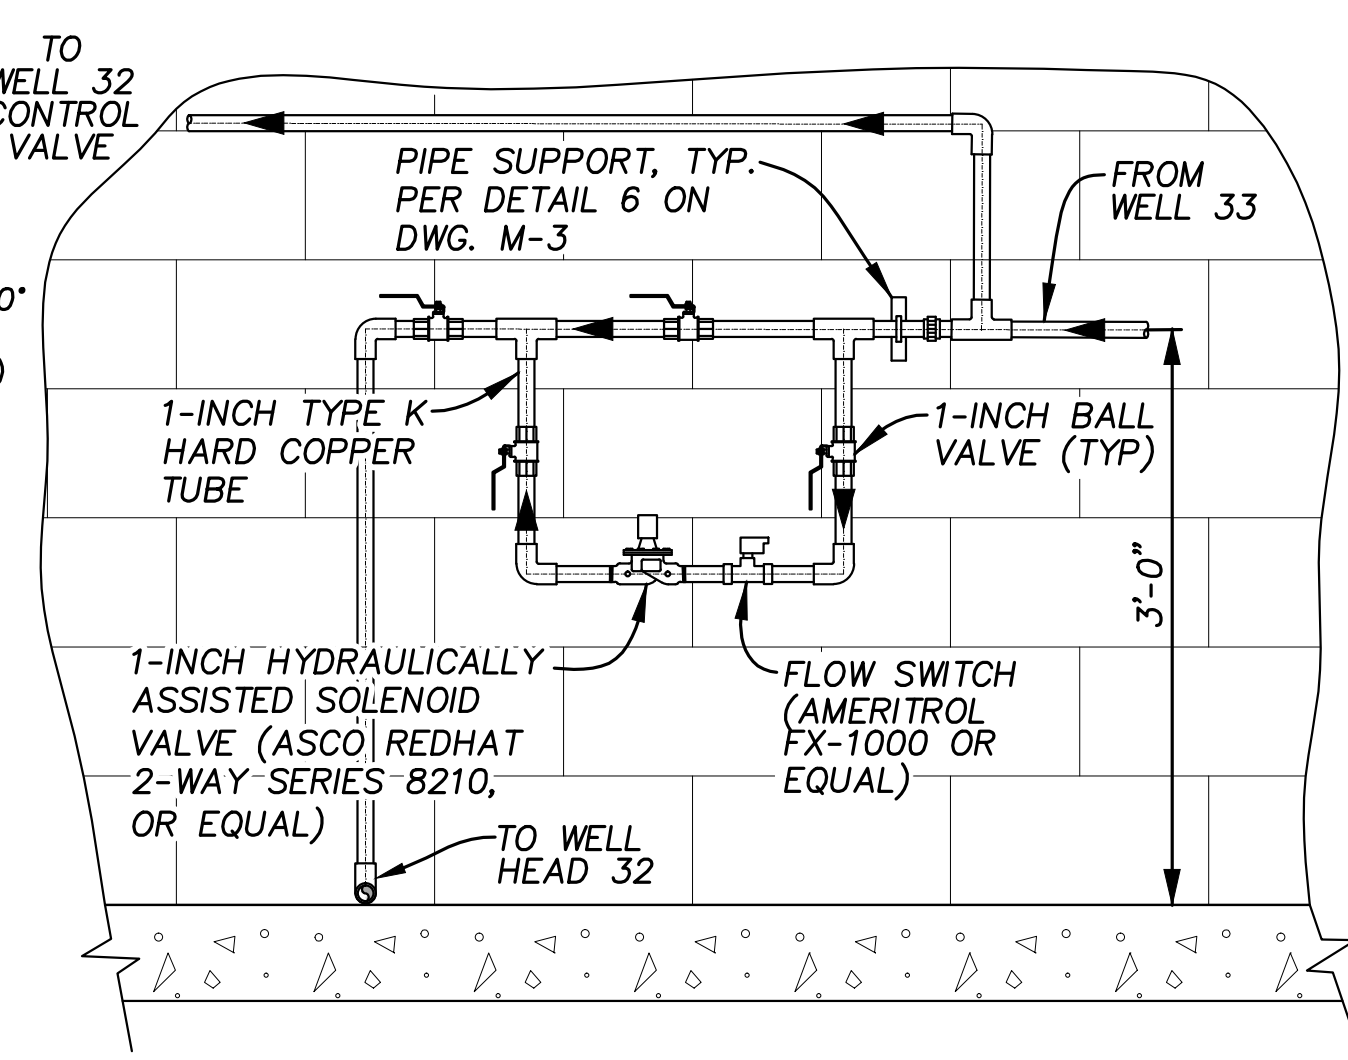

WELL 32
(FUTURE PIPING)

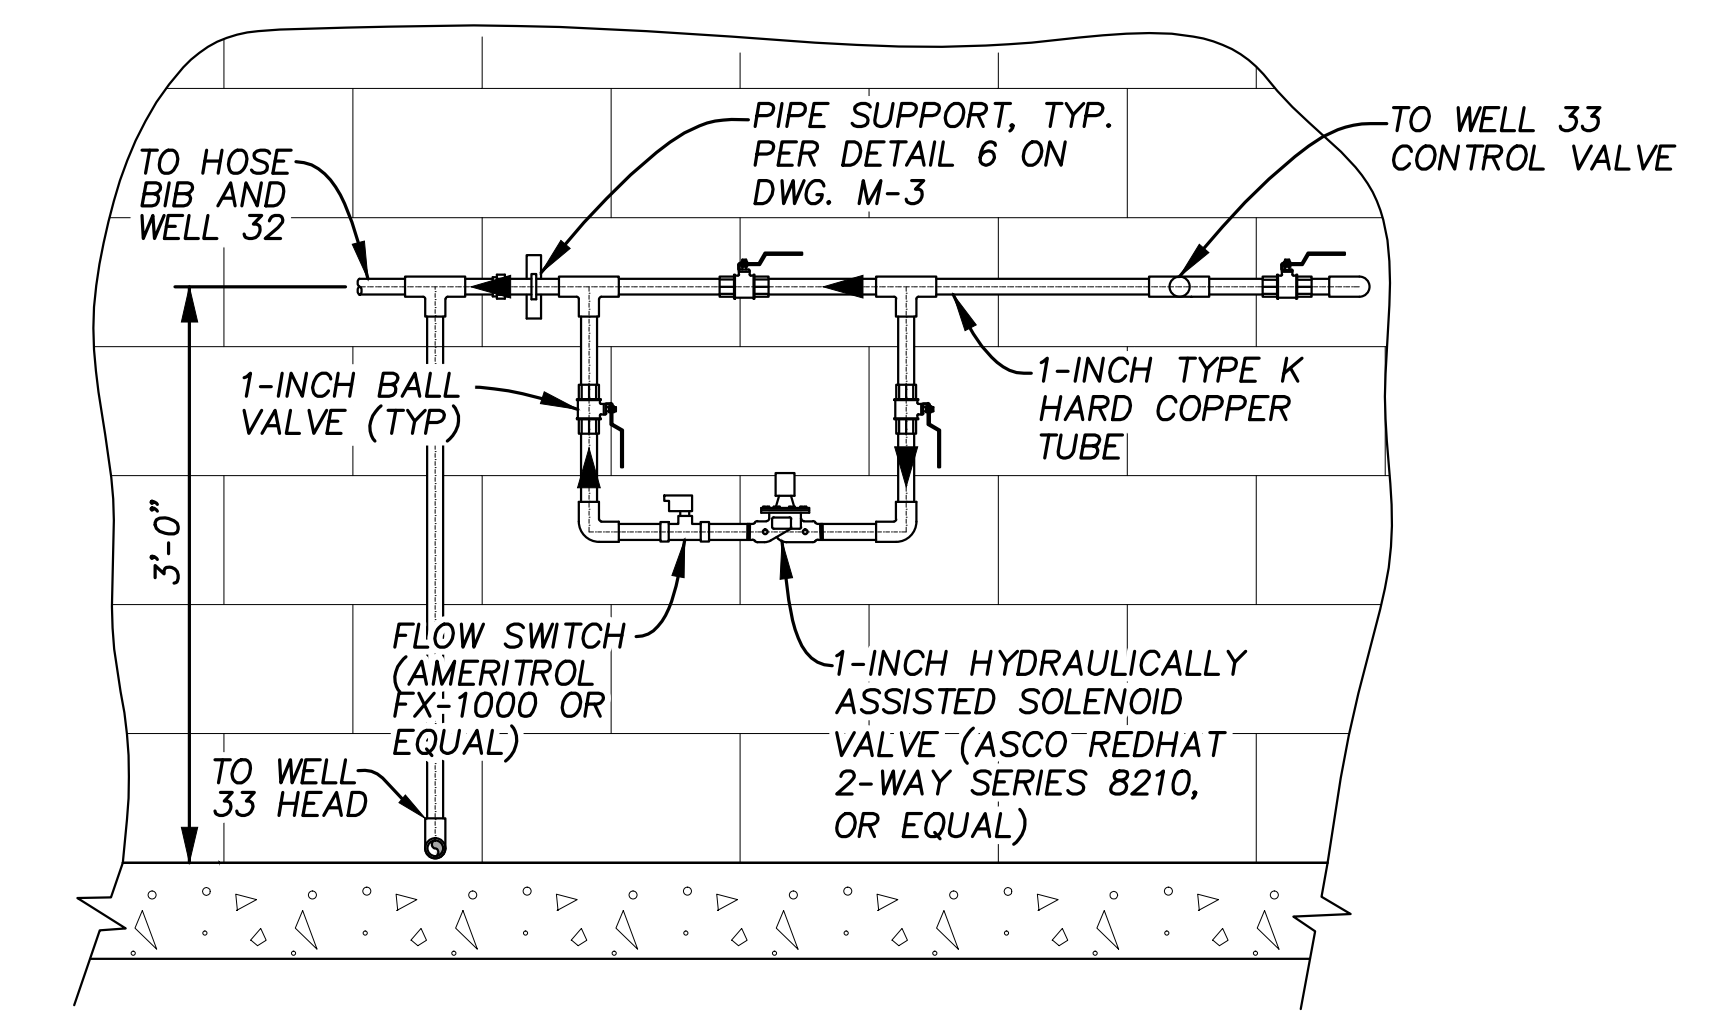


WELL 33

WELL 32 AND WELL 33 PRE-LUBE SYSTEM DETAIL 1
SCALE: 3/8" = 1'-0"

SHEET NOTES:


1. ALL PIPING BELOW GRADE SHALL BE DOUBLE WRAPPED WITH 8-MIL POLYETHYLENE SLEEVE.
2. HOSE BIB SHALL BE FURNISHED W/ VACUUM BREAKER.
3. SEE DRAWING M-2 FOR LIST OR MATERIALS NOT CALLED OUT HEREON.
4. ALL BELOW GRADE DUCTILE IRON PIPING, FITTINGS, VALVES, ETC. UNLESS OTHERWISE INDICATED OR SHOWN SHALL HAVE RESTRAINED MECHANICAL JOINTS ("MEGA-LUG" TYPE OR EQUAL FOR FITTING CONNECTIONS AND LOCKING STYLE GASKETS FOR PIPE CONNECTIONS), AND DOUBLE-WRAP IN BLUE COLORED 8-MIL POLYETHYLENE SLEEVE.
5. PIPING SHOWN AS SCREENED (WELL 32) SHALL BE INSTALLED IN THE FUTURE AND IS FOR REFERENCE ONLY.

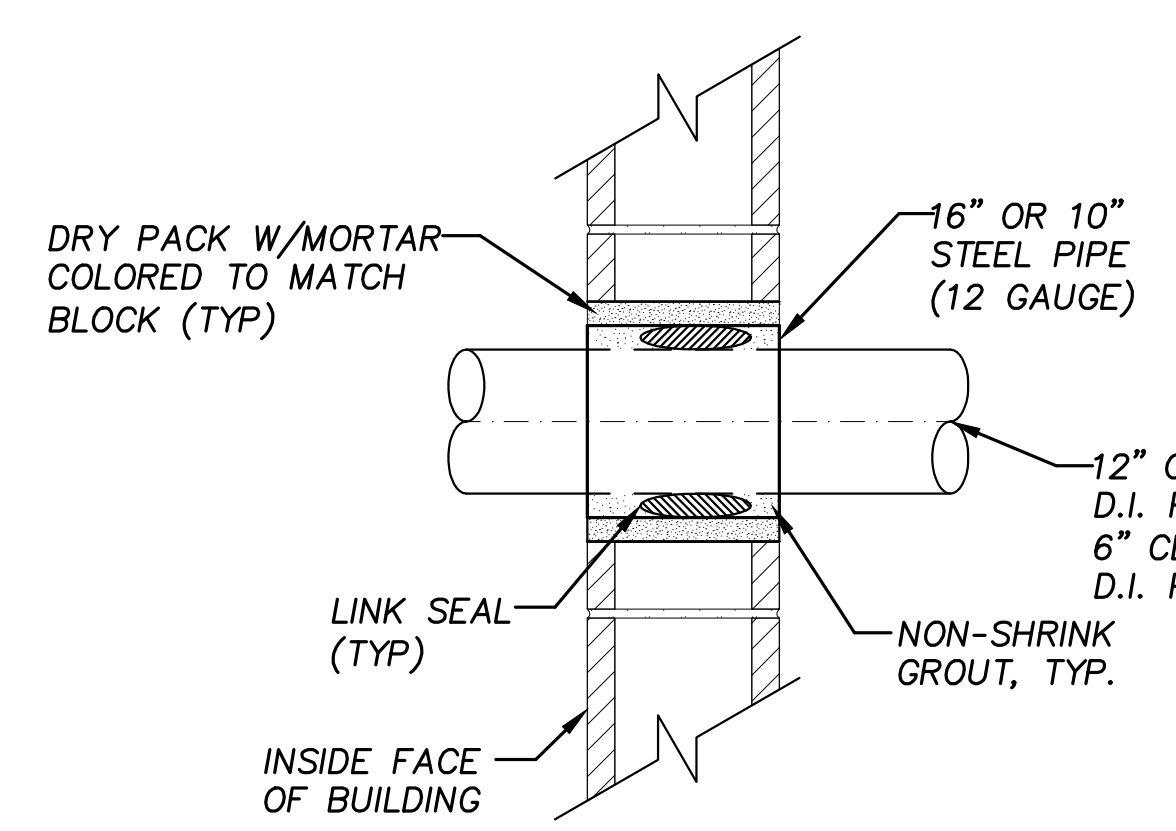

NOTE:

1. CONTRACTOR SHALL USE 16" CASING FOR 12" DISCHARGE LINE AND 10" CASING FOR 6" PUMP TO WASTE LINE.

MASONRY WALL PENETRATION 2
NOT TO SCALE

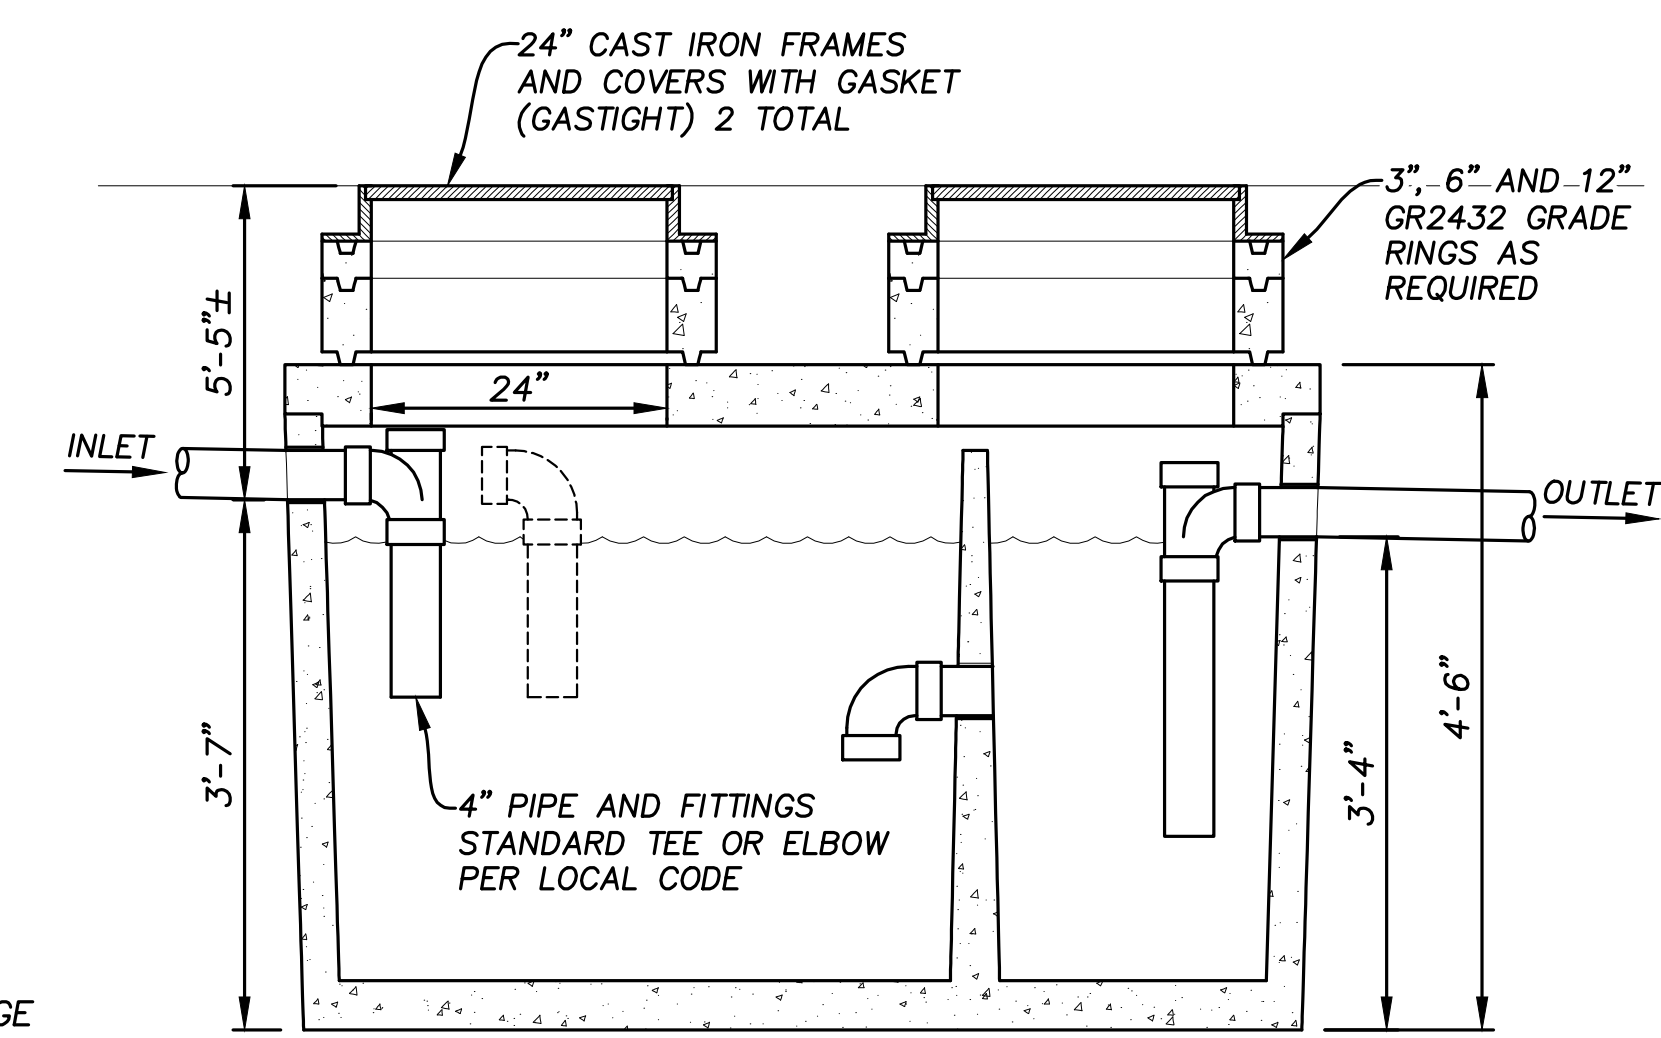


SAND-OIL INTERCEPTOR 3
NOT TO SCALE

AKM JOB No. 0761209.00

Underground Service Alert
Call: TOLL FREE

811

TWO WORKING DAYS BEFORE YOU DIG

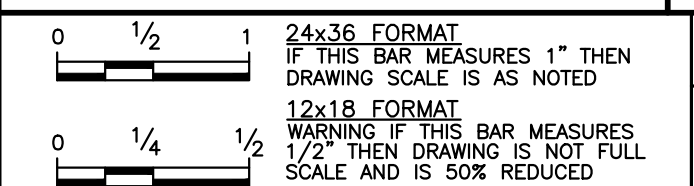

Designed by D. BAKER	Drawn by M.U. R.U.	Checked by G. HOBSON
PLANS PREPARED UNDER SUPERVISION OF GARY J. HOBSON R.C.E. No. 40779		
Date JULY 2017		

Reference Plans for these Improvements	Date	By	REVISIONS	App'd


AKM AKM CONSULTING ENGINEERS
553 WALD IRVINE, CA. 92618
(949) 753-7333

Engineering _____
Operations _____

Department of Water and Power Approval
By: _____ 8/4/2017
Vernon R. Weisman, P.E.
District Engineer
R.C.E. No. 41610


CITY OF CORONA - RESIN TREATMENT OF NITRATE SOURCES	Drawing No. 13-038U
WELLS 32 AND 33 EQUIPPING WELL PUMP MECHANICAL PLAN	M-1
	Sht. 6 of 21



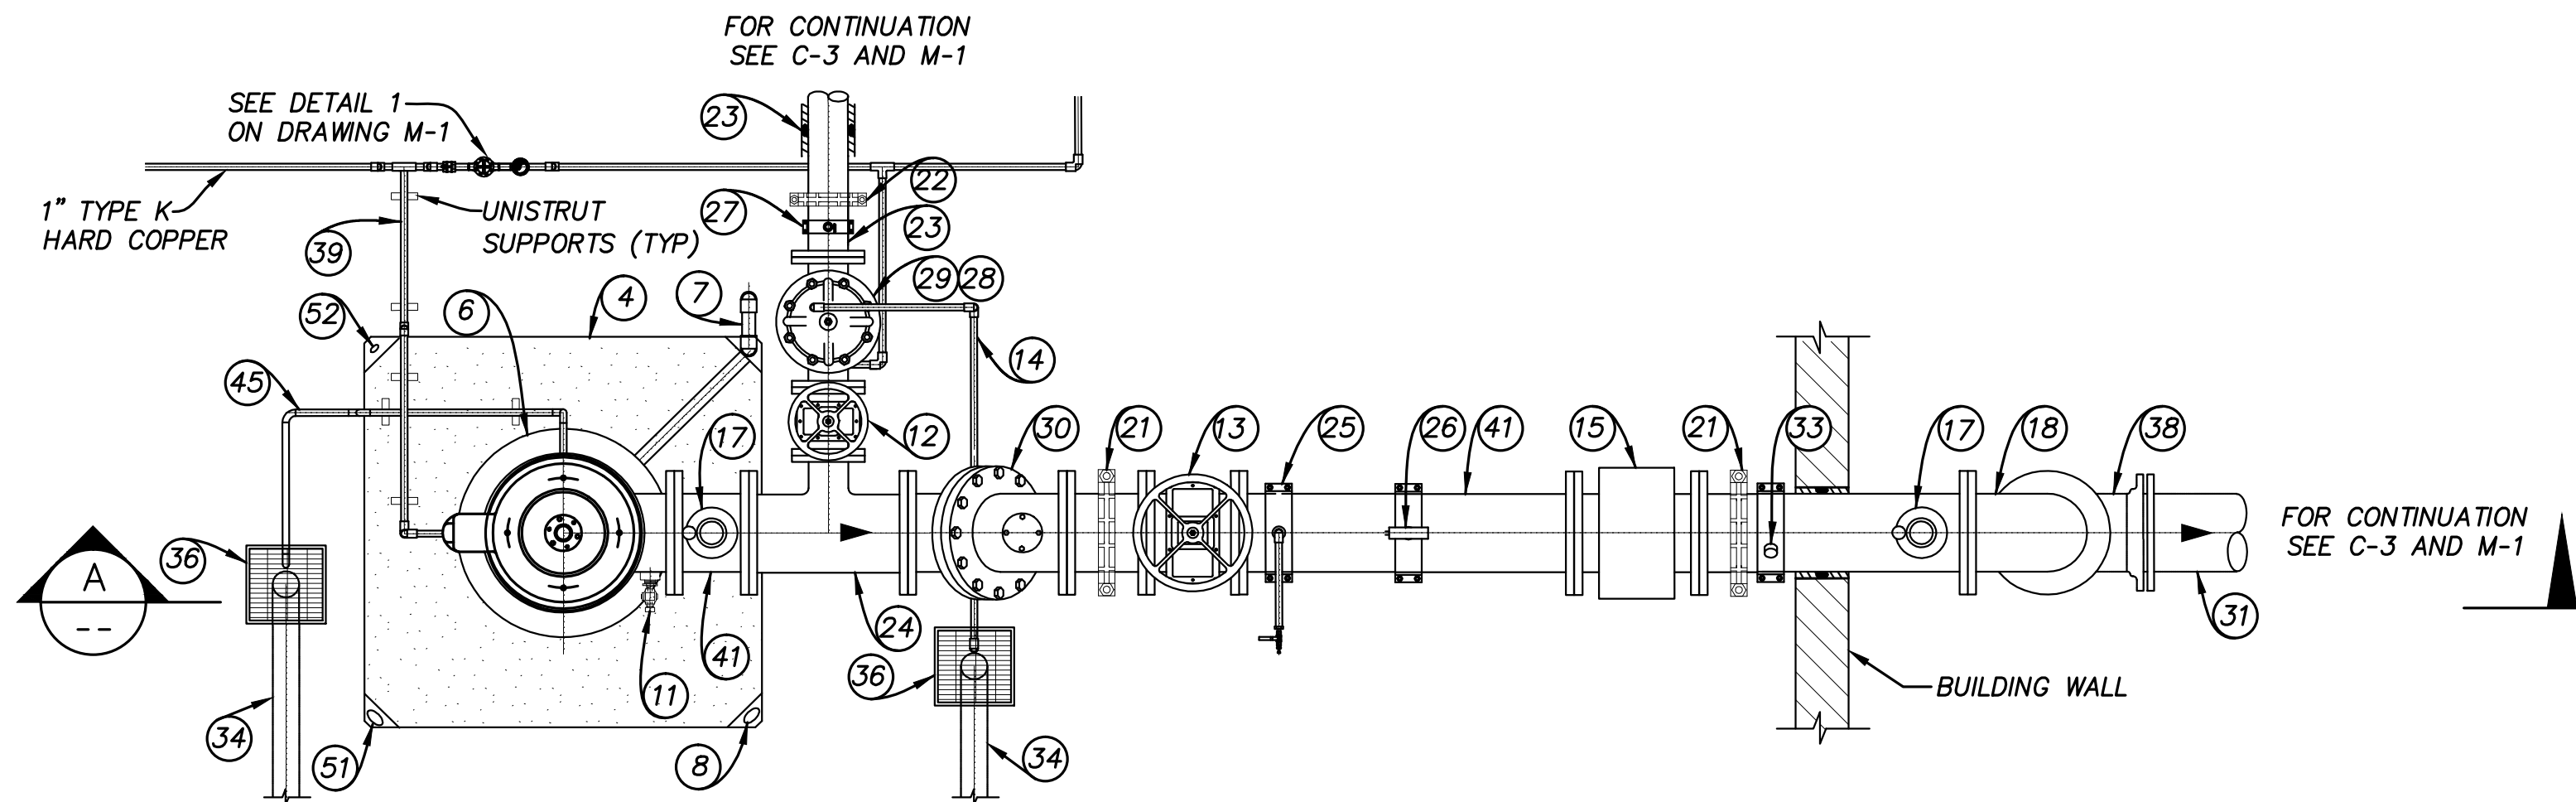


TYPICAL DISCHARGE PIPING
PLAN FOR WELL 33

SCALE: 1/2" = 1'-0"

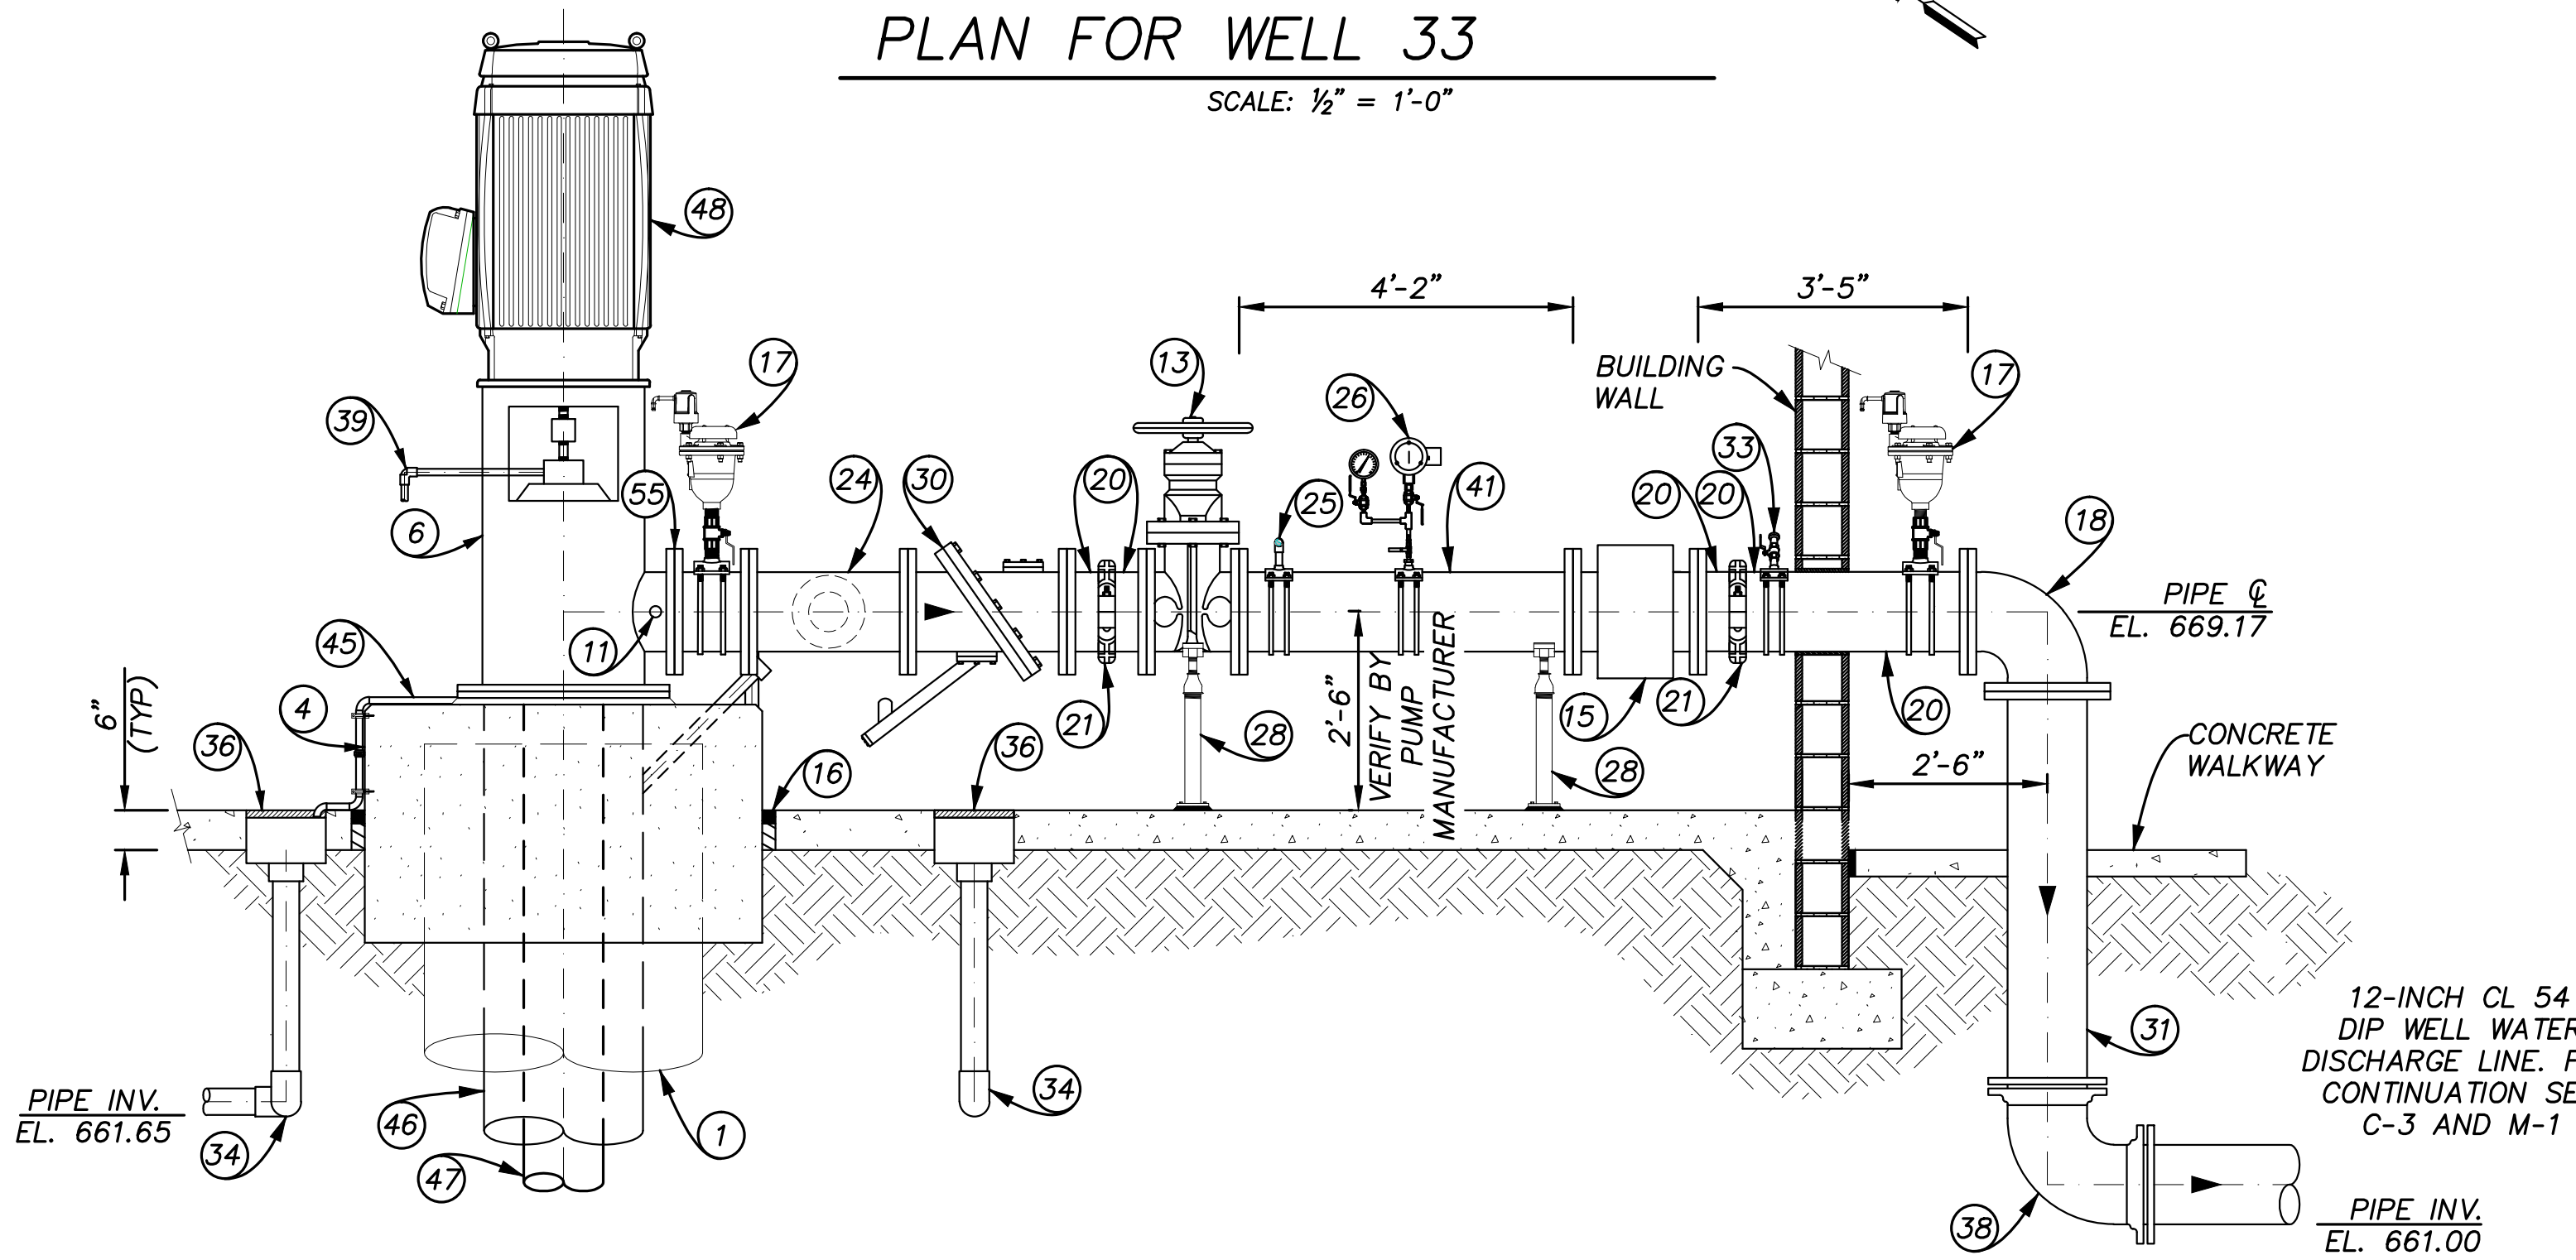


WELL PUMP 33 MECHANICAL SECTION (A)

SCALE: 1/2" = 1'-0"

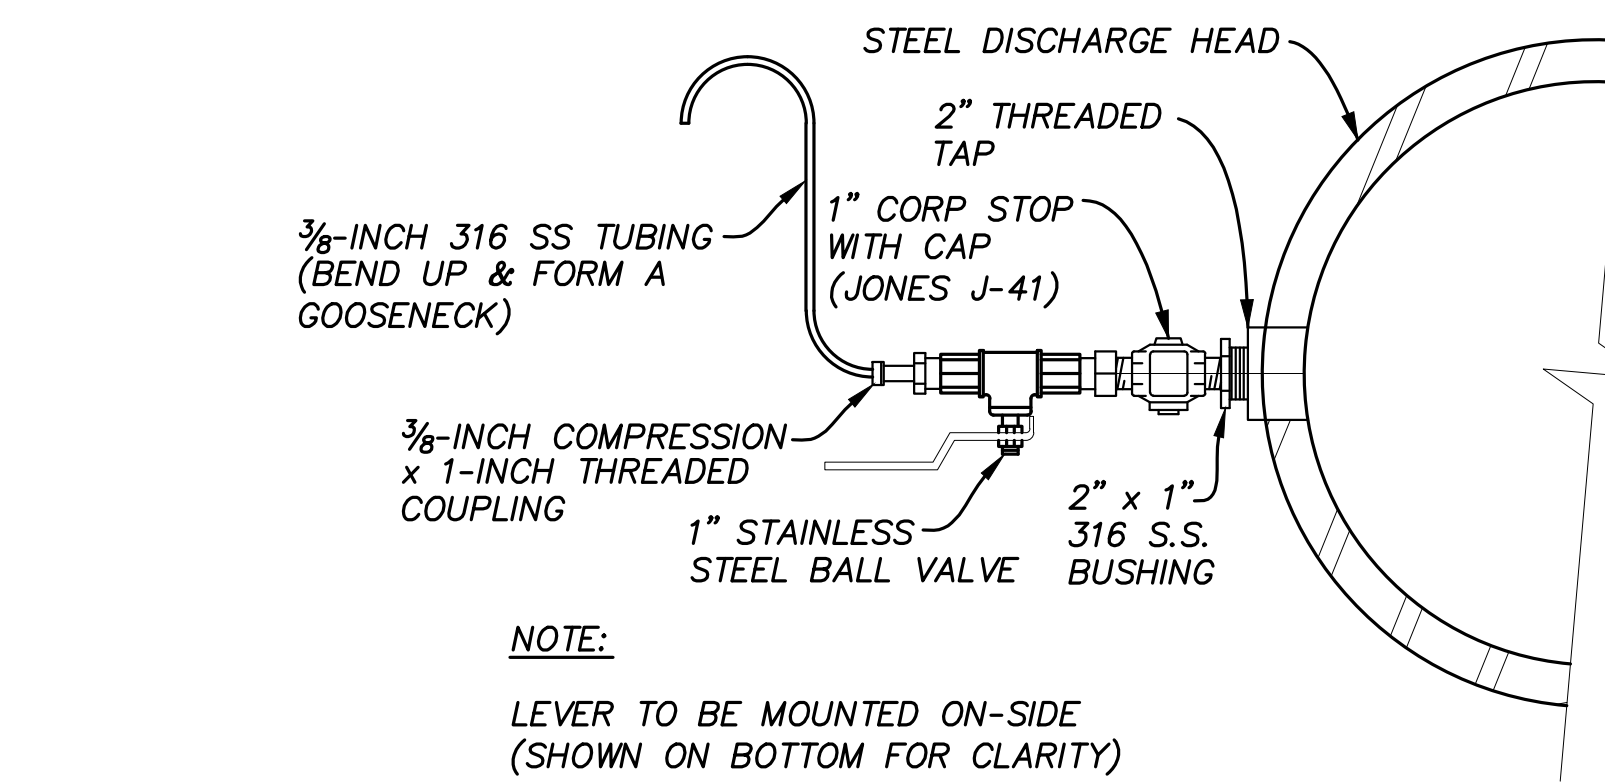


1-INCH TAP DETAIL (1)

NOT TO SCALE

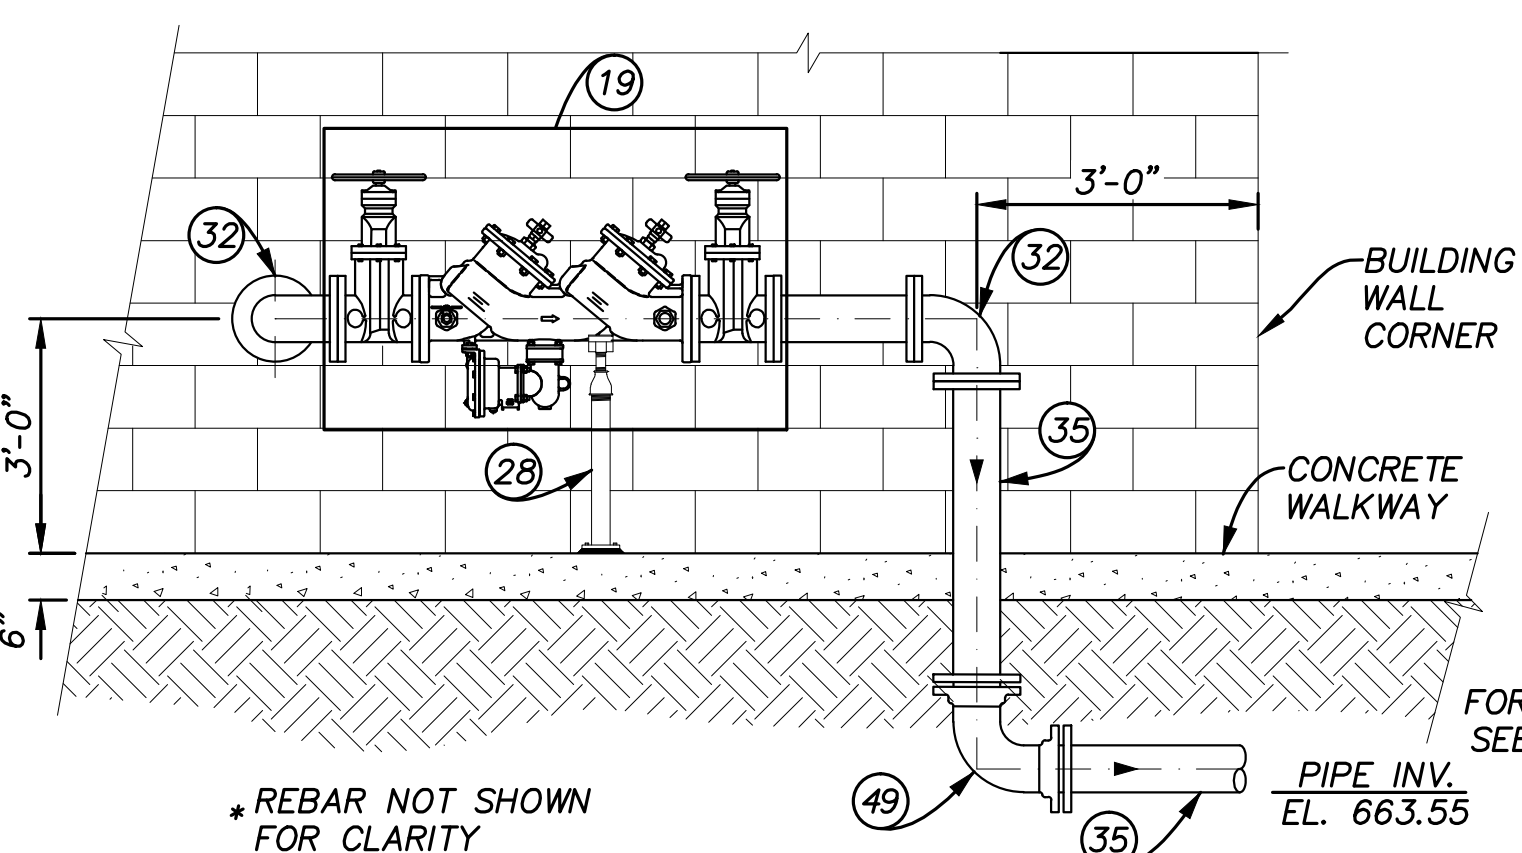


WELL 33 PUMP-TO-WASTE
PIPING SECTION

SCALE: 1/2" = 1'-0"

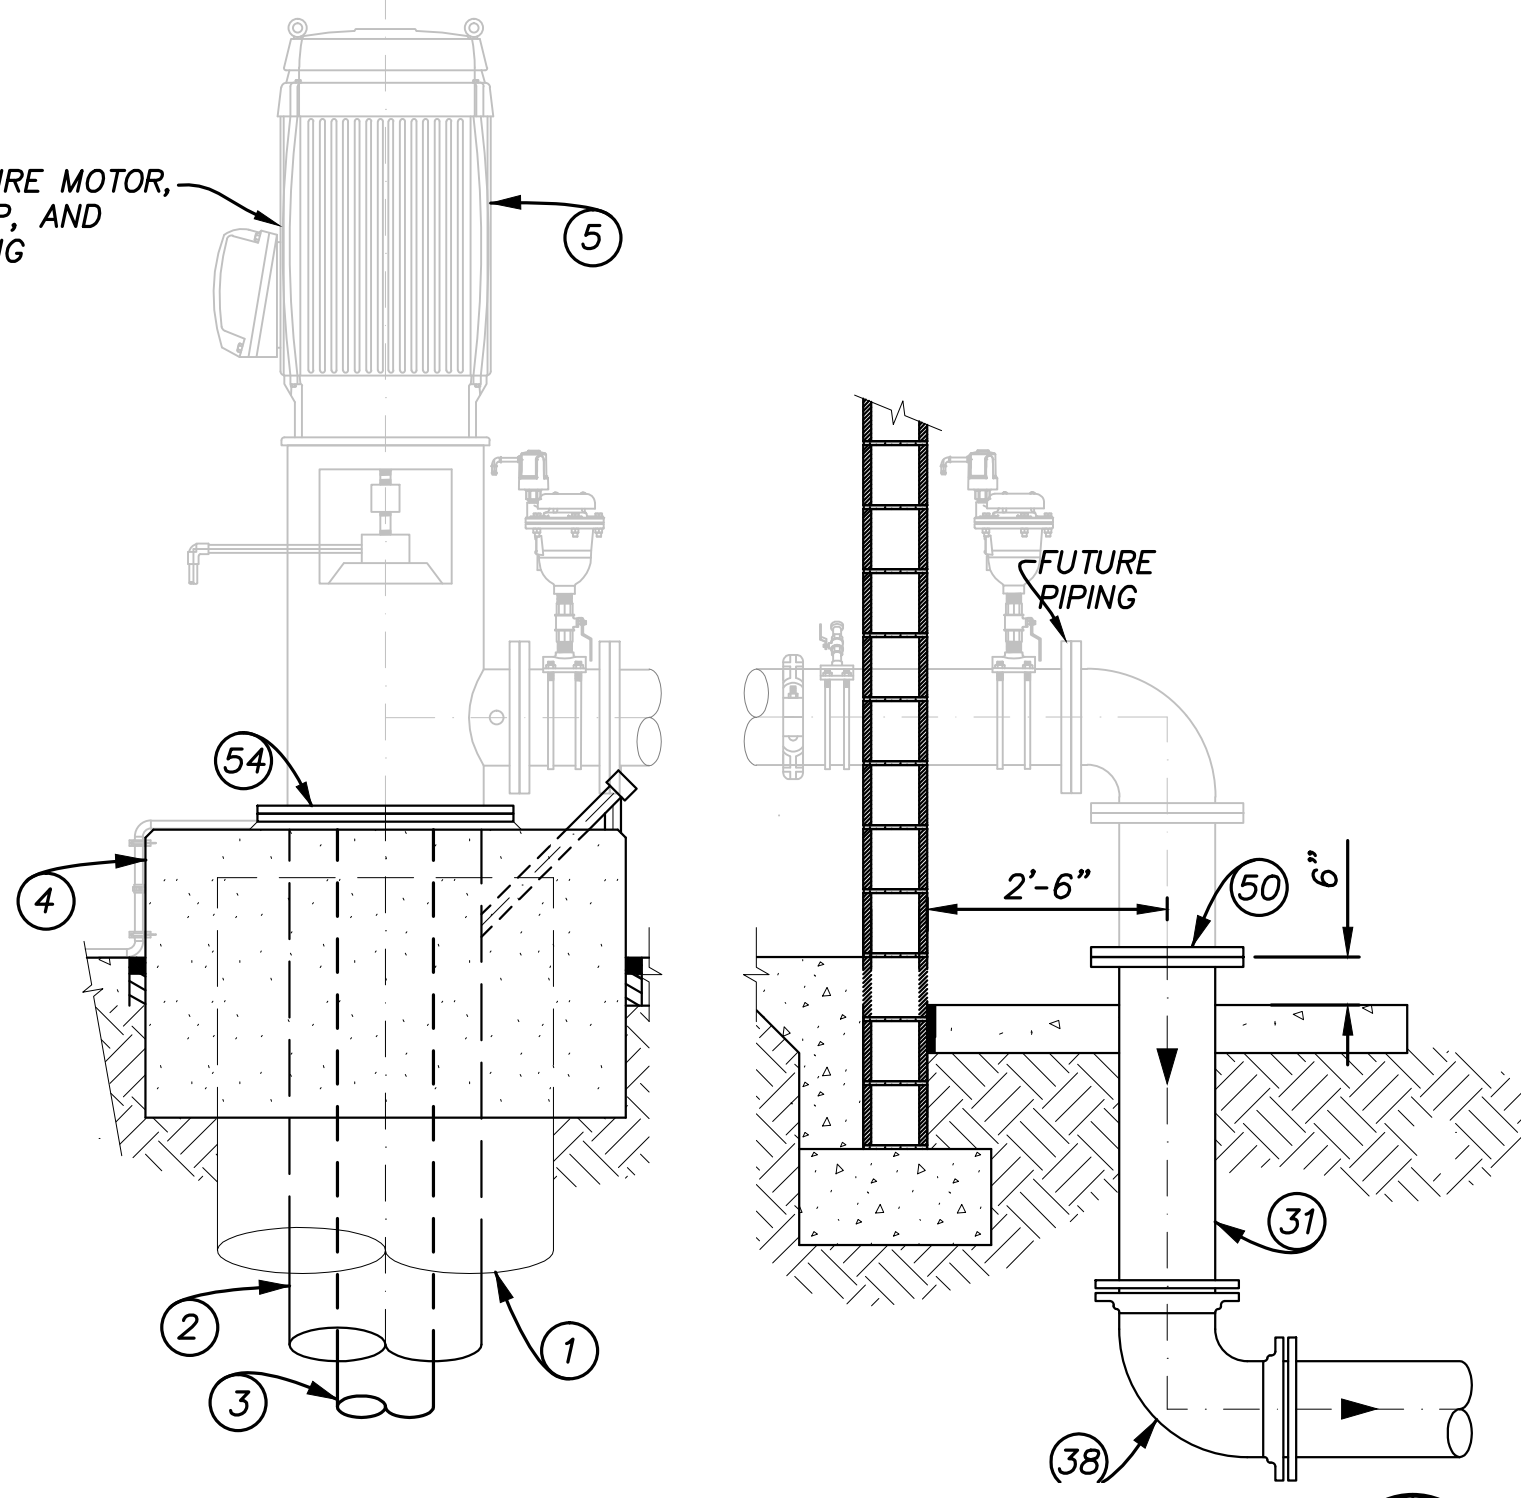

WELL PUMP 32 MECHANICAL SECTION (C)

SCALE: 1/2" = 1'-0"

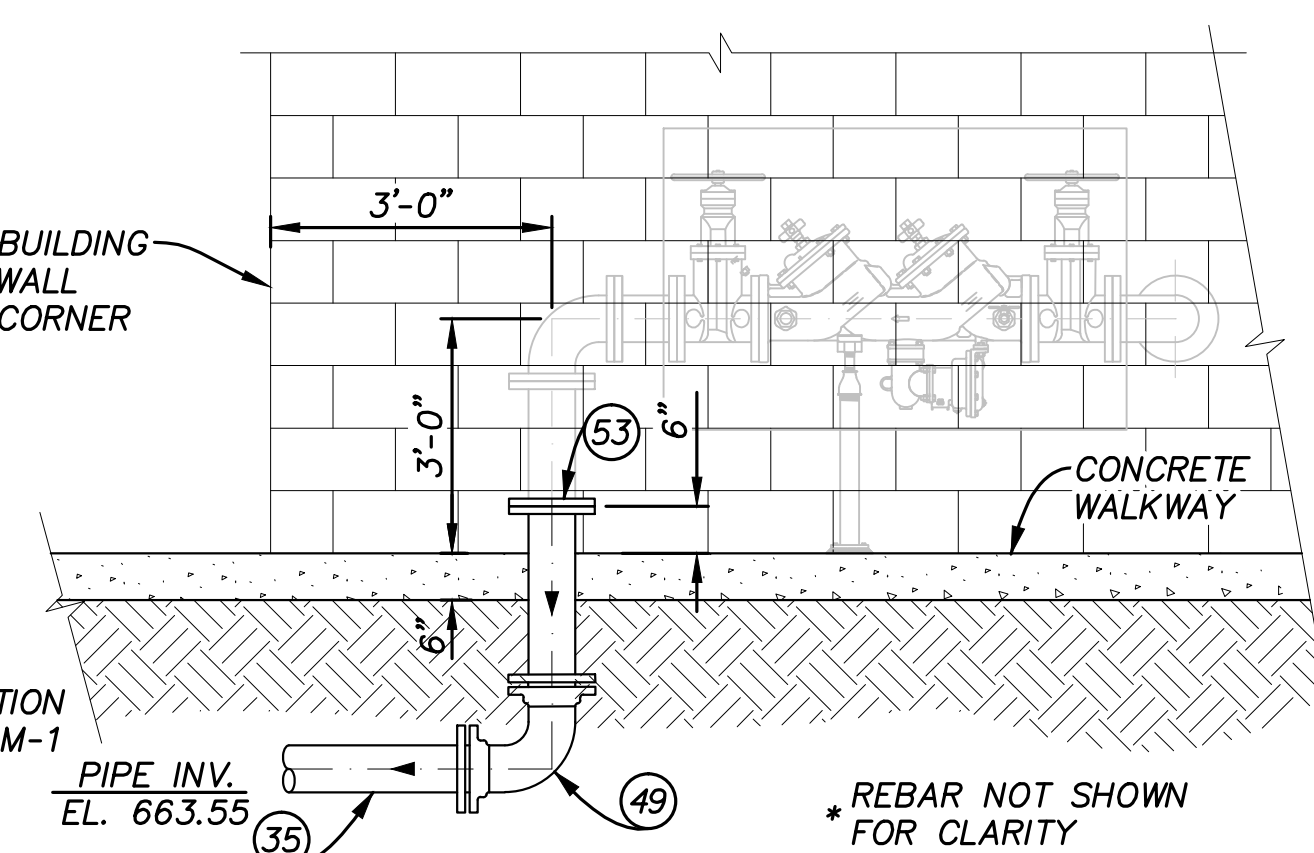

WELL 32 PUMP-TO-WASTE
PIPING SECTION

SCALE: 1/2" = 1'-0"

- SHEET NOTES:
- ALL BELOW GRADE DUCTILE IRON PIPING, FITTINGS, VALVES, ETC. UNLESS OTHERWISE INDICATED OR SHOWN SHALL HAVE RESTRAINED MECHANICAL JOINTS ("MEGA-LUG" TYPE OR EQUAL FOR FITTING CONNECTIONS AND LOCKING STYLE GASKETS FOR PIPE CONNECTIONS), AND DOUBLE-WRAP IN BLUE COLORED 8-MIL POLYETHYLENE SLEEVE.
 - PROVIDE ALL EQUIPMENTS, PIPING, VALVES, AND FITTINGS ACCORDING TO THE CITY'S APPROVED LIST OF MATERIALS.
 - WRAP PVC VENT TERMINALS WITH 316 S.S. INSECT SCREEN AND 316 S.S. HOSE CLAMPS.
 - ROUTE 1-INCH 316 S.S. TUBING TO A POINT 6-INCH ABOVE FLOOR DRAIN. SEE DETAIL 6 ON DRAWING M-3 FOR PIPE SUPPORT.
 - INSTALL LEVEL TRANSDUCER, BREATHER BOX AND APPURTENANCES AS PER MANUFACTURER'S RECOMMENDATIONS.
 - PITOT TEST CONNECTION SHALL BE INSTALLED IN 45 DEGREE ANGLE.
 - PIPING SHOWN AS SCREENED (WELL 32) SHALL BE INSTALLED IN THE FUTURE AND IS FOR REFERENCE ONLY.

LIST OF MATERIALS		SIZE	QTY
1	CONDUCTOR CASING (INSTALLED BY OTHERS CUT TO LENGTH)	34"	-
2	WELL 32 CASING (INSTALLED BY OTHERS CUT TO LENGTH)	16"	-
3	FUTURE WELL 32 PUMP, COLUMN AND SHAFTING (SEE SPECS FOR MFG., MODEL, STAGES). PROVIDE 8" COLUMN PIPE (SS 316L), AND SET PUMP INTAKE AT 248' AMSL.	200 GPM @ 588-FT	N.I.C.
4	WELLS PUMP BLOCK PER DETAIL 1 ON M-3	-	2
5	FUTURE WELL 32 TEFC INVERTER DUTY MOTOR	60 HP	N.I.C.
6	FABRICATED STEEL DISCHARGE HEAD	PER PUMP SUPPLIER	1
7	316 S.S. SCH 40 THREADED PIPE CASING VENT. PER DETAIL 5, DWG M-3	2"	2
8	THREADED CAP & VIATRAN LEVEL TRANSDUCER	2"	2
11	SAMPLE TAP PER DETAIL 1	-	1
12	RESILIENT WEDGE GATE VALVE WITH HAND WHEEL	6"	1
13	RESILIENT WEDGE GATE VALVE WITH HAND WHEEL	12"	1
14	316 S.S. TUBING FROM CONTROL VALVE PER SHEET NOTE 4	3/4"	AS REQD
15	MAGNETIC FLOW METER W/ GROUNDING RINGS (SEE E-6)	12"	1
16	EXPANSION JOINT & NSF 61 SEALANT	1/2"	AS REQD
17	WELL SERVICE AIR/VAC A.R.I. MODEL D-060-C-HFNS	2"	2
18	DUCTILE IRON 90° ELBOW (FLG x FLG)	12"	1
19	REDUCED PRESSURE PRINCIPAL BACKFLOW PREVENTER DEVICE W/ NRS GATE VALVES AND STRAINER, FEBCO LF860	6"	1
20	THICKNESS CL 54 DUCTILE IRON SPOOL (FLG x GROOVE)	12"	AS REQD
21	STYLE 31 VICTAULIC COUPLING	12"	2
22	STYLE 31 VICTAULIC COUPLING	6"	1
23	THICKNESS CL 54 DUCTILE IRON PIPE SPOOL (FLG x GROOVE)	6"	AS REQD
24	DUCTILE IRON REDUCING TEE	12" x 6"	1
25	DOUBLE STRAP SADDLE TAP W/1" S.S. BALL VALVE AND 316 S.S. PIPE ROUTED TO CONTROL VALVE	1"	1
26	PRESSURE TRANSMITTER AND GAUGE ASSEMBLY PER DETAIL 3 ON M-3	-	1
27	DOUBLE STRAP SADDLE TAP W/ NIPPLE, BALL VALVE, AND PLUG	1"	1
28	ADJUSTABLE PIPE SUPPORT PER CITY OF CORONA STD. DWG. 418	-	4
29	CLA-VAL DEEP WELL PUMP CONTROL VALVE, EPOXY COATED INSIDE & OUT W/ X101C VALVE POSITION INDICATOR, AND 316 S.S. TRIM & TUBING	6"	1
30	SLANTING DISC BOTTOM MOUNTED DASHPOT CHECK VALVE W/ LIMIT SWITCH (APCO SERIES 800T W/ SIGNAL SWITCH)	12"	1
31	THICKNESS CL 54 DUCTILE IRON PIPE SPOOL (FLG x PE)	12"	AS REQD
32	DUCTILE IRON 90° ELBOW (FLG x FLG)	6"	2
33	DOUBLE STRAP BRONZE SADDLE W/ NIPPLE, BALL VALVE, AND PLUG FOR PITOT TEST. SEE SHEET NOTE 6.	2"	1
34	SDR 35 PVC PIPE AND FITTINGS	4"	AS REQD
35	DUCTILE IRON CL350 PIPE AND FITTINGS	6"	AS REQD
36	FLOOR SINK (ZURN Z-190T WITH S.S. FRAME, 3/4" S.S. GRATE AND SEDIMENT BUCKET, OR EQUAL)	12" x 12" x 8"	4
38	DUCTILE IRON 90° ELBOW (MJ x MJ)	12"	2
39	PRE-LUBE LINE (TYPE K HARD COPPER)	1"	AS REQD
41	THICKNESS CL 54 DUCTILE IRON PIPE SPOOL (FLG x FLG)	12"	AS REQD
44	NOT USED	-	-
45	316 S.S. SWAGE LOCK TUBING AND FITTINGS	1"	AS REQD
46	WELL 33 CASING (INSTALLED BY OTHERS CUT TO LENGTH)	16"	-
47	WELL 33 PUMP, COLUMN AND SHAFTING (SEE SPECS FOR MFG., MODEL, STAGES). PROVIDE 10" COLUMN PIPE (SS 316L), AND SET PUMP INTAKE AT 410' AMSL.	1500 GPM @ 438-FT	1
48	WELL 33 TEFC INVERTER DUTY MOTOR	250 HP	1
49	DUCTILE IRON 90° ELBOW (MJ x MJ)	6"	2
50	DUCTILE IRON BLIND FLANGE	12"	1
51	GRAVEL FEED LINE	3"	-
52	SOUNDING TUBE	1"	-
53	DUCTILE IRON BLIND FLANGE	6"	1
54	DUCTILE IRON BLIND FLANGE	16"	1
55	INSULATING FLANGE GASKET	12"	1

* N.I.C. = NOT IN CONTRACT

AKM JOB No. 0761209.00

Underground Service Alert
Call: TOLL FREE

811

TWO WORKING DAYS BEFORE YOU DIG


Designed by D. BAKER	Drawn by M.U. R.U.	Checked by G. HOBSON
PLANS PREPARED UNDER SUPERVISION OF GARY J. HOBSON R.C.E. No. 40779		
Date JULY 2017	Reference Plans for these Improvements	

AKM AKM CONSULTING ENGINEERS 553 WALD IRVINE, CA. 92618 (949) 753-7333	Engineering _____ Operations _____	Department of Water and Power Approval By: <i>[Signature]</i> Date: 8/4/2017 Vernon R. Weisman, P.E. District Engineer R.C.E. No. 41610	CITY OF CORONA - RESIN TREATMENT OF NITRATE SOURCES WELLS 32 AND 33 EQUIPPING WELL PUMP MECHANICAL SECTIONS	Drawing No. 13-038U
				M-2 Sht. 7 of 21




NOTE:

LAYOUT BELOW IS SHOWN FOR WELL 33.
TUBING WAS CONSTRUCTED AS
"MIRROR IMAGE" AT WELL 32.

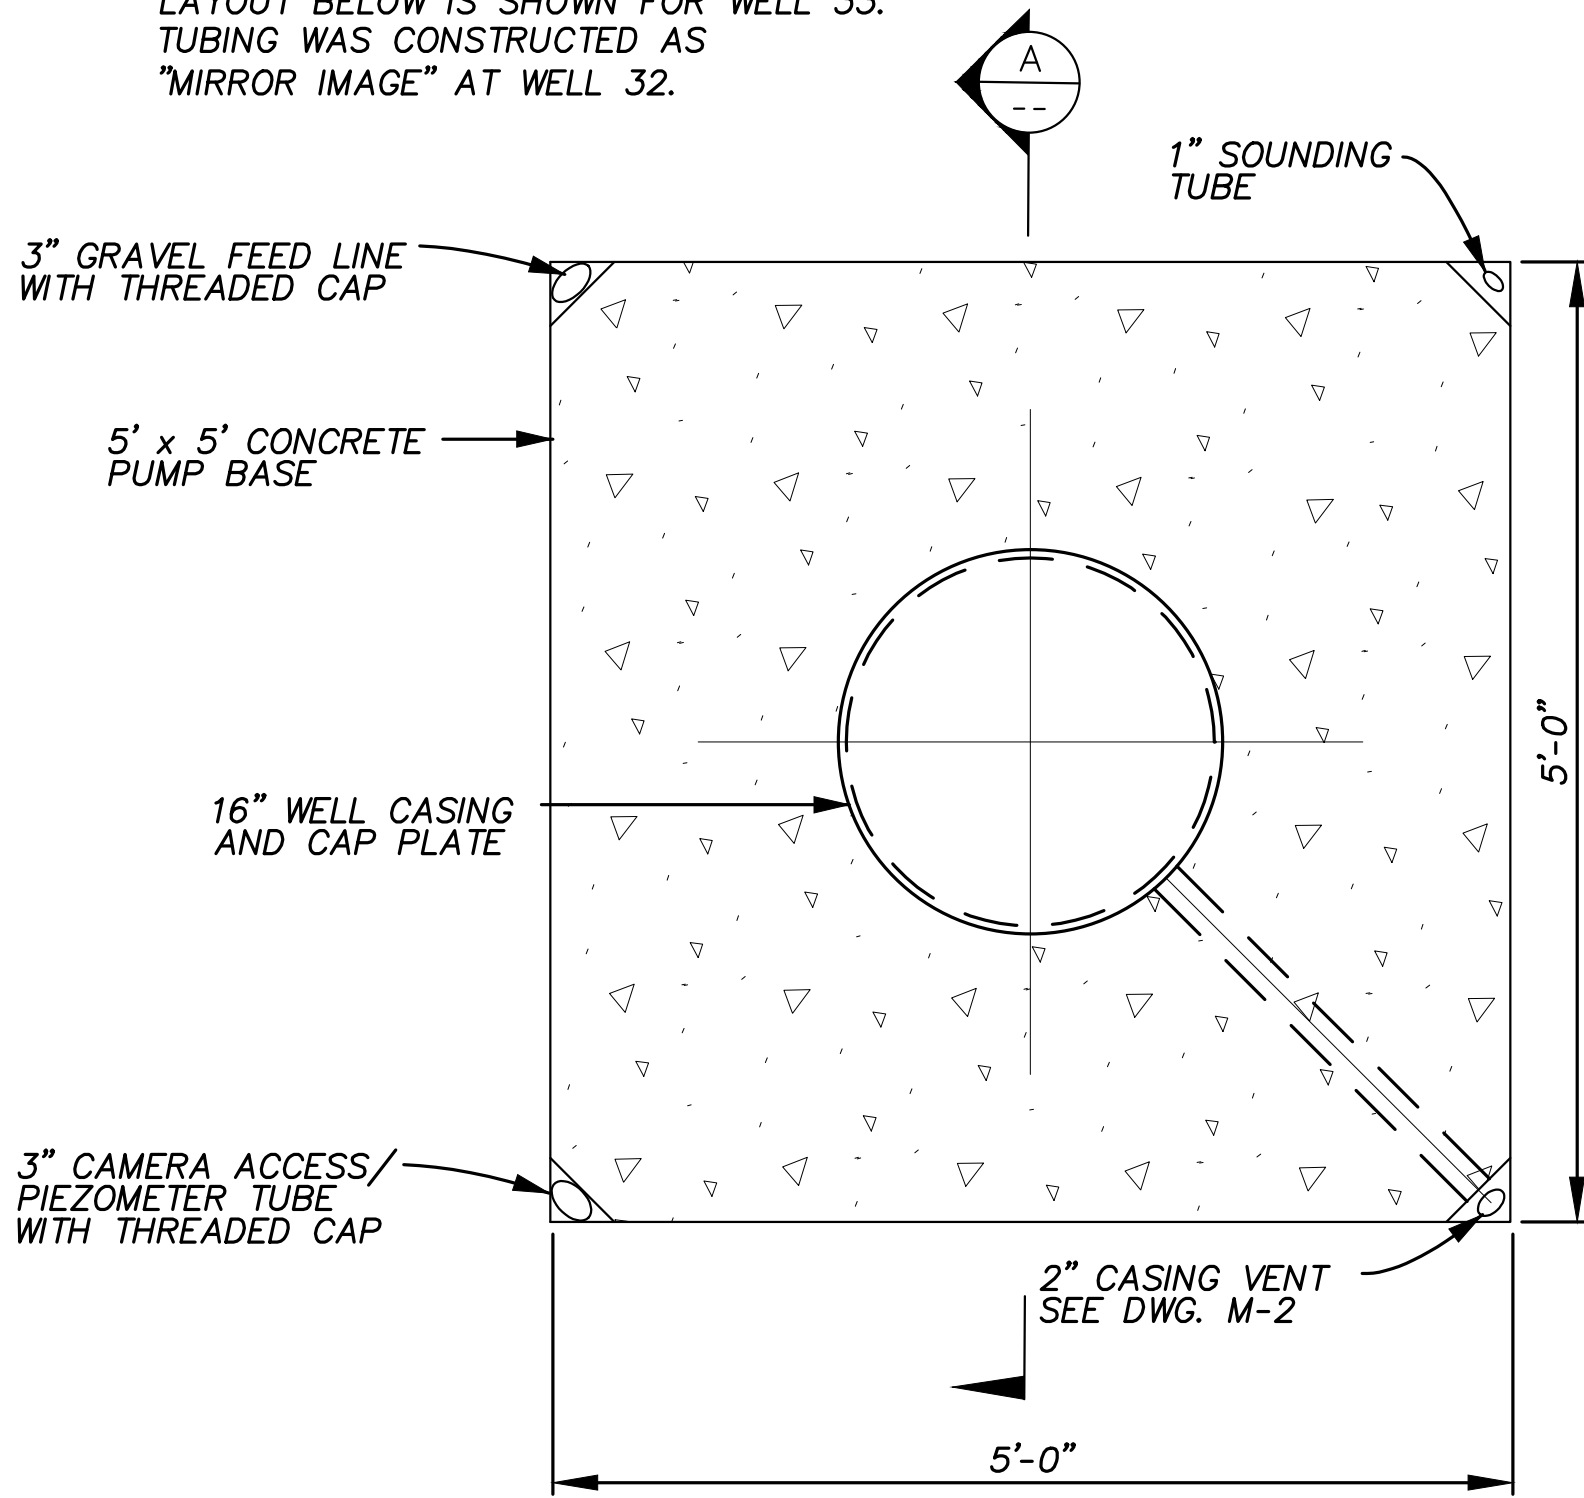

PLAN

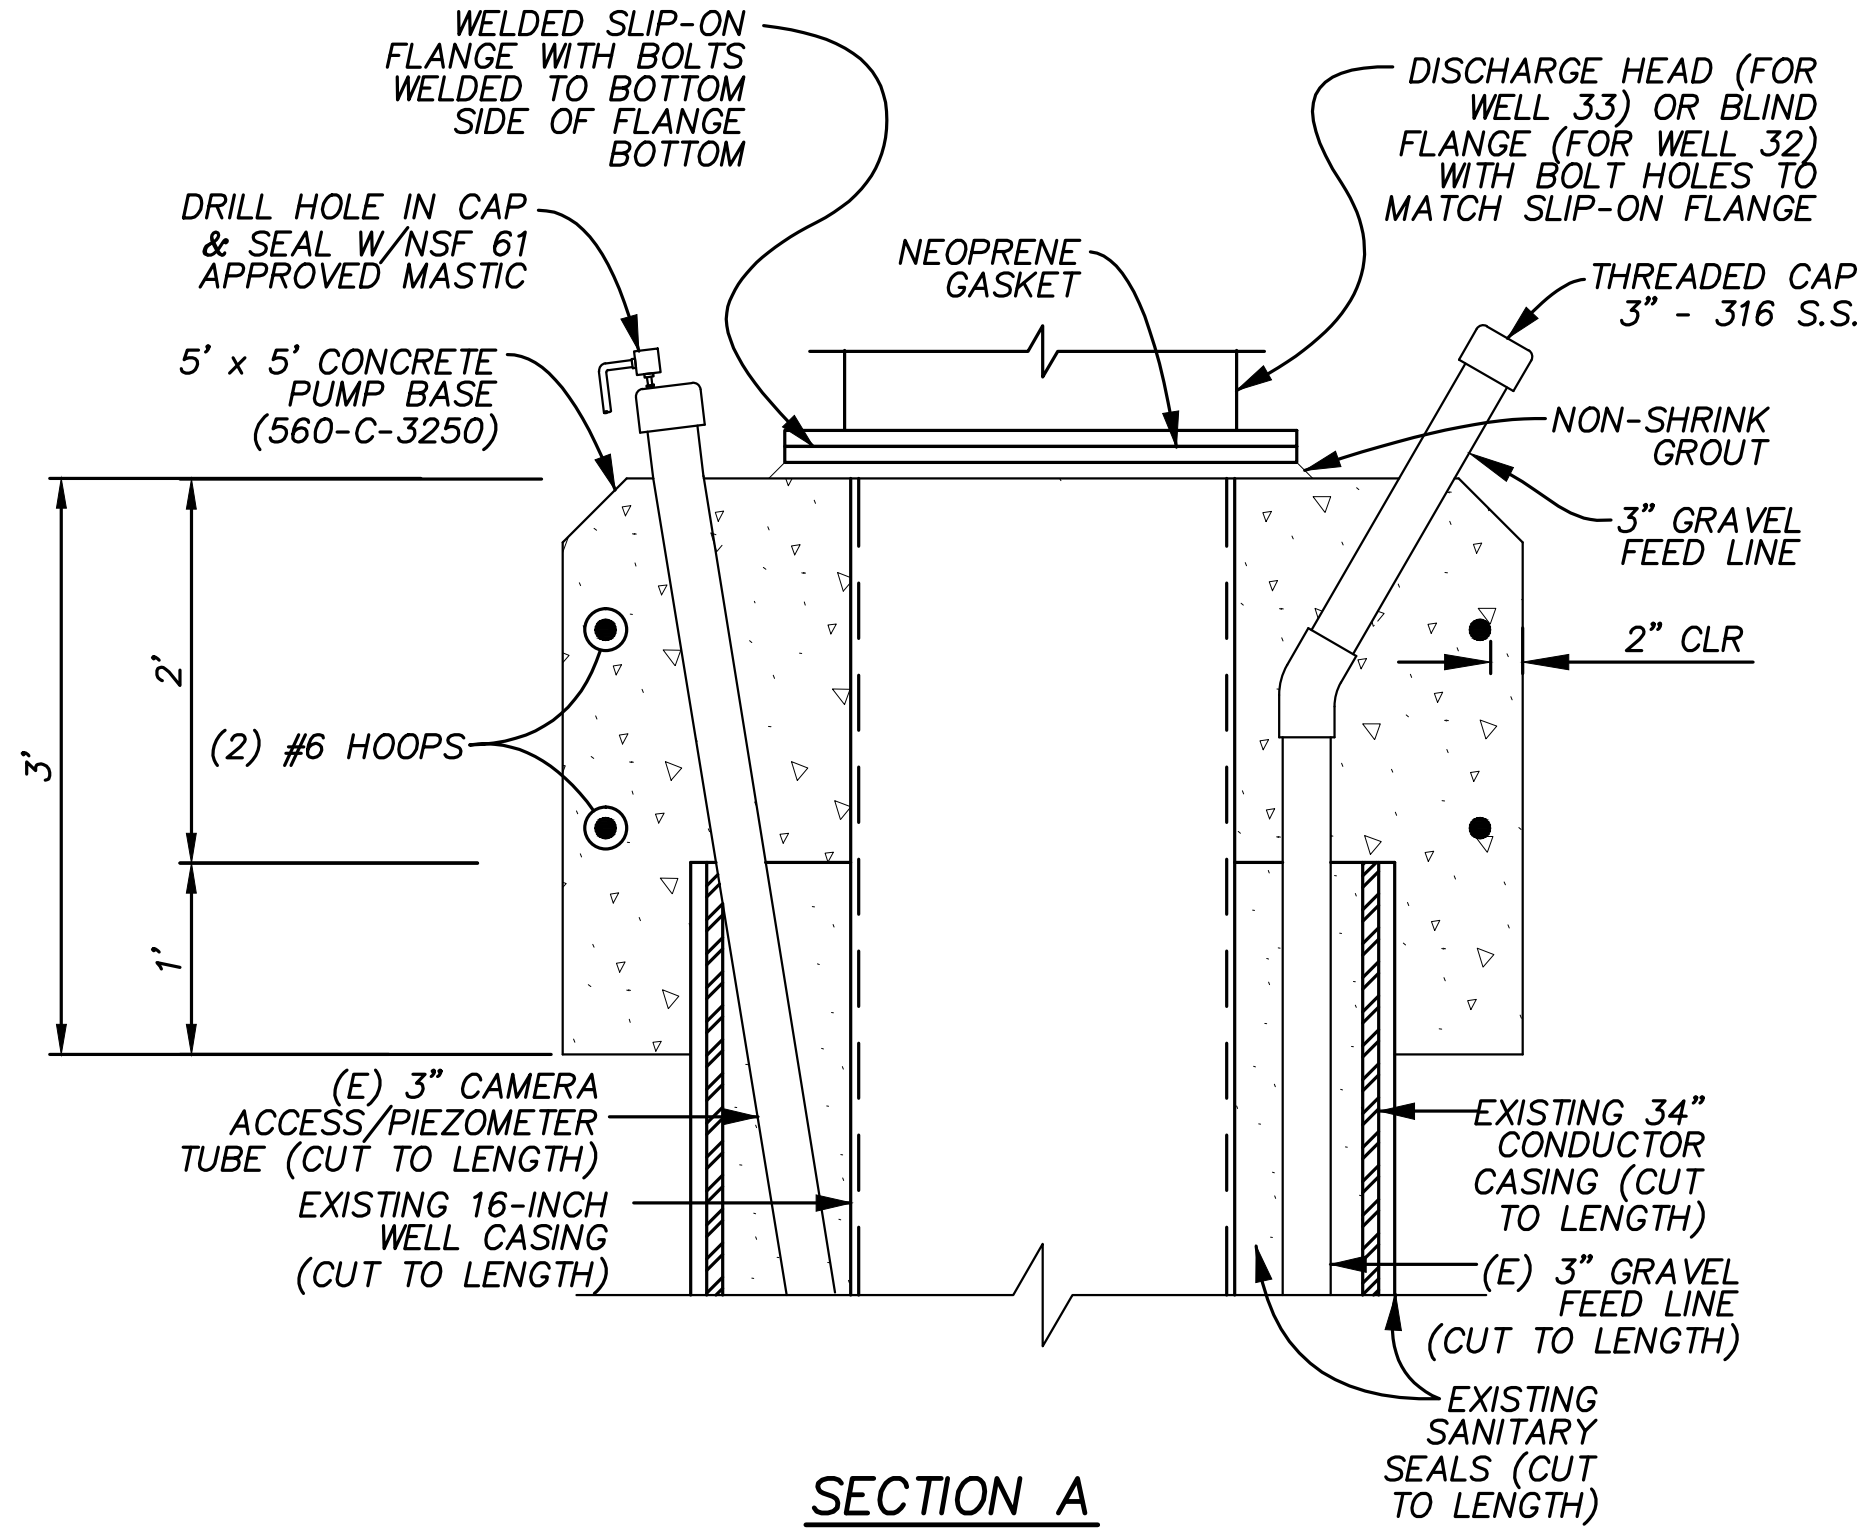

SECTION A


WELL HEAD APPURTENANCES AND FOUNDATION

SCALE: 1" = 1'-0"


1
C-1

NOTE:

CONTRACTOR TO CUT (E)
CONDUCTOR CASING, GRAVEL FILL,
CAMERA ACCESS/PIEZOMETER TUBE,
SOUNDING TUBE, & WELL CASING
TO LENGTH AND EXTEND TO TOP
OF PUMP BASE AS SHOWN.

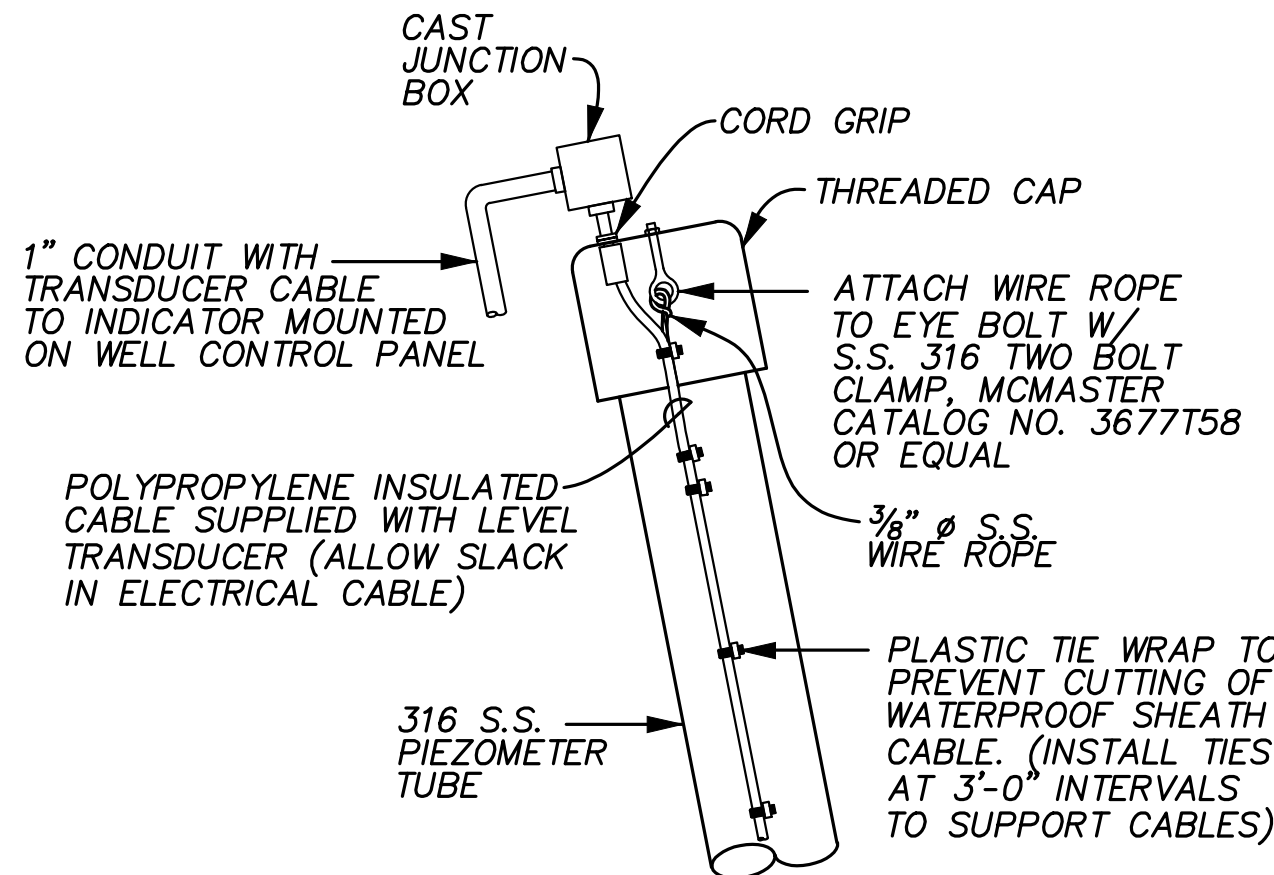

MOUNTING DETAIL

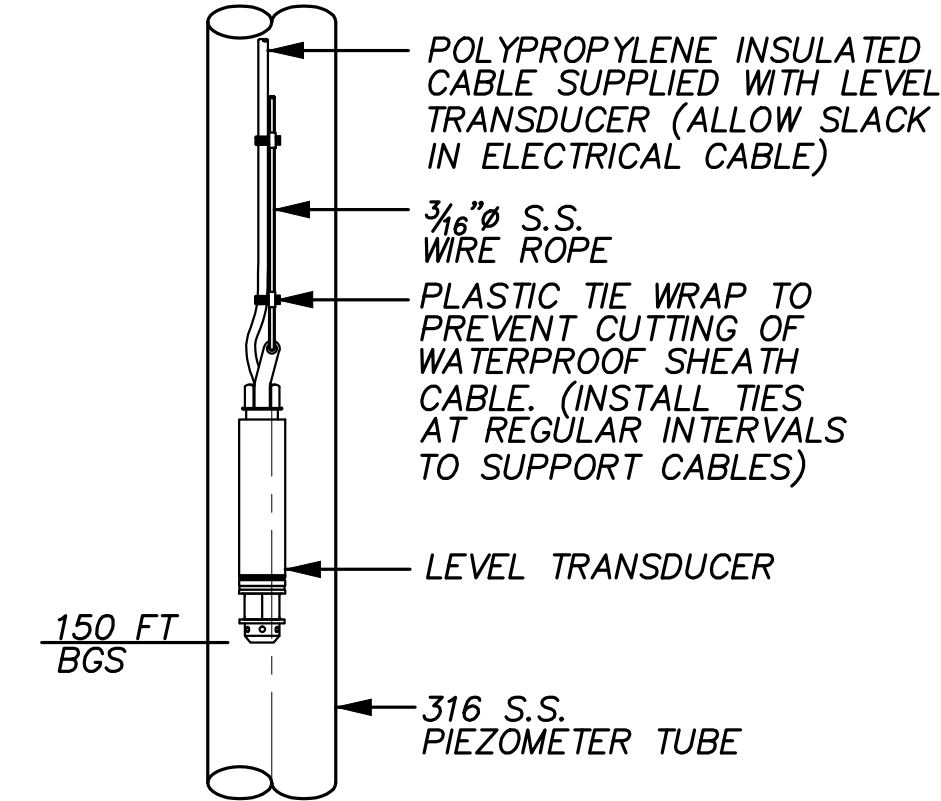


TRANSMITTER DETAIL

NOTE: POLYPROPYLENE INSULATED CABLE SUPPLIED
WITH LEVEL TRANSDUCER (ALLOW SLACK IN
ELECTRICAL CABLE)

CAMERA ACCESS/
PIEZOMETER DETAIL

NOT TO SCALE


2
-

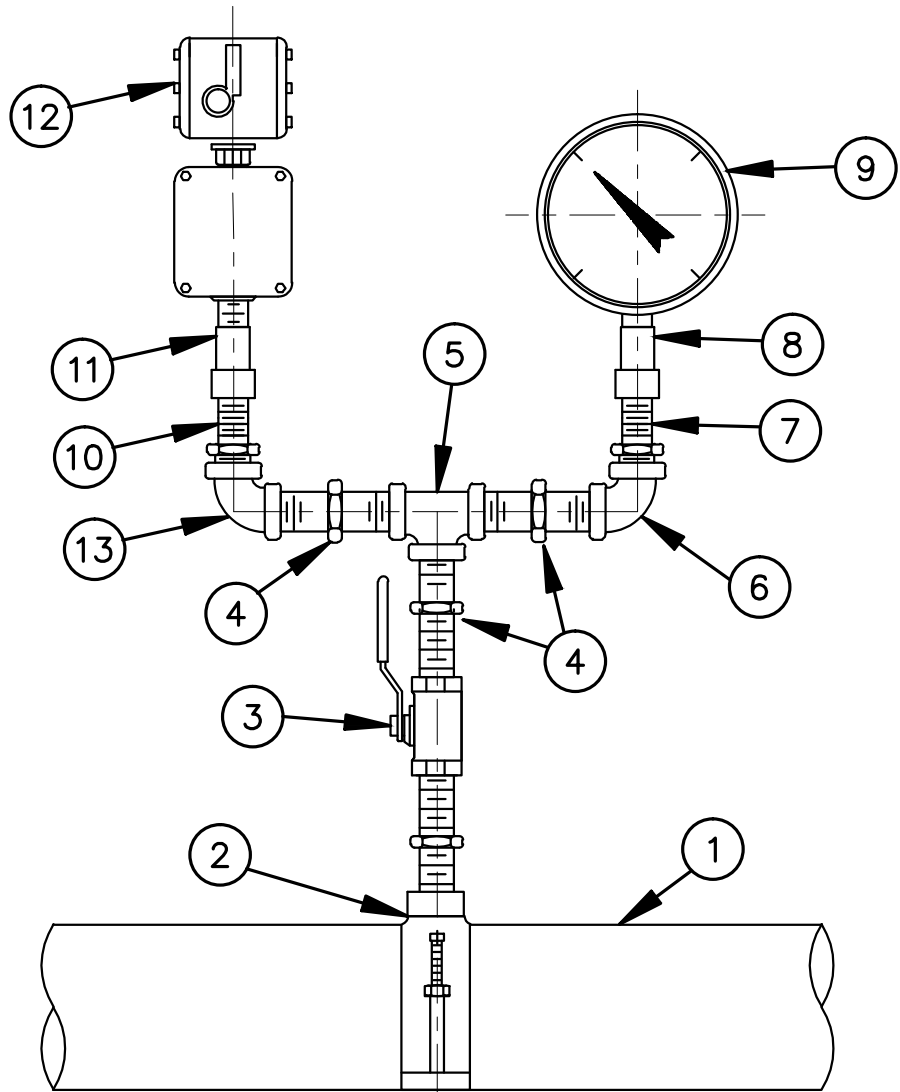

PRESSURE TRANSMITTER
AND GAUGE DETAIL

NOT TO SCALE


3
-

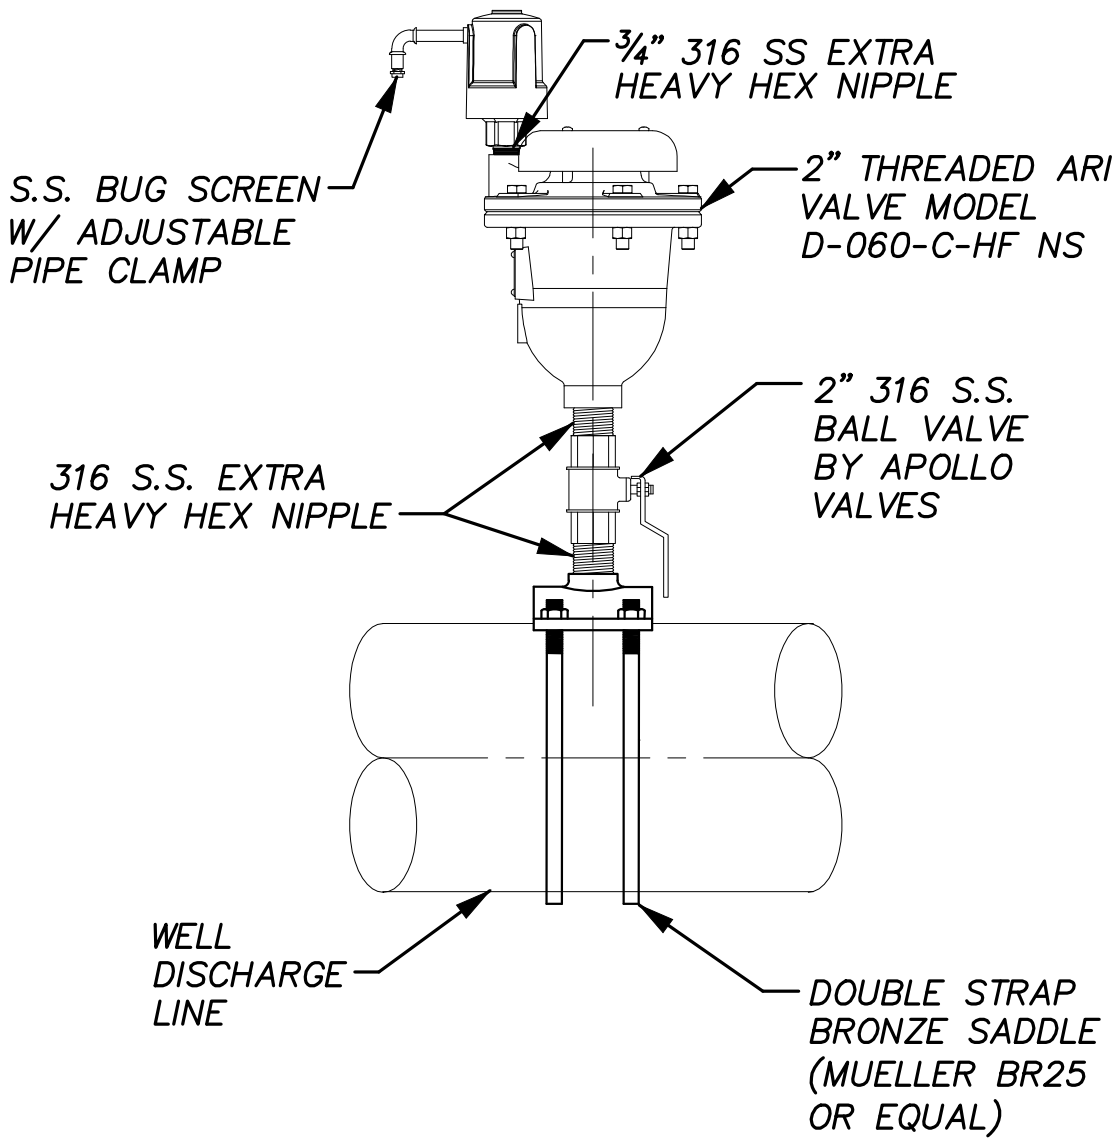

TYPICAL ARV ASSEMBLY

NOT TO SCALE

4
-

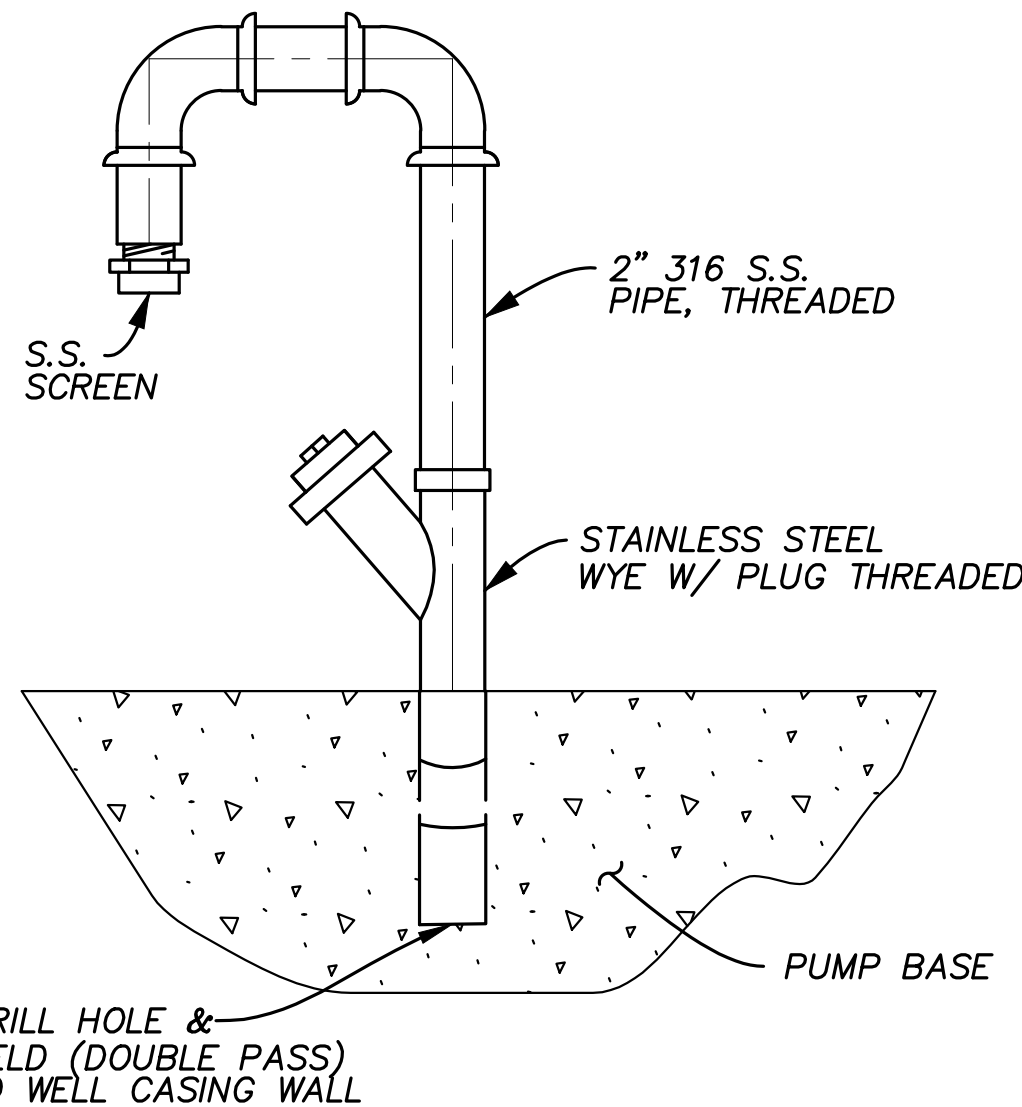


* ALL FITTINGS SHALL
BE 316 S.S.


WELL VENT DETAIL

NOT TO SCALE

5
-

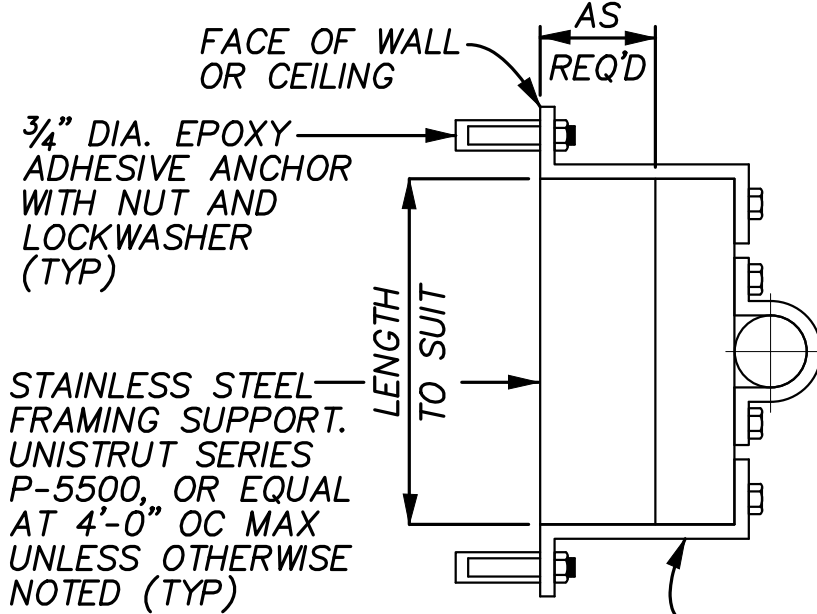

EXTENDED MOUNT

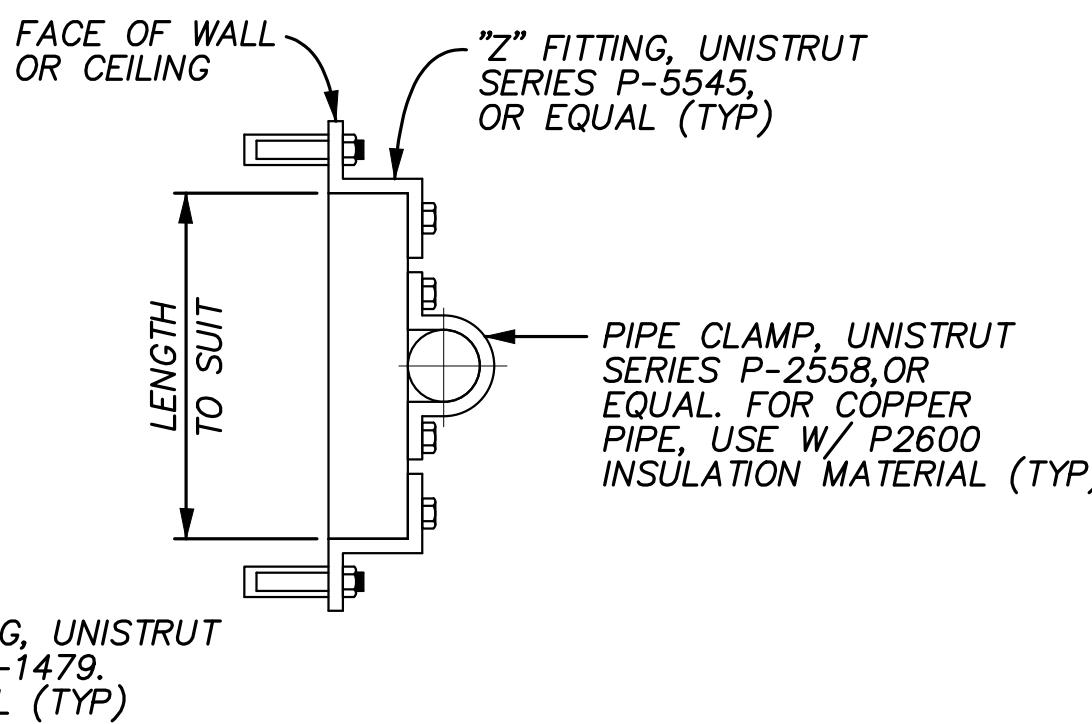

FLUSH MOUNT

NOTES:

1. USE THIS DETAIL FOR PIPES 3-INCHES AND
SMALLER IN DIAMETER.
2. ALL MATERIALS SHALL BE 316 STAINLESS STEEL

PIPE SUPPORT FOR INDIVIDUAL PIPES

NOT TO SCALE

6
-

AKM JOB No. 0761209.00

Underground Service Alert
Call: TOLL FREE



TWO WORKING DAYS BEFORE YOU DIG

0 1/2 1 24x36 FORMAT
IF THIS BAR MEASURES 1" THEN
DRAWING SCALE IS AS NOTED
0 1/4 1/2 12x18 FORMAT
WARNING: IF THIS BAR MEASURES
1/2" THEN DRAWING IS NOT FULL
SCALE AND IS 50% REDUCED

Designed by D. BAKER
Drawn by M.U. R.U.
Checked by G. HOBSON
PLANS PREPARED UNDER SUPERVISION OF
GARY J. HOBSON
Date JULY 2017 R.C.E. No. 40779

Reference Plans for
these Improvements

Date

By

REVISIONS

App'd



AKM CONSULTING ENGINEERS
553 WALD
IRVINE, CA. 92618
(949) 753-7333

Engineering
Operations

Department of Water and Power Approval
By: [Signature] 8/4/2017
Vernon R. Weisman, P.E.
District Engineer
R.C.E. No. 41610


CITY OF CORONA - RESIN TREATMENT OF NITRATE SOURCES
WELLS 32 AND 33 EQUIPPING
MECHANICAL DETAILS







Drawing No.

13-038U

M-3

Sht. 8 of 21

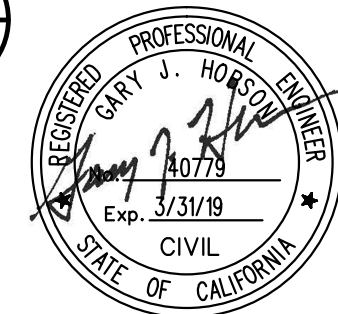

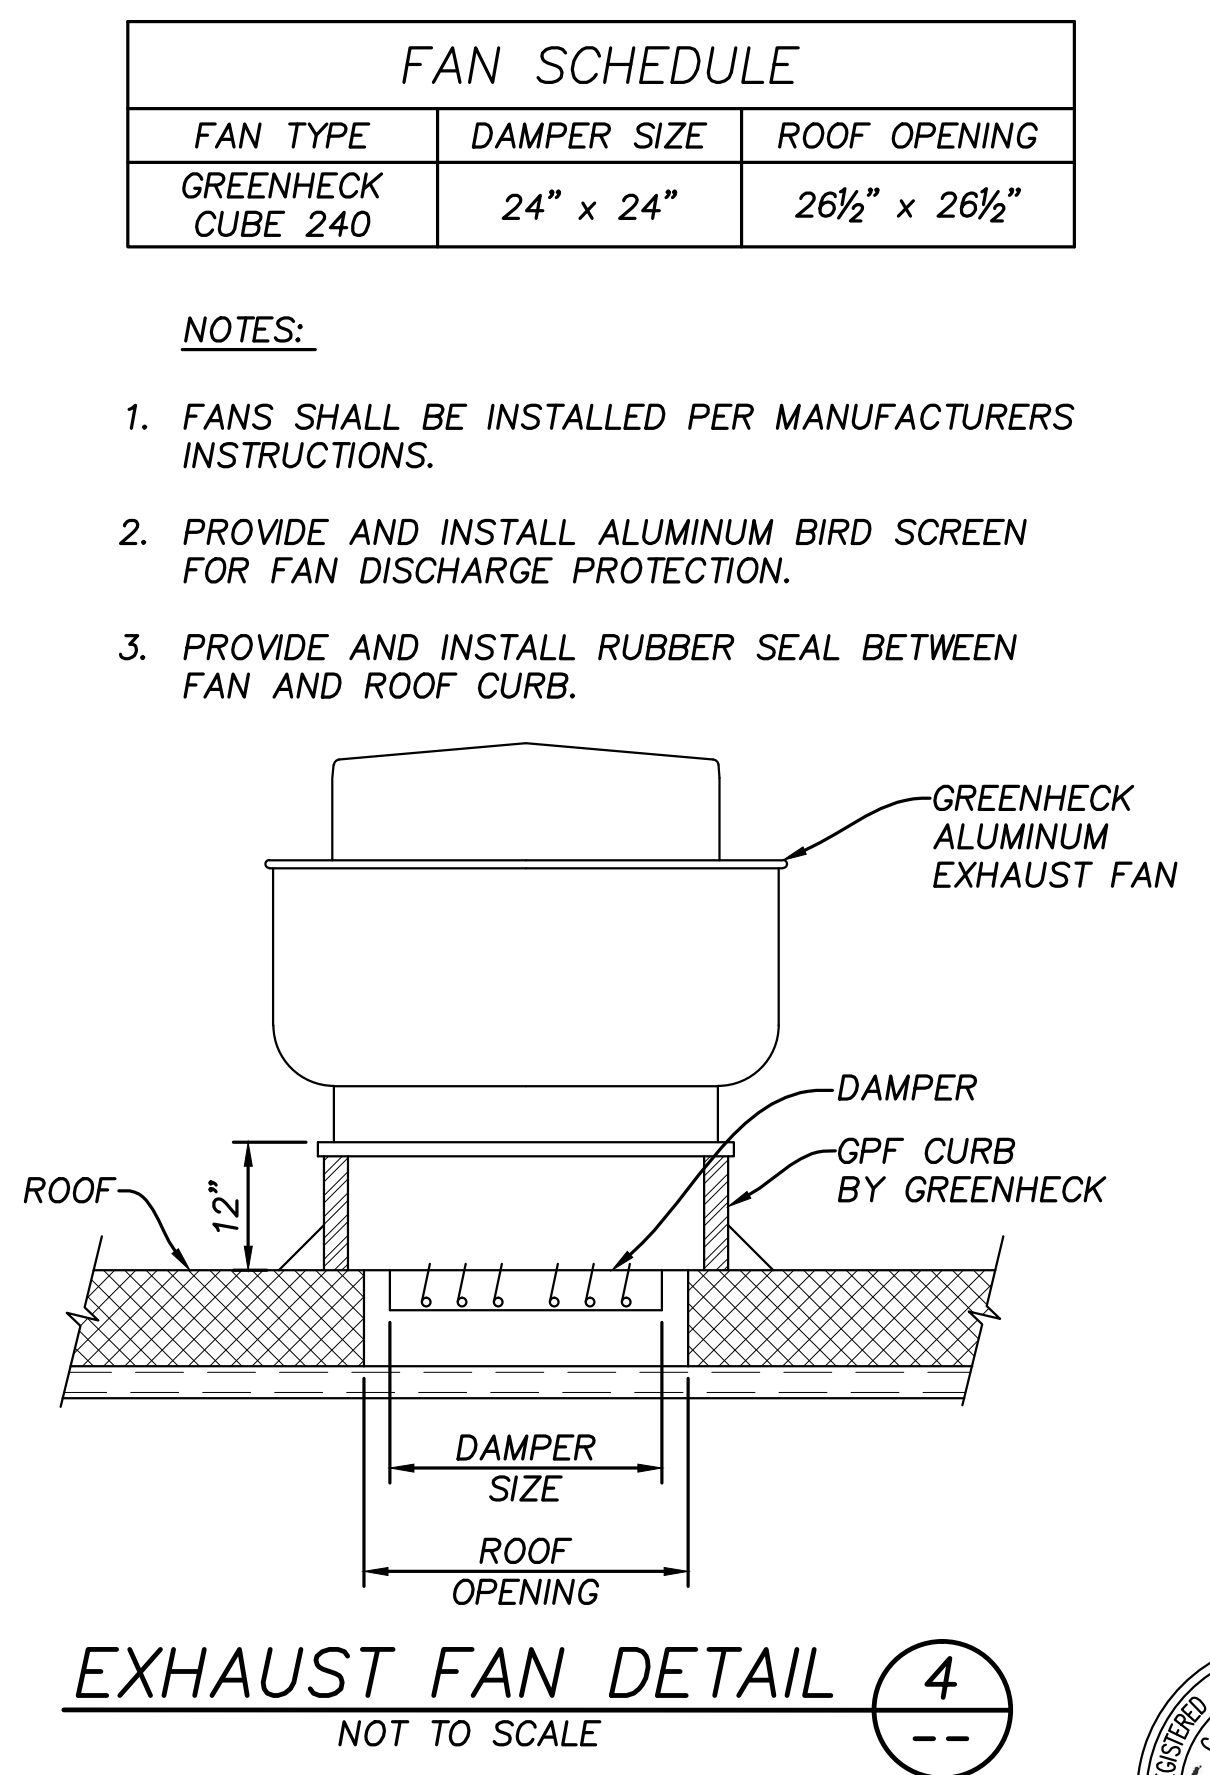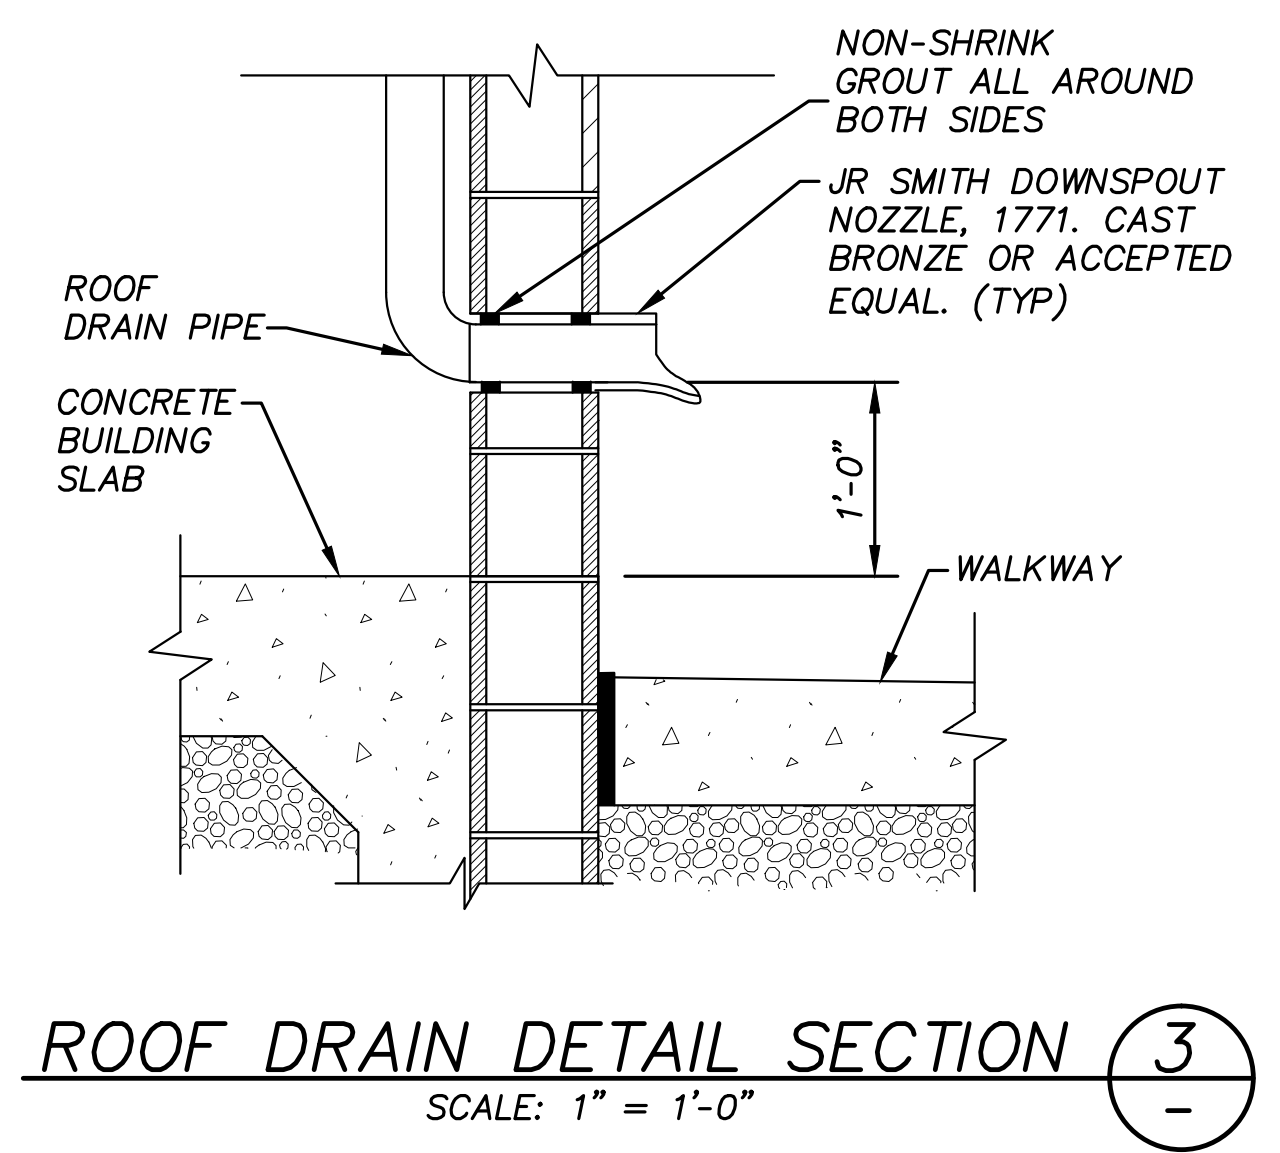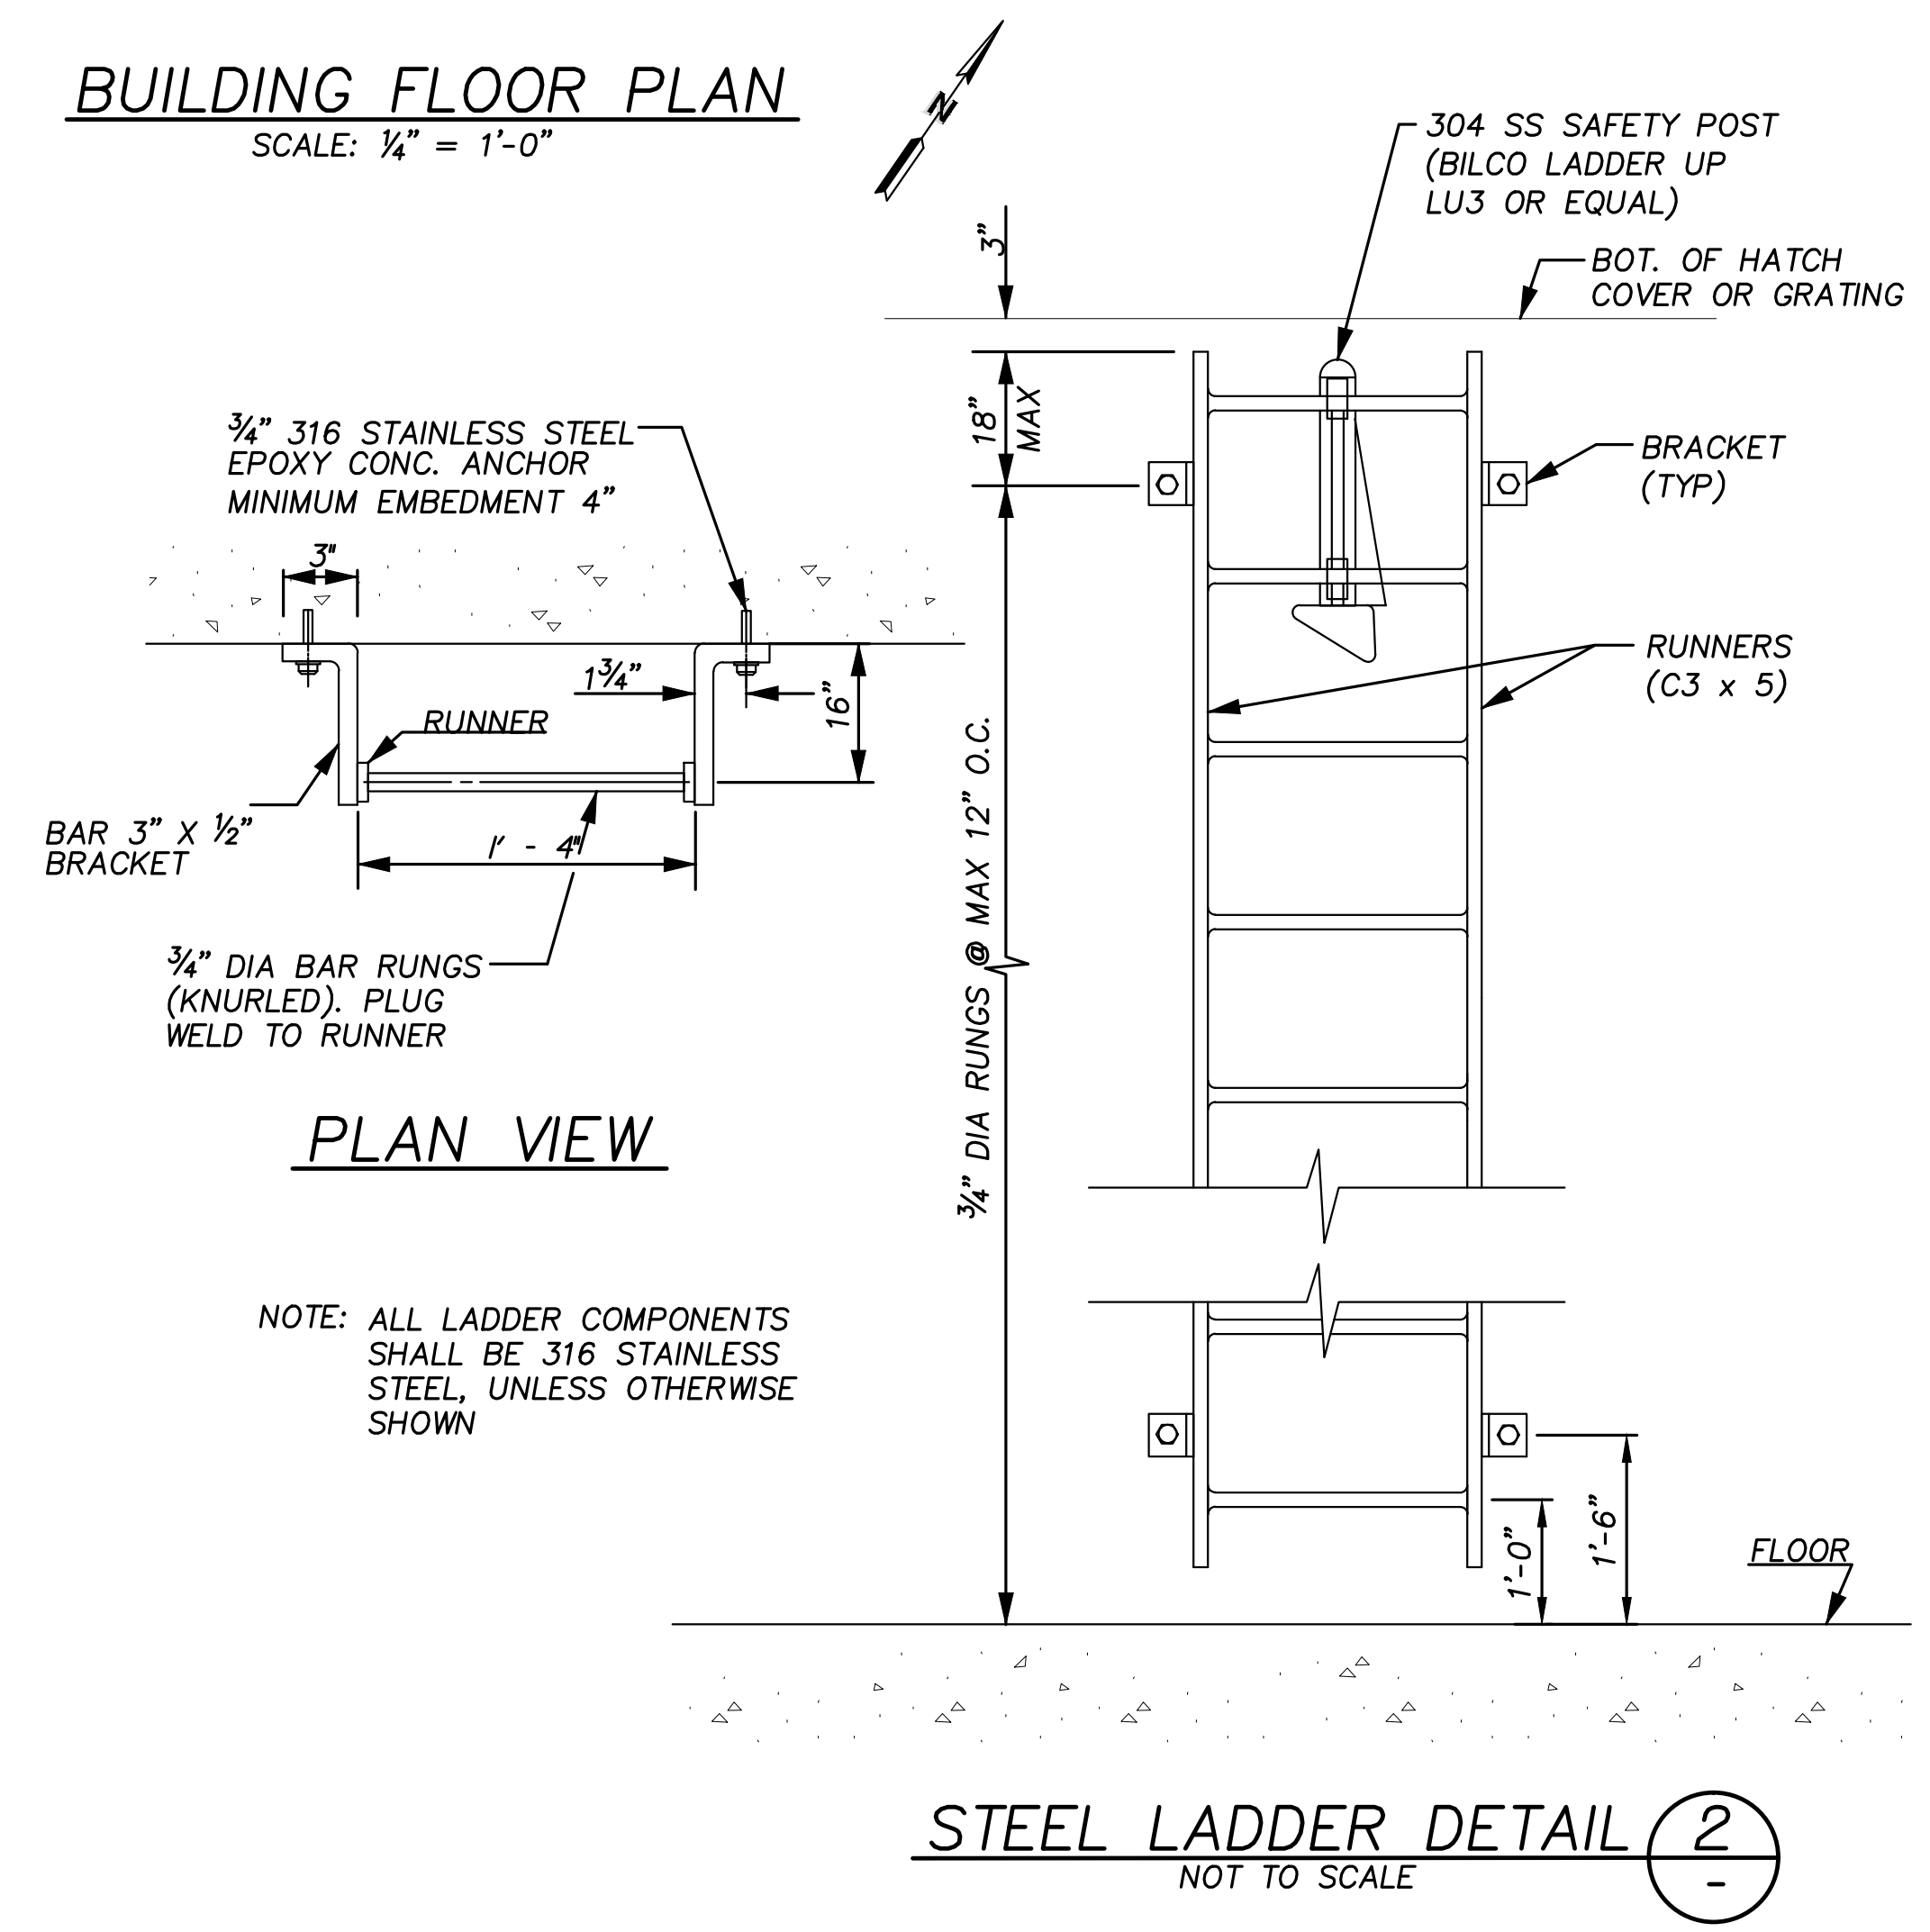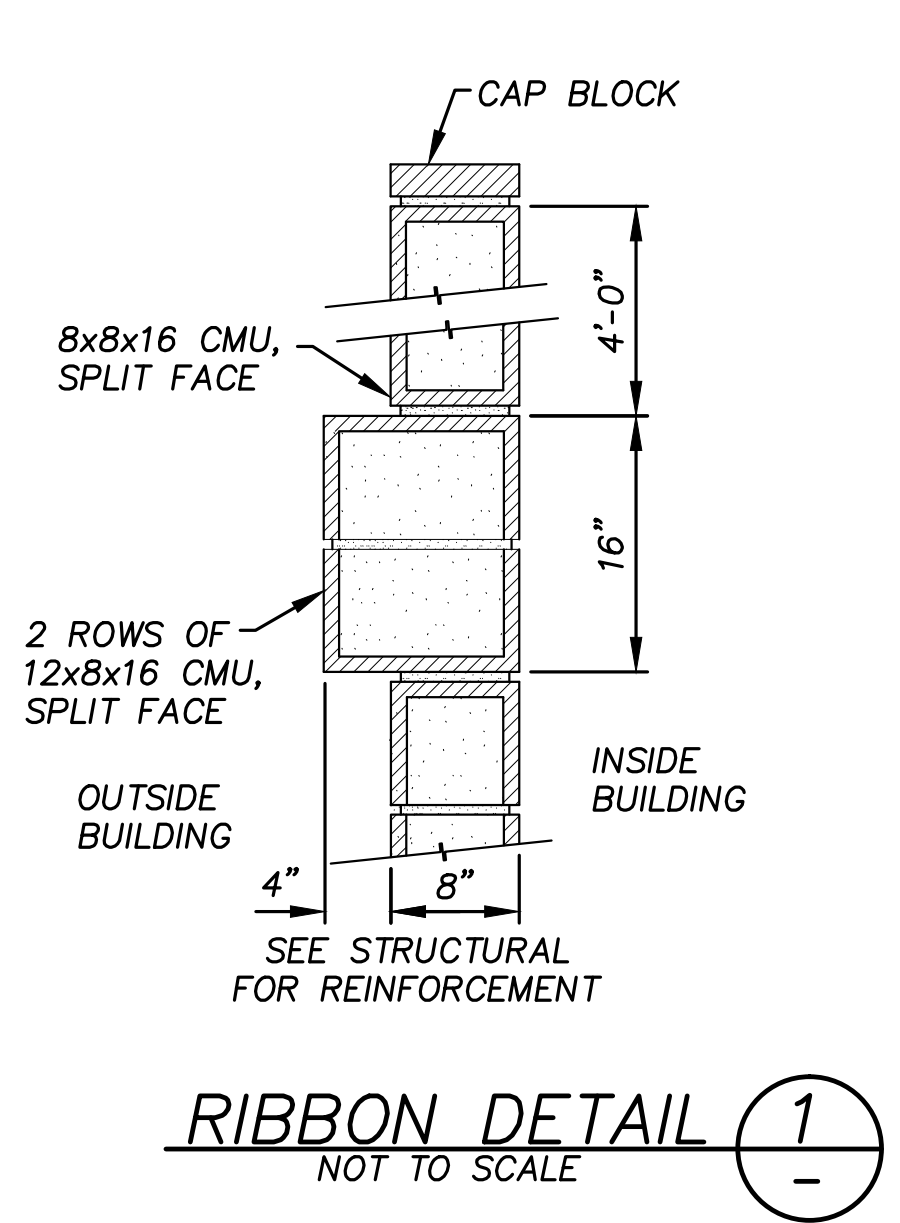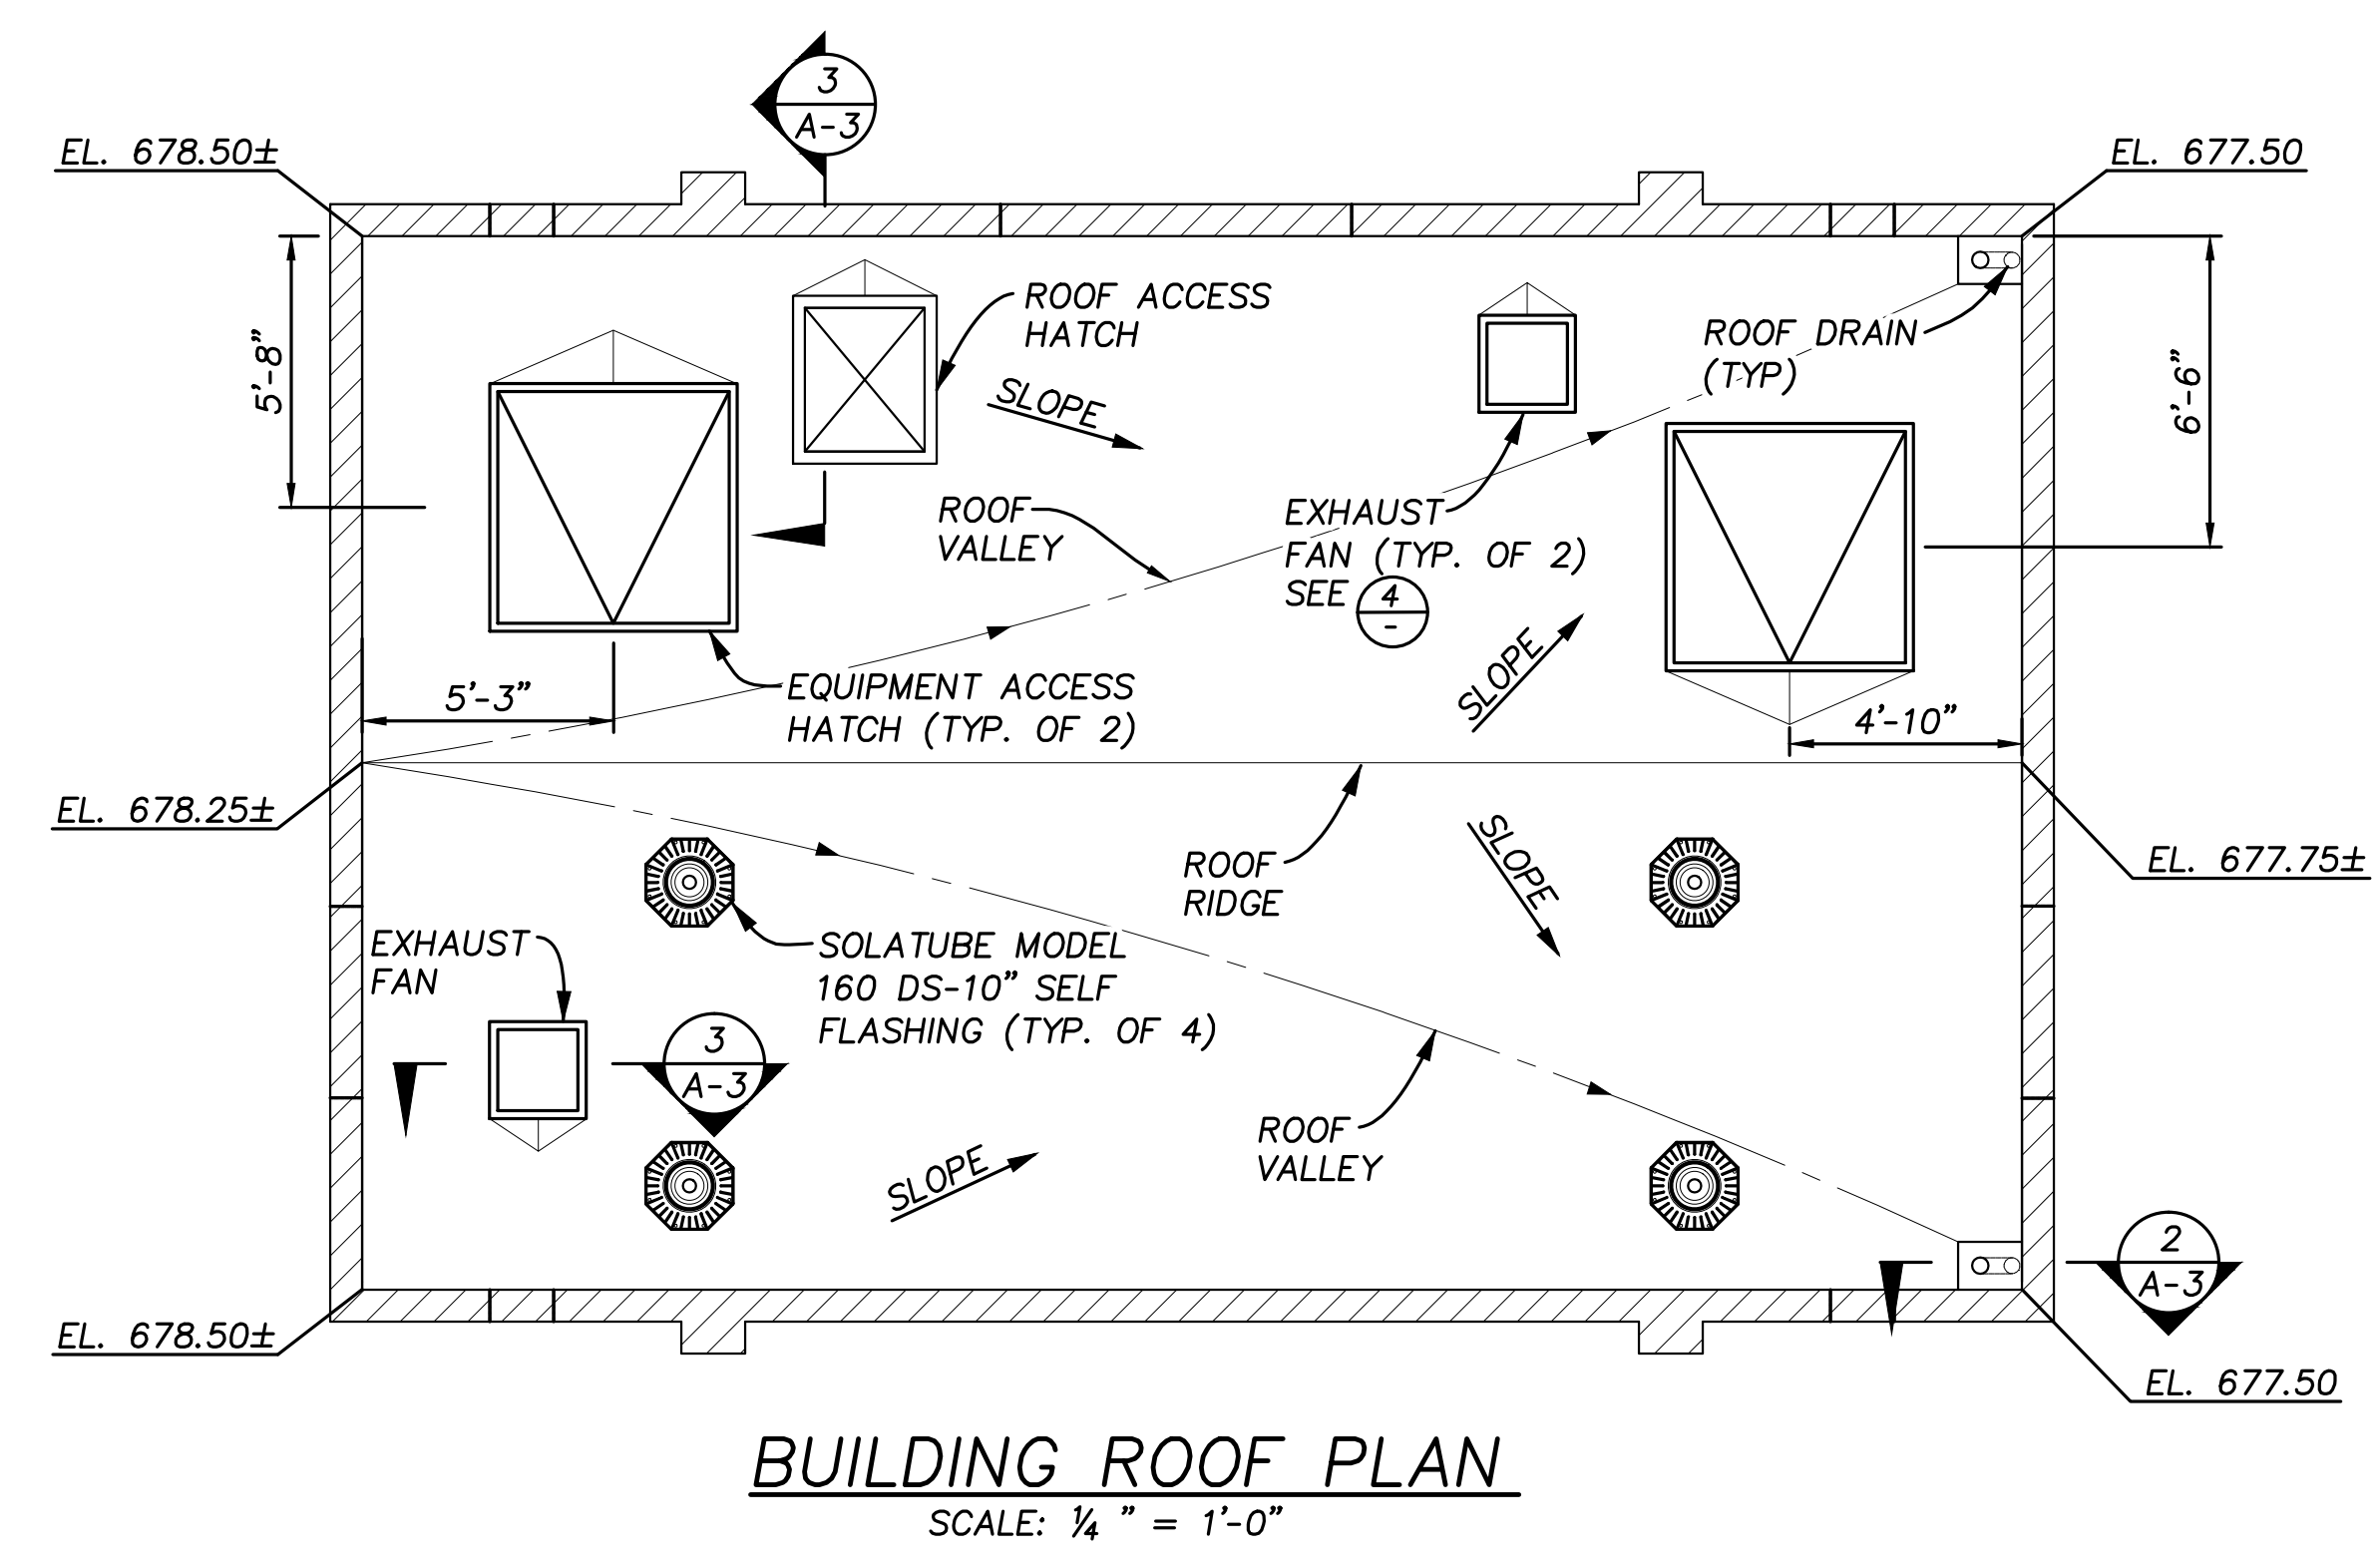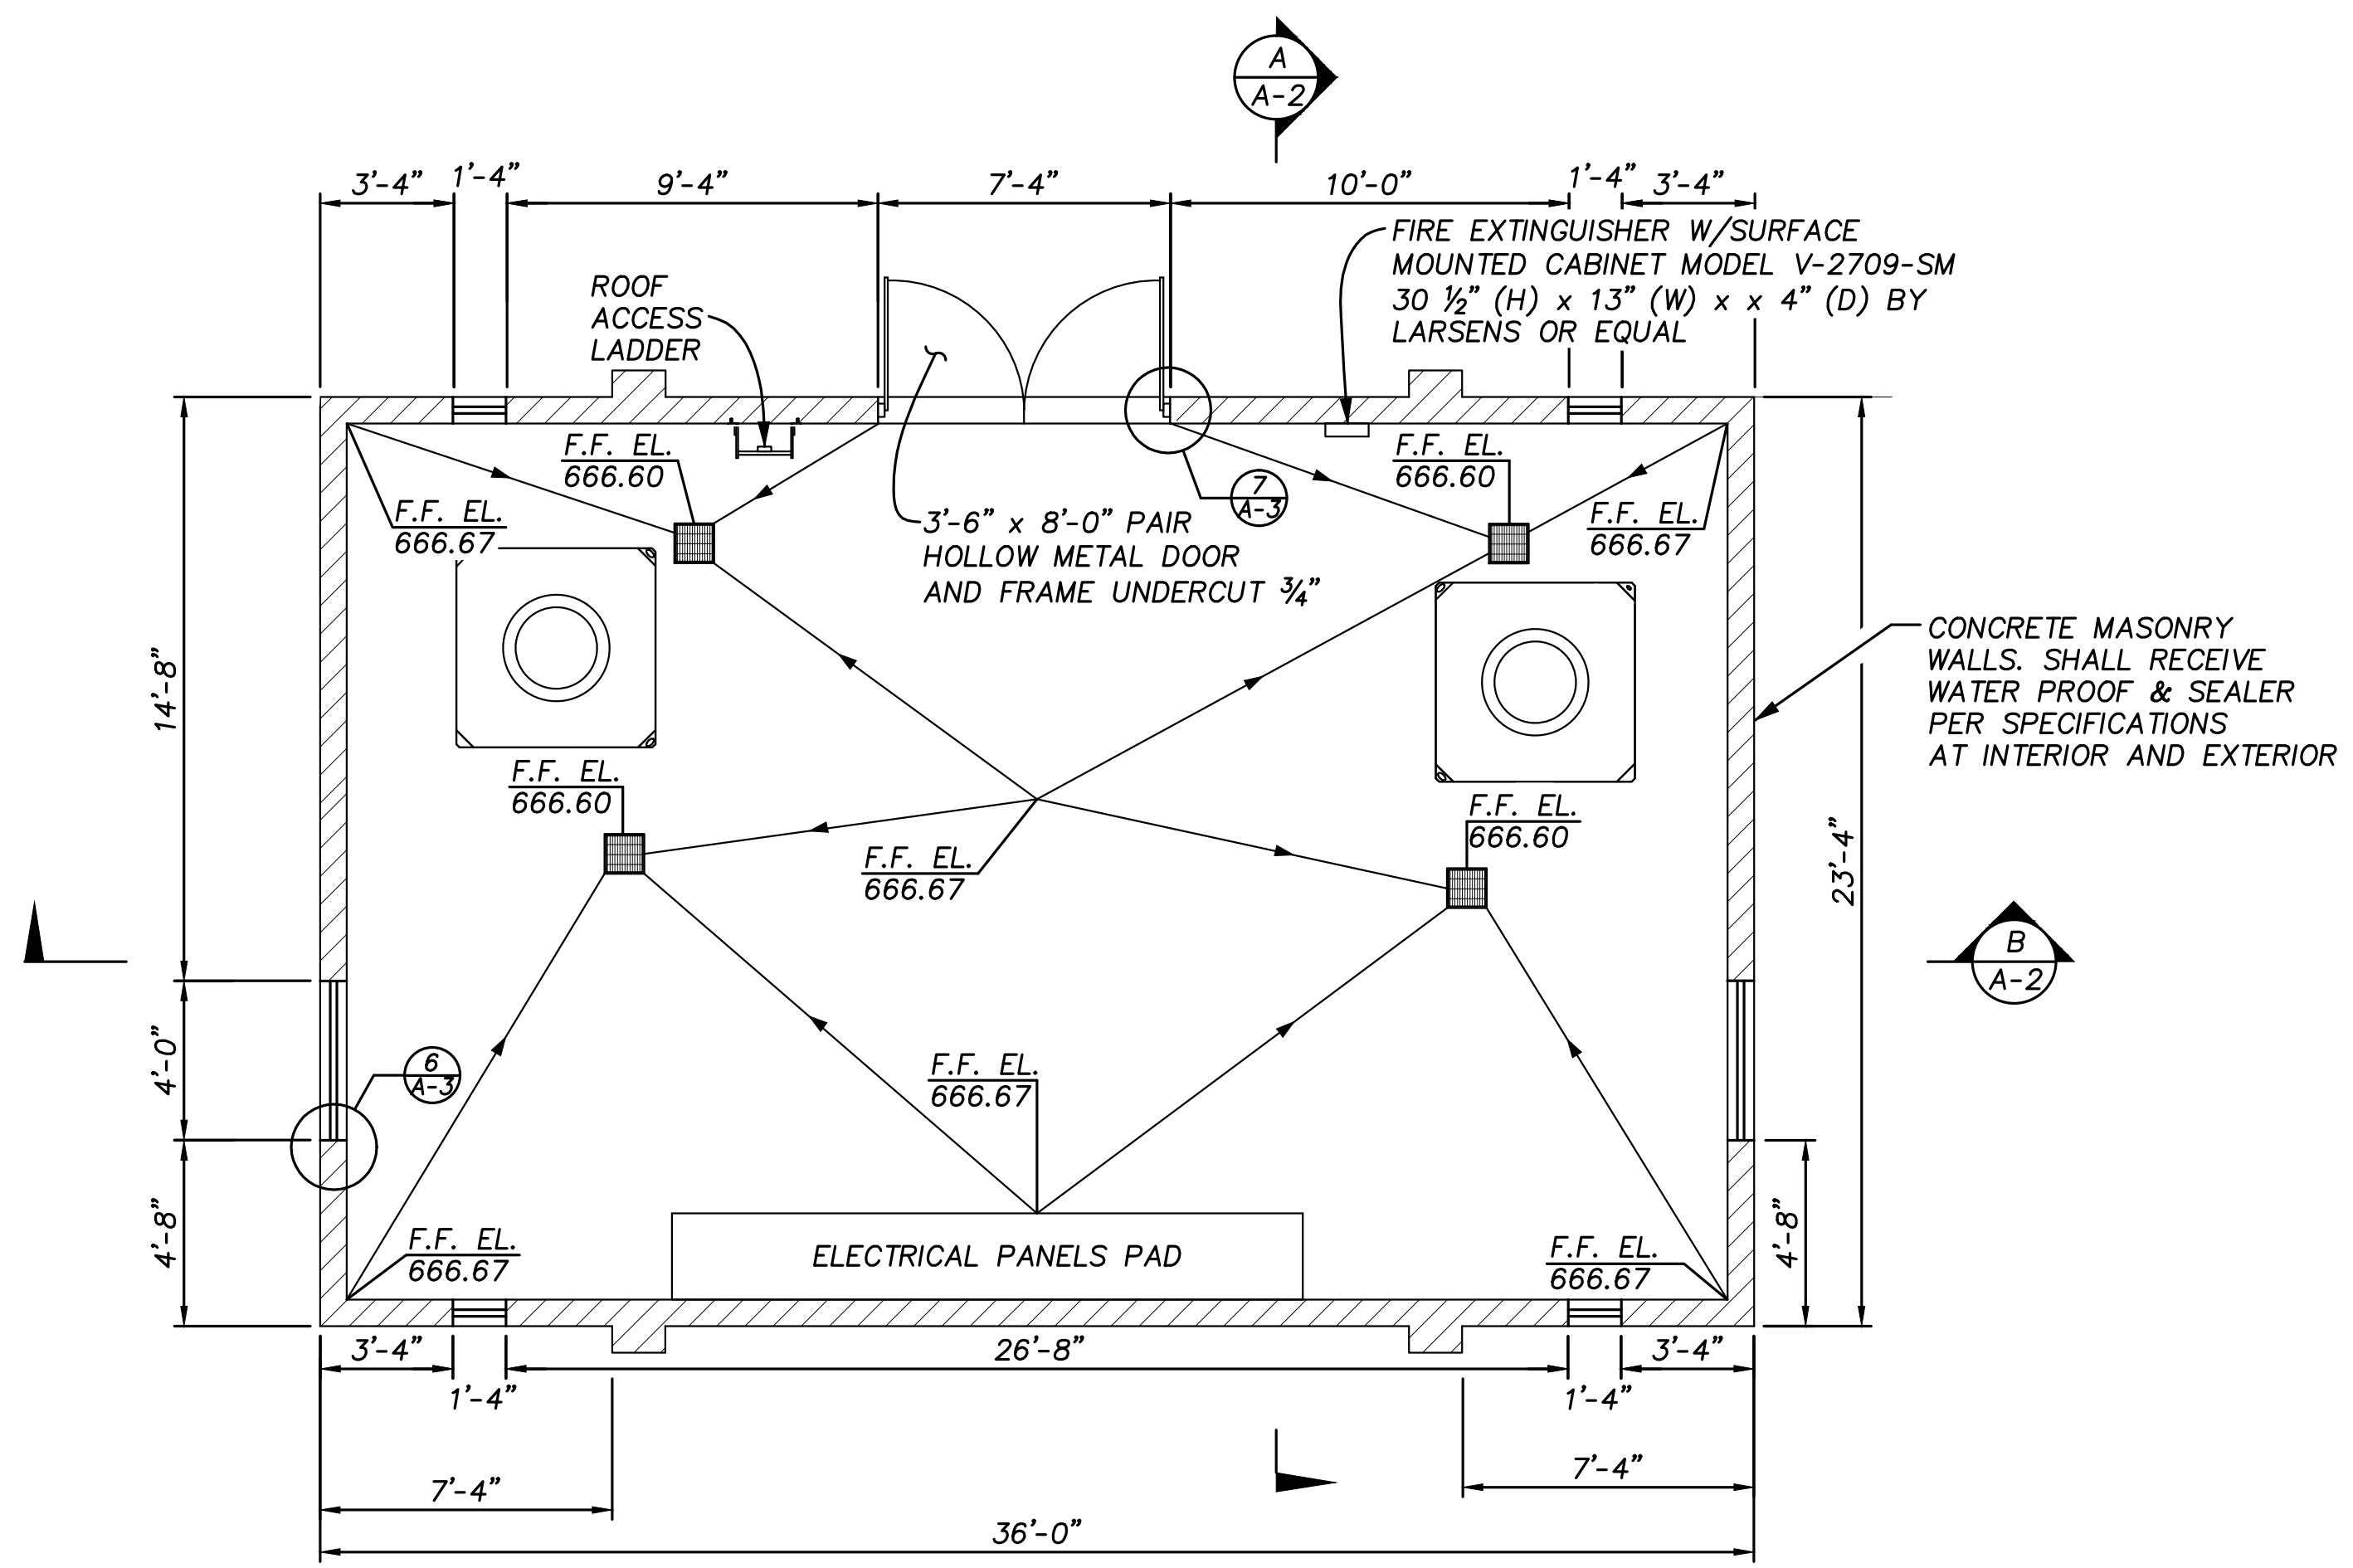

FAN SCHEDULE		
FAN TYPE	DAMPER SIZE	ROOF OPENING
GREENHECK CUBE 240	24" x 24"	26 1/2" x 26 1/2"

- NOTES:**
- FANS SHALL BE INSTALLED PER MANUFACTURERS INSTRUCTIONS.
 - PROVIDE AND INSTALL ALUMINUM BIRD SCREEN FOR FAN DISCHARGE PROTECTION.
 - PROVIDE AND INSTALL RUBBER SEAL BETWEEN FAN AND ROOF CURB.

AKM JOB No. 0761209.00


Underground Service Alert
Call: TOLL FREE

811


TWO WORKING DAYS BEFORE YOU DIG

Designed by D. BAKER	Drawn by M.U. R.U.	Checked by G. HOBSON
PLANS PREPARED UNDER SUPERVISION OF GARY J. HOBSON R.C.E. No. 40779		
Date JULY 2017	Reference Plans for these Improvements	Date By App'd


AKM AKM CONSULTING ENGINEERS 553 WALD IRVINE, CA. 92618 (949) 753-7333	Engineering _____ Operations _____	Department of Water and Power Approval By: <i>[Signature]</i> 8/4/2017 Vernon R. Weisman, P.E. District Engineer R.C.E. No. 41610	CITY OF CORONA - RESIN TREATMENT OF NITRATE SOURCES WELLS 32 AND 33 EQUIPPING FLOOR AND ROOF PLANS	Drawing No. 13-038U A-1 Sht. 9 of 21
---	---------------------------------------	---	--	---

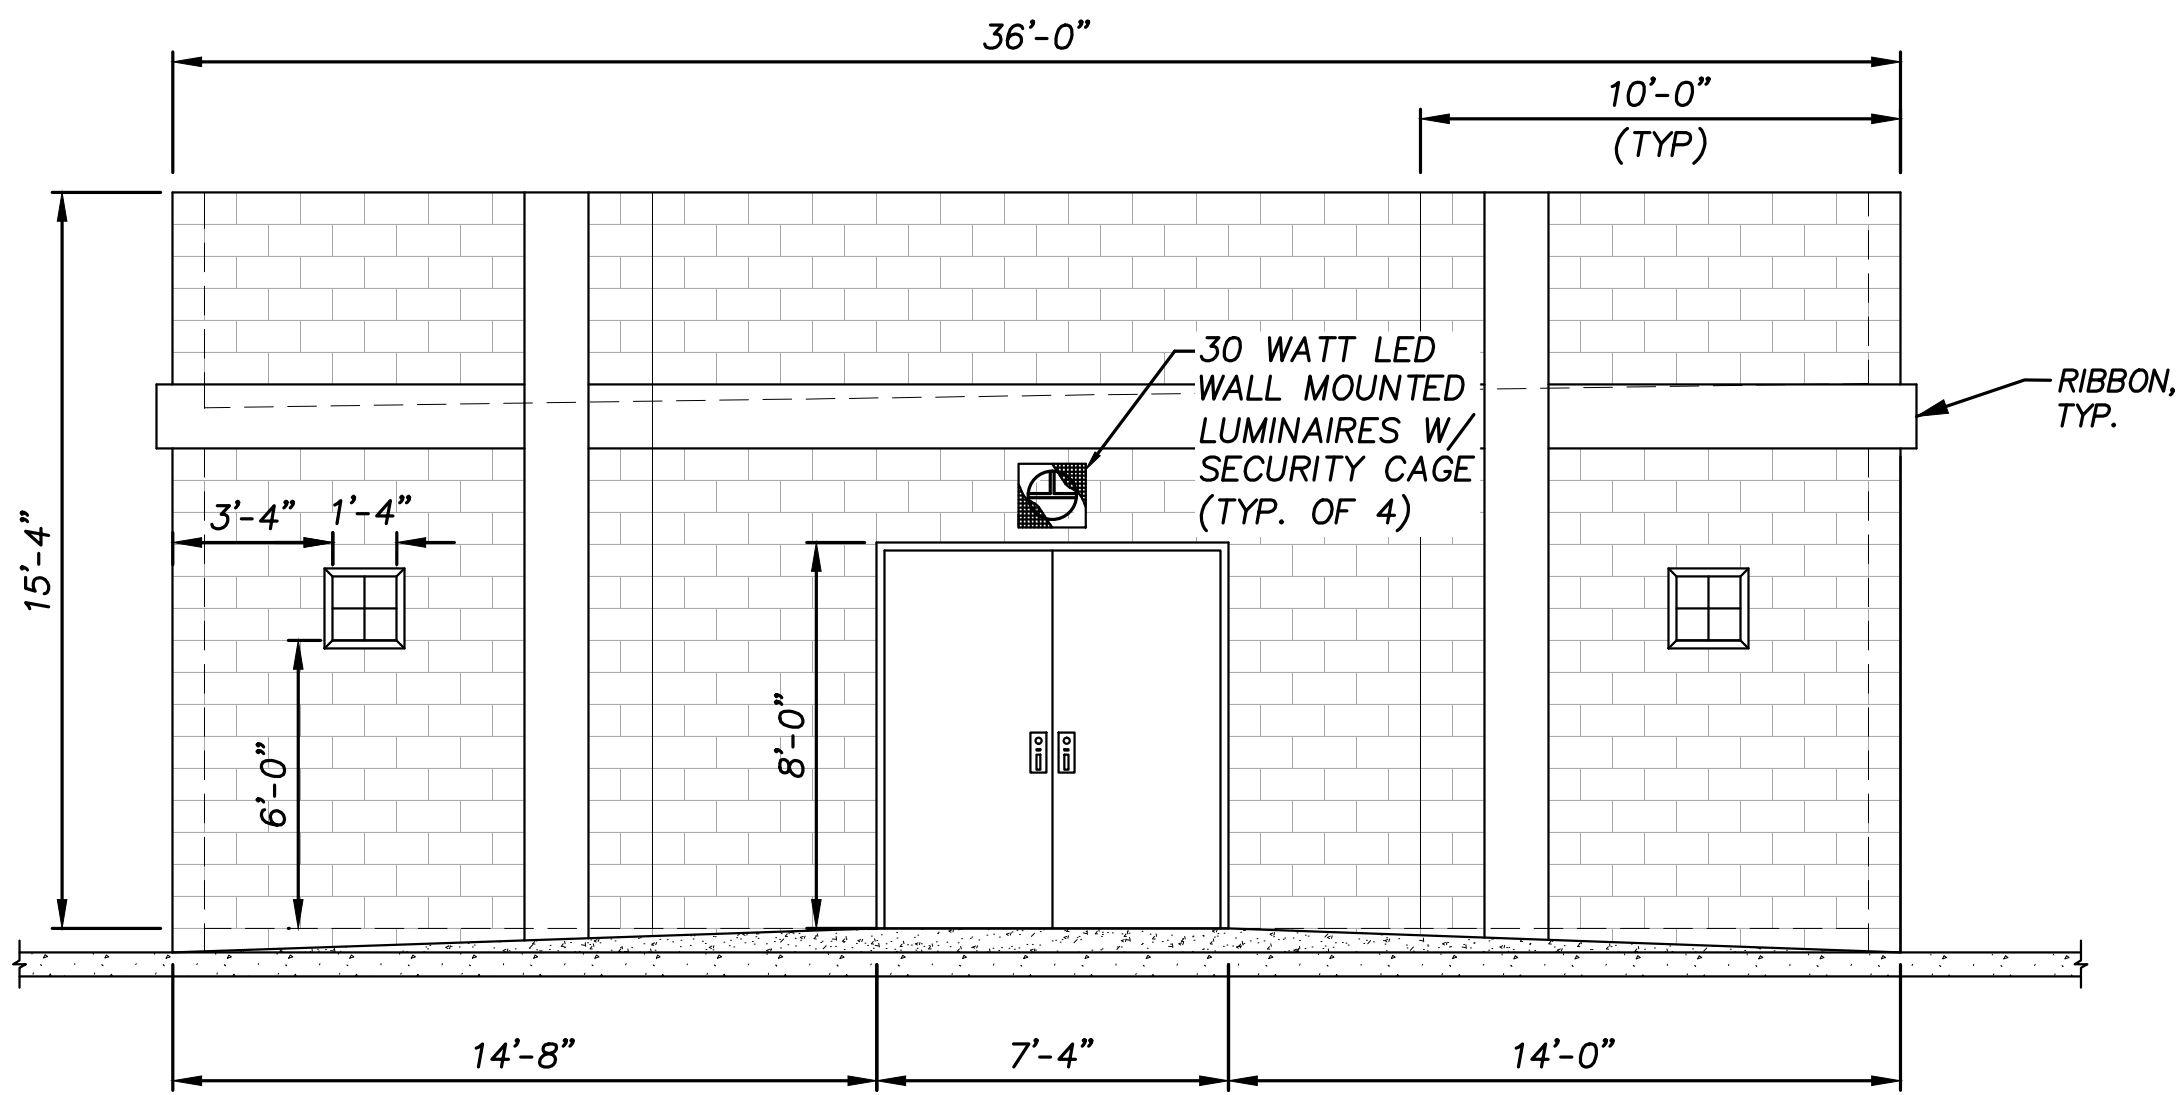


NORTH ELEVATION
SCALE: 1/4" = 1'-0"

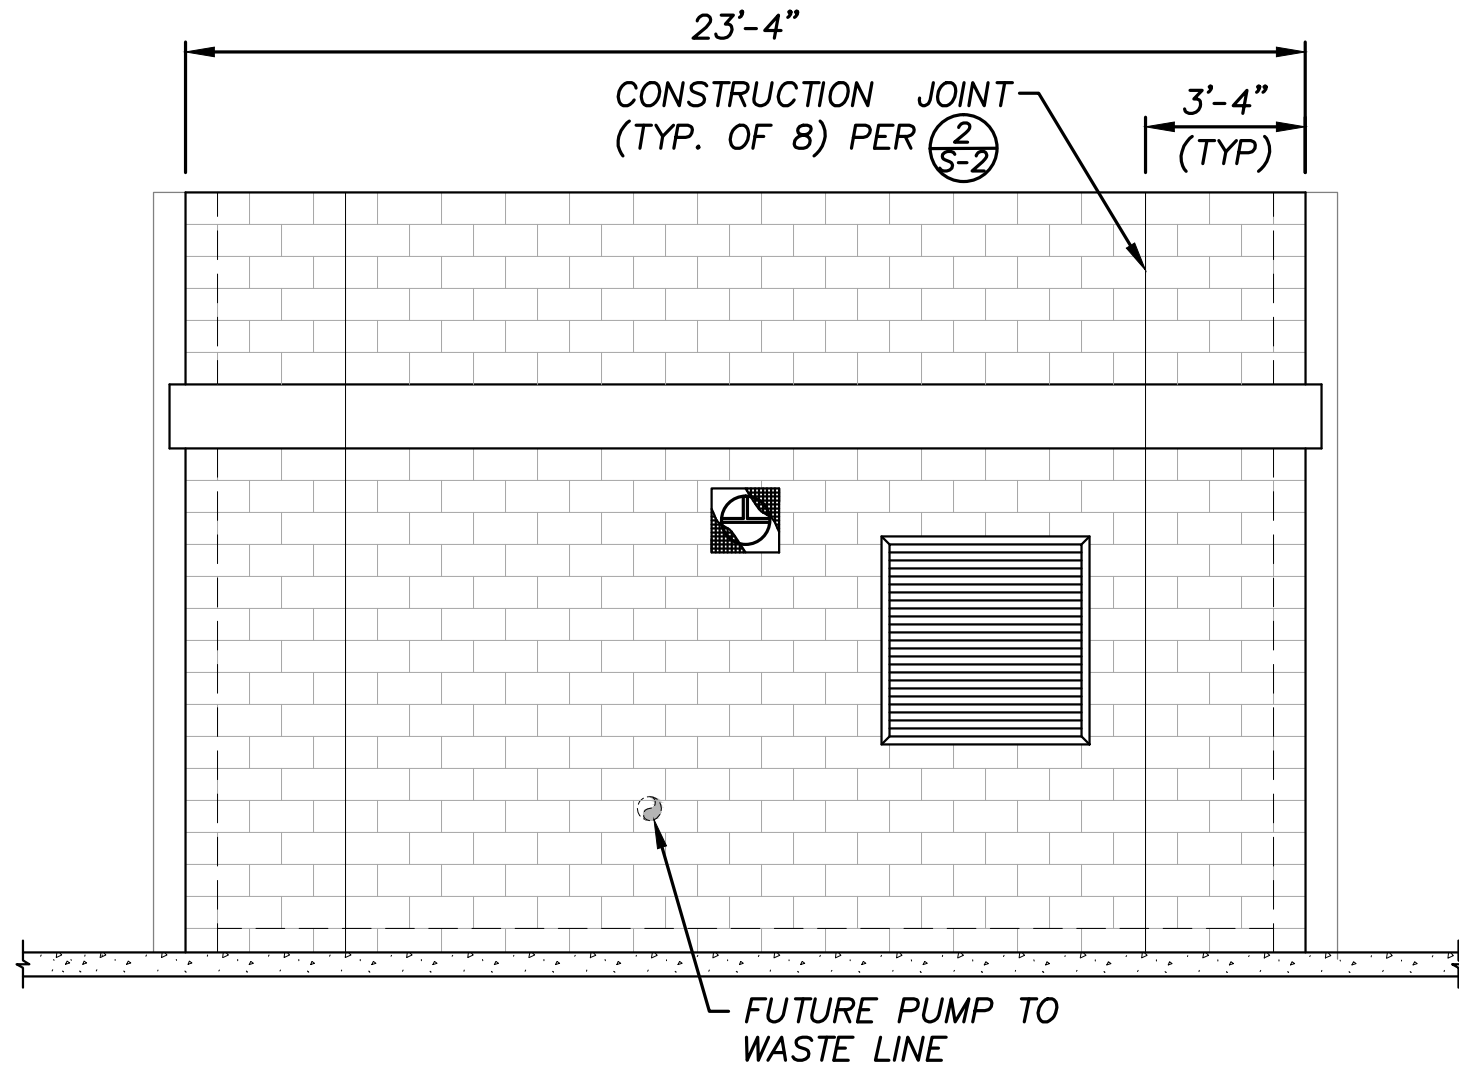


WEST ELEVATION
SCALE: 1/4" = 1'-0"

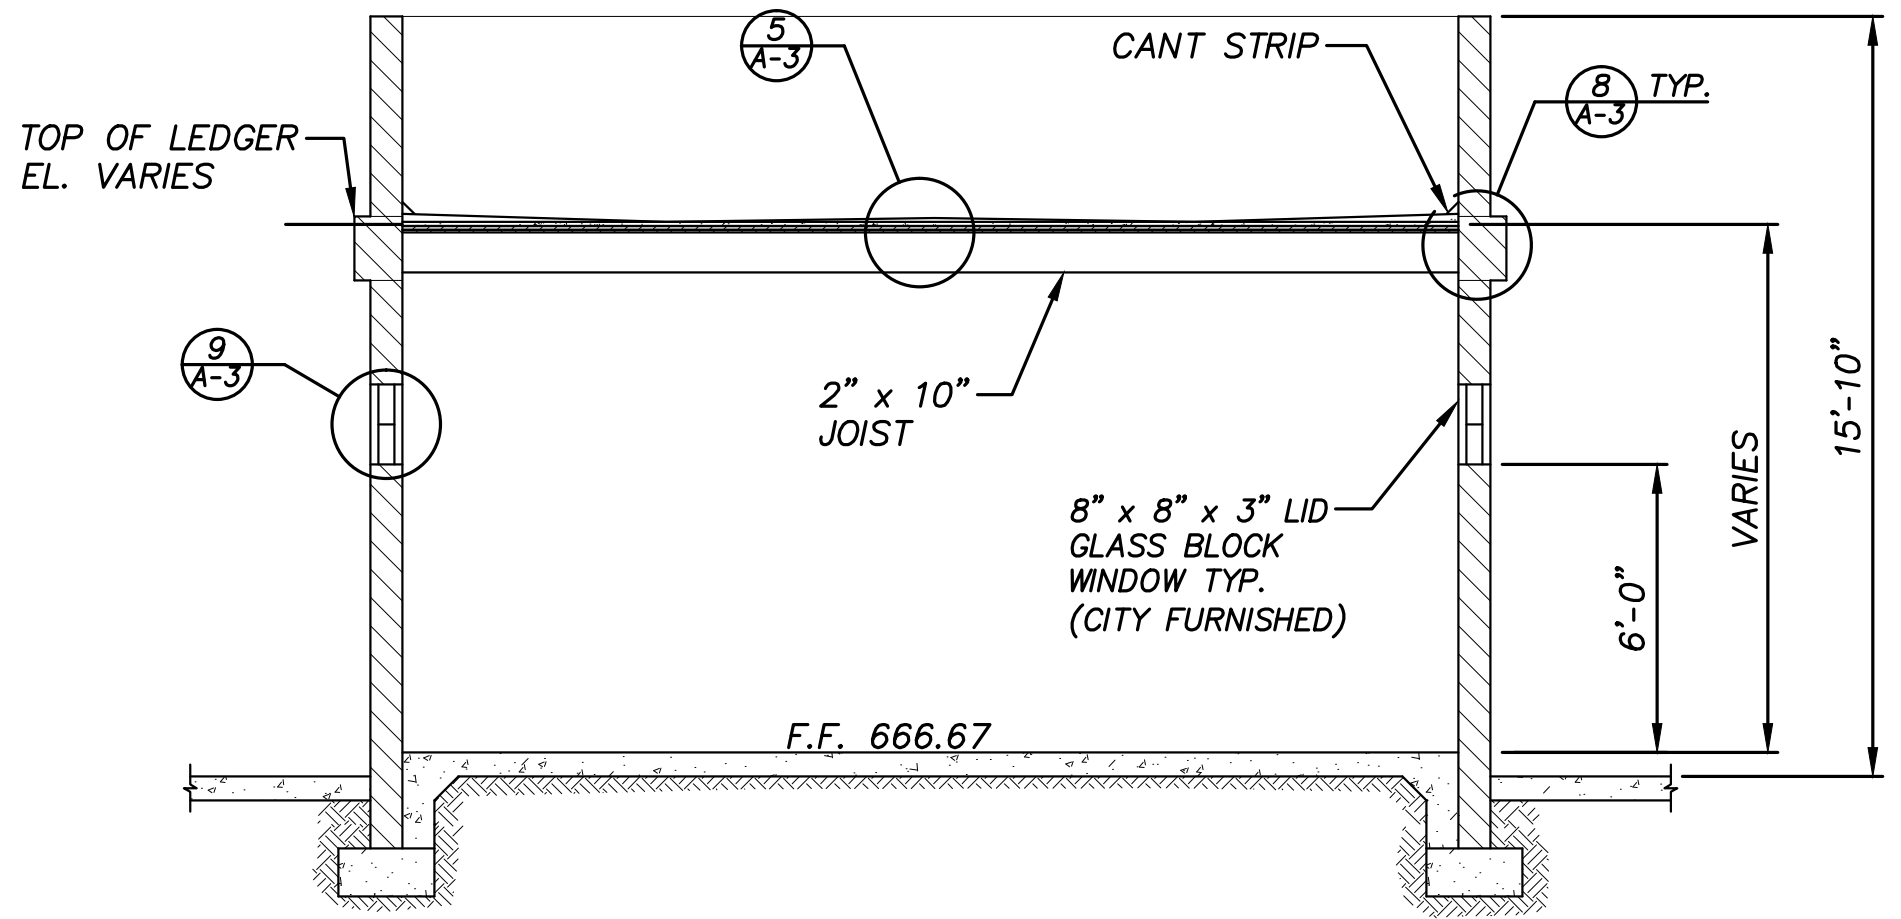


SECTION A
SCALE: 1/4" = 1'-0"

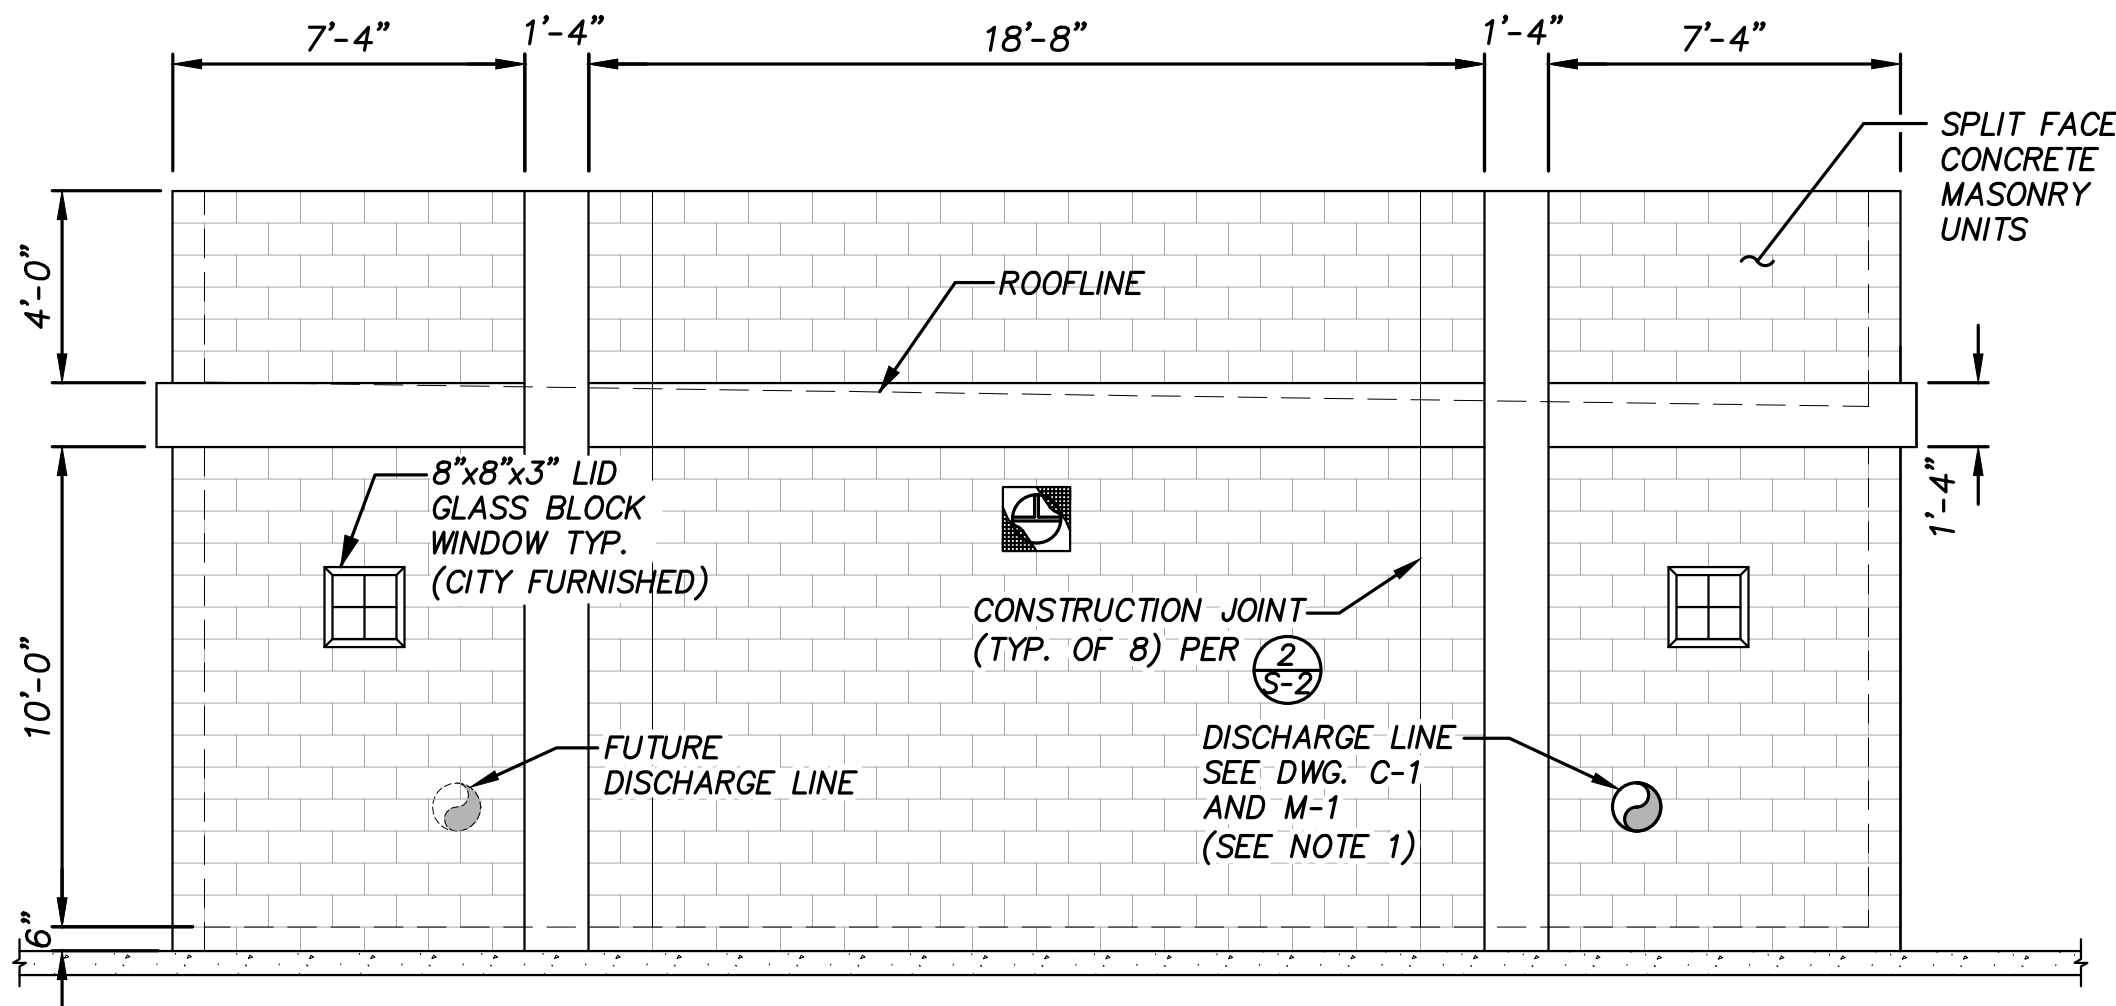

SOUTH ELEVATION
SCALE: 1/4" = 1'-0"

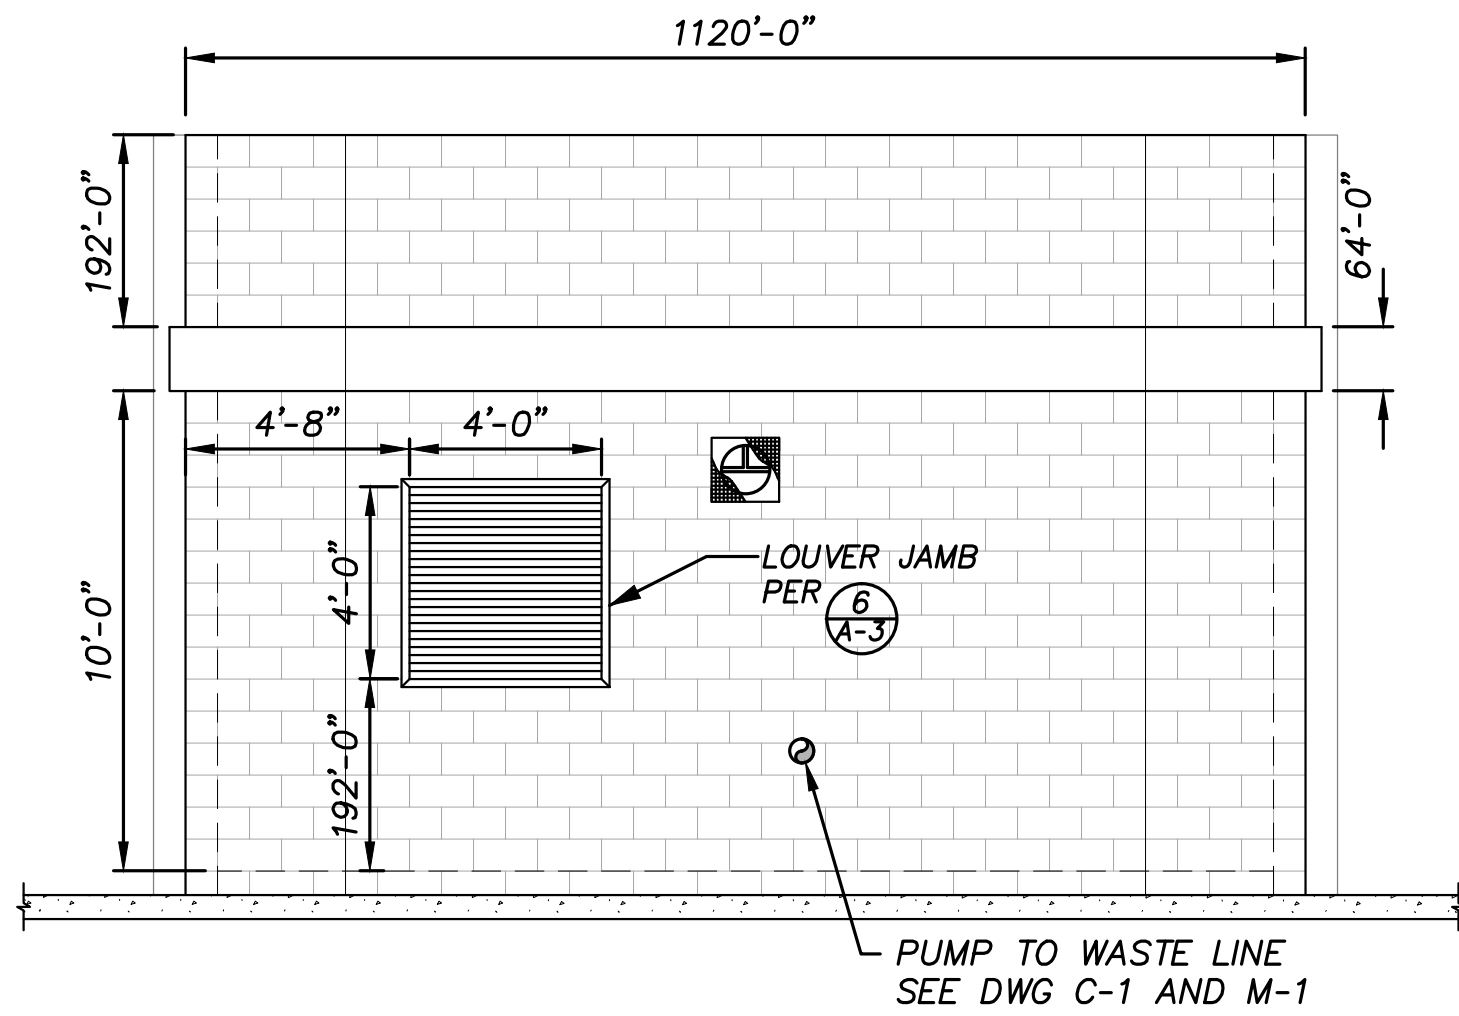

EAST ELEVATION
SCALE: 1/4" = 1'-0"

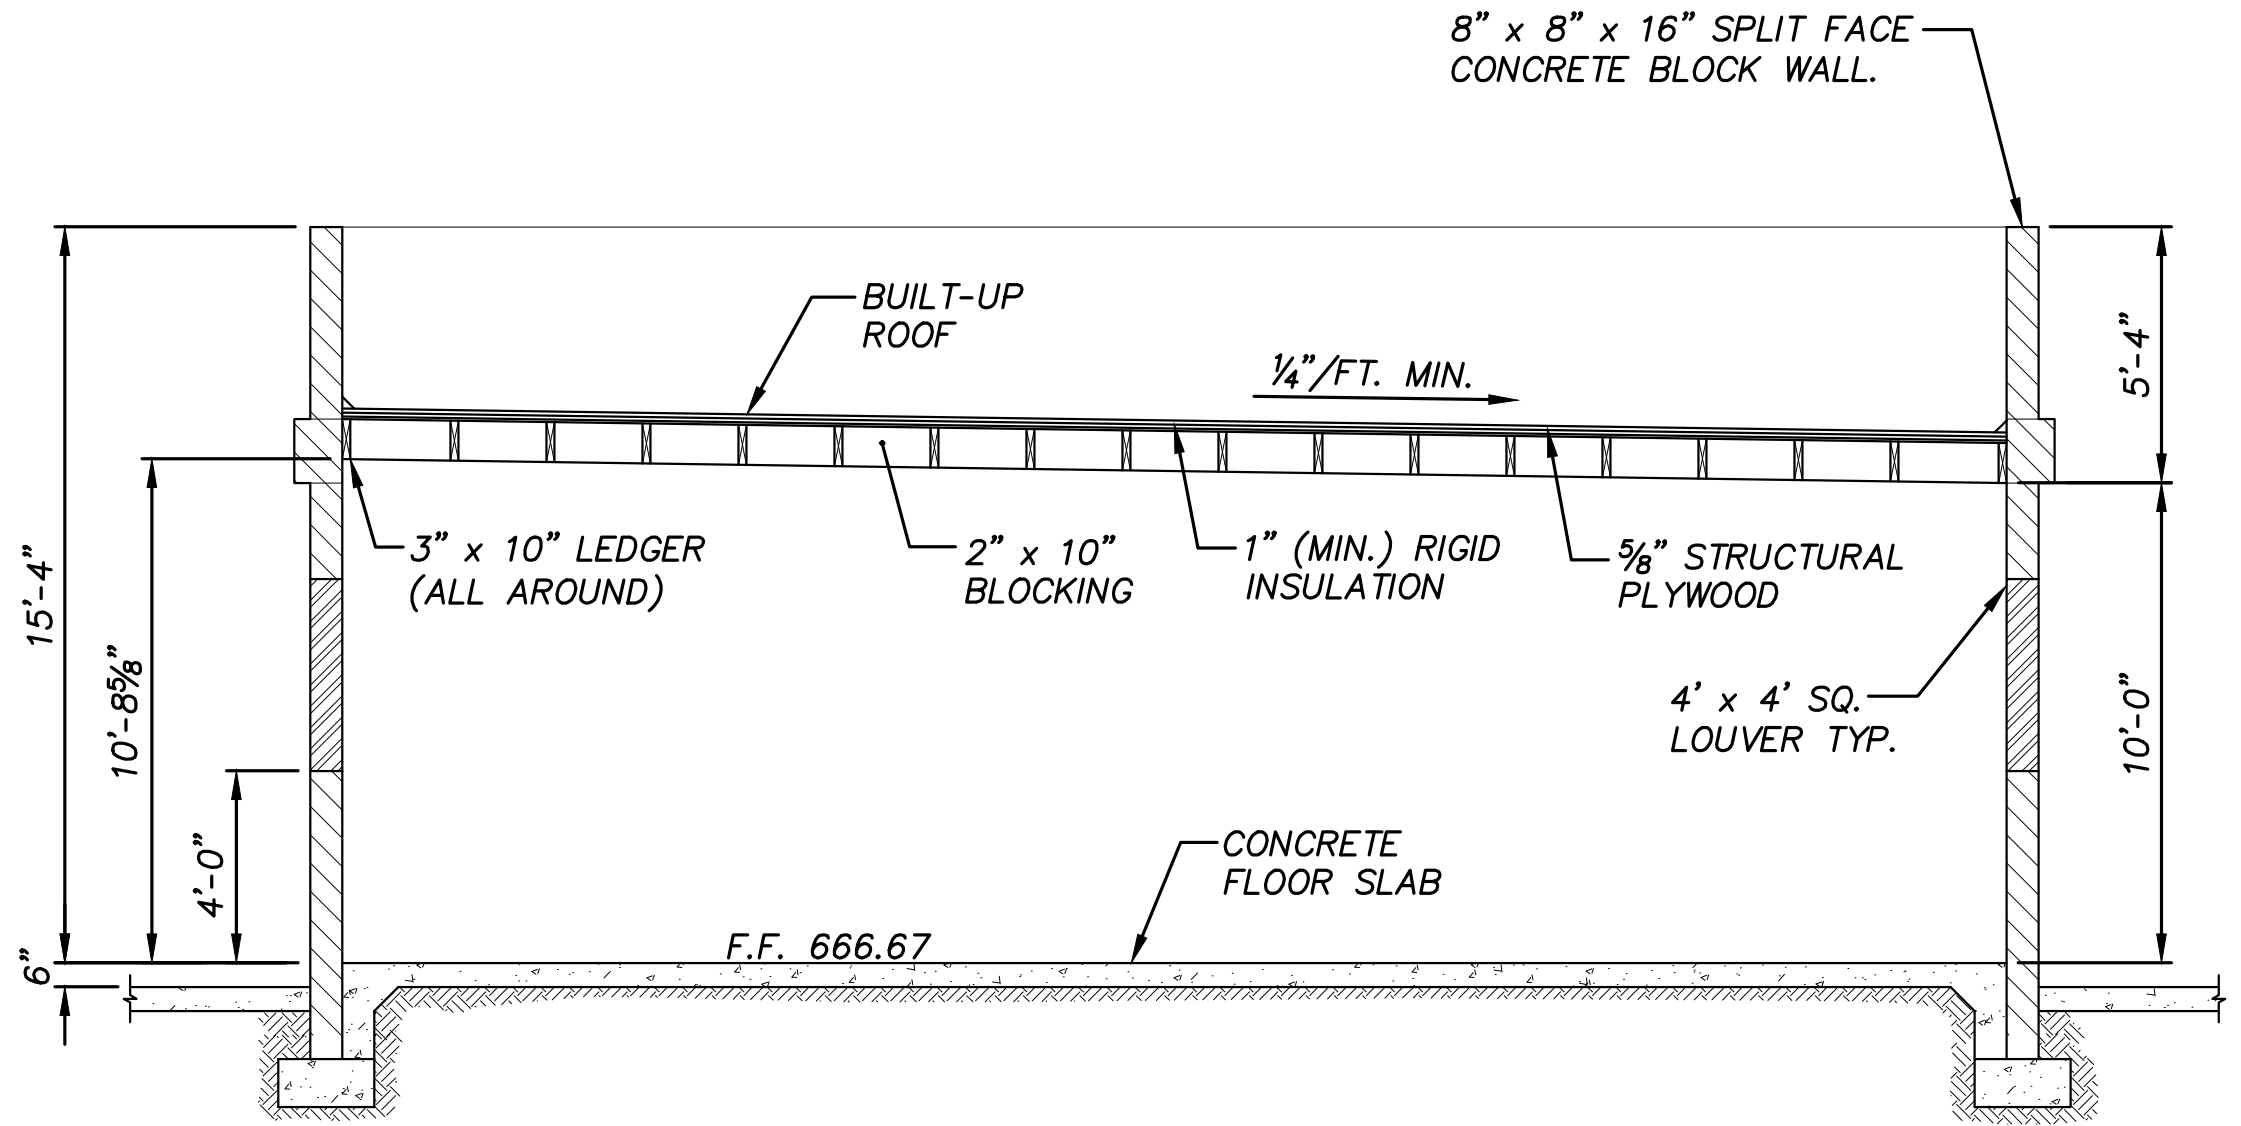

SECTION B
SCALE: 1/4" = 1'-0"

AKM JOB No. 0761209.00

Underground Service Alert
Call: TOLL FREE



TWO WORKING DAYS BEFORE YOU DIG

0 1/2 1 24x36 FORMAT
IF THIS BAR MEASURES 1" THEN
DRAWING SCALE IS AS NOTED
0 1/4 1/2 12x18 FORMAT
WARNING IF THIS BAR MEASURES
1/2" THEN DRAWING IS NOT FULL
SCALE AND IS 50% REDUCED

Designed by D. BAKER
Drawn by M.U. R.U.
Checked by G. HOBSON
PLANS PREPARED UNDER SUPERVISION OF
GARY J. HOBSON
Date JULY 2017 R.C.E. No. 40779

Reference Plans for
these Improvements

SHEET NOTES:

- PIPE AND WALL PENETRATION PER DETAIL 2 ON SHEET M-1.
- BALLISTIC GRADE GLASS BLOCK CITY FURNISHED.
- DOOR SHALL BE EQUIPPED WITH AN INTERIOR PANIC BAR, SEE SPECIFICATION SECTION 08710.
- LINTELS PER DETAIL 8 ON DRAWING S-3.
- PROVIDE AND INSTALL WIRE CAGE PROTECTION BY CHASE SECURITY SYSTEMS OR EQUAL FOR ALL EXTERIOR LIGHTS.



AKM CONSULTING ENGINEERS
553 WALD
IRVINE, CA. 92618
(949) 753-7333

Engineering _____
Operations _____

Department of Water and Power Approval
By: 8/4/2017
Vernon R. Weisman, P.E.
District Engineer
R.C.E. No. 41610


CITY OF CORONA - RESIN TREATMENT OF NITRATE SOURCES
WELLS 32 AND 33 EQUIPPING
BUILDING ELEVATIONS AND SECTIONS

Drawing No.
13-038U
A-2
Sht. 10 of 21



HATCH SCHEDULE			
HATCH	QUANTITY	SIZE	TYPE
ROOF/LADDER ACCESS	1	2'-6" x 3'-0"	TYPE "S", SINGLE LEAF, ALUMINUM
EQUIPMENT ACCESS	2	5'-0" x 5'-0"	TYPE "F", SINGLE LEAF, ALUMINUM


NOTE:
GENERAL CONTRACTOR TO COORDINATE BETWEEN CURB MANUFACTURER/
INSTALLER & EQUIPMENT MANUFACTURER/INSTALLER FOR EXACT OPENING SIZES,
UNIT CONFIGURATIONS AND LOCATION OF ADDITIONAL INSULATION.

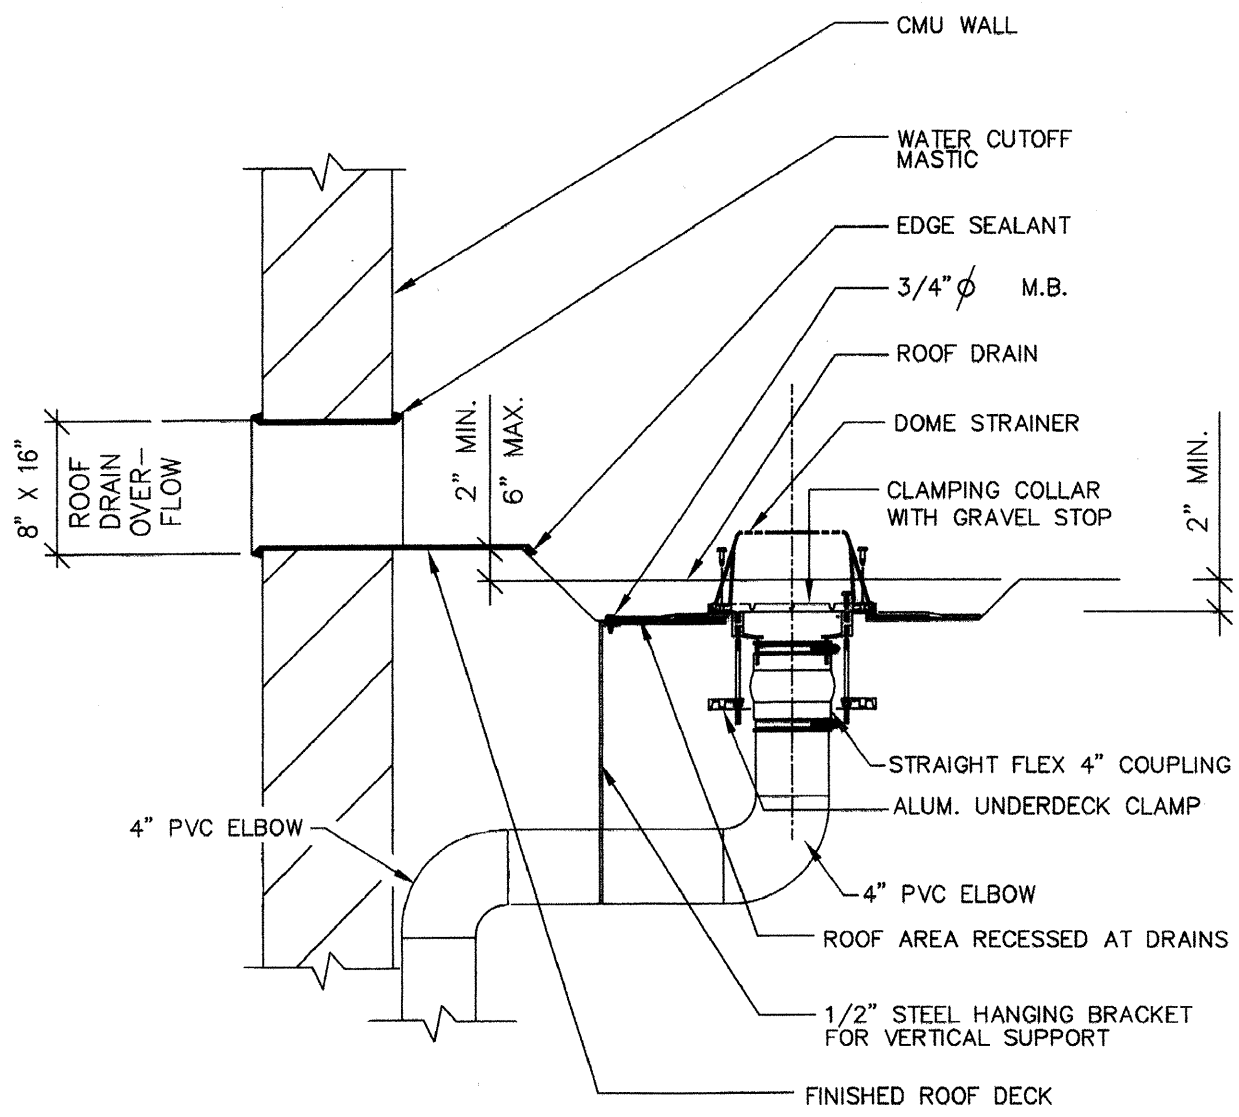

4" ROOF DRAIN AND SCUPPER

SCALE : N.T.S.


2
A-1

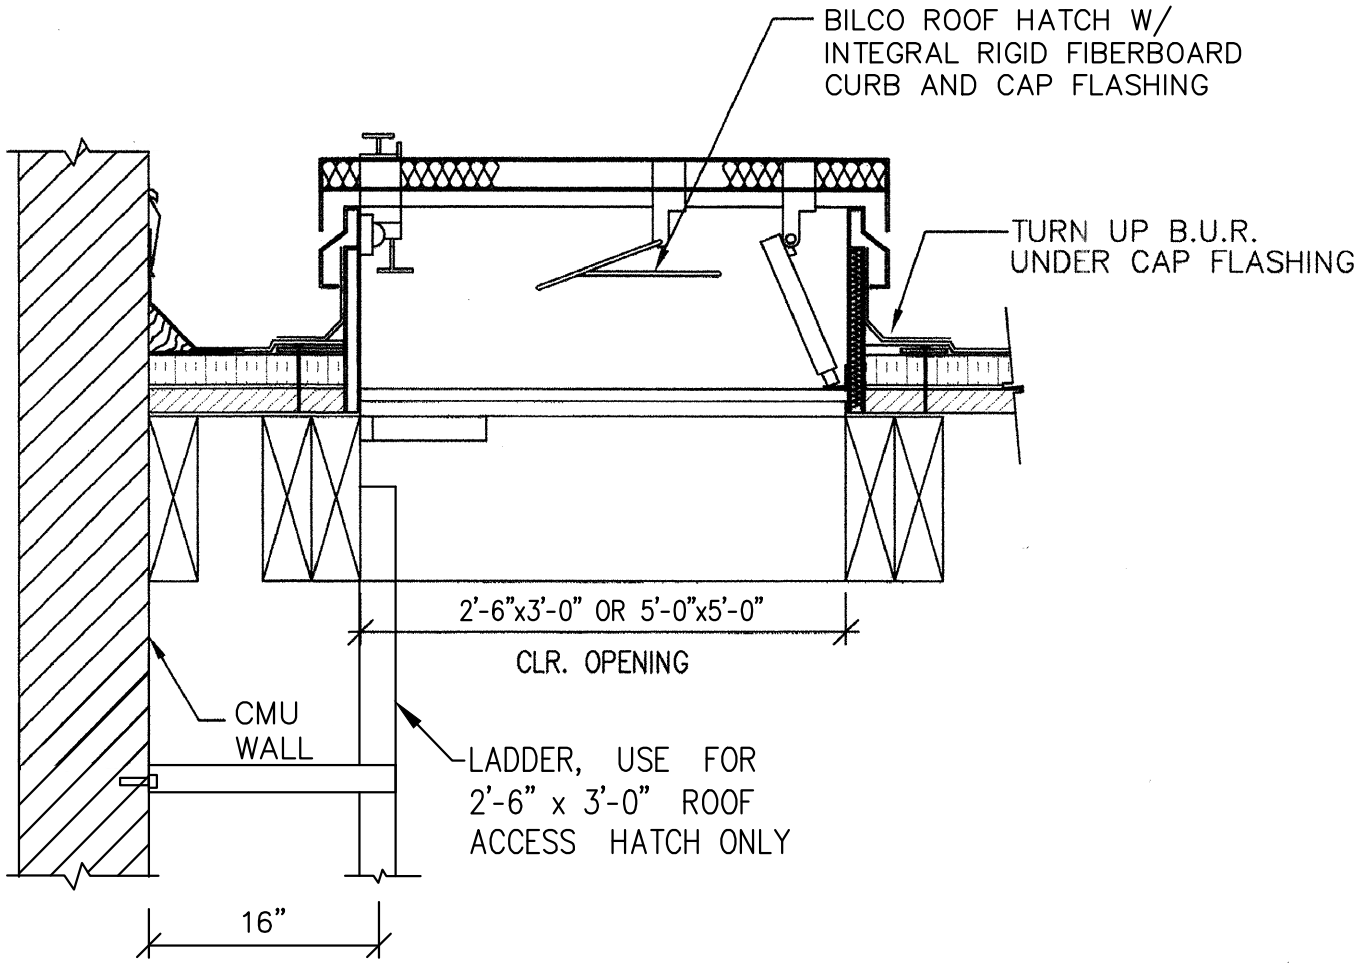

TYPICAL ROOF HATCH

N.T.S.


3
A-1

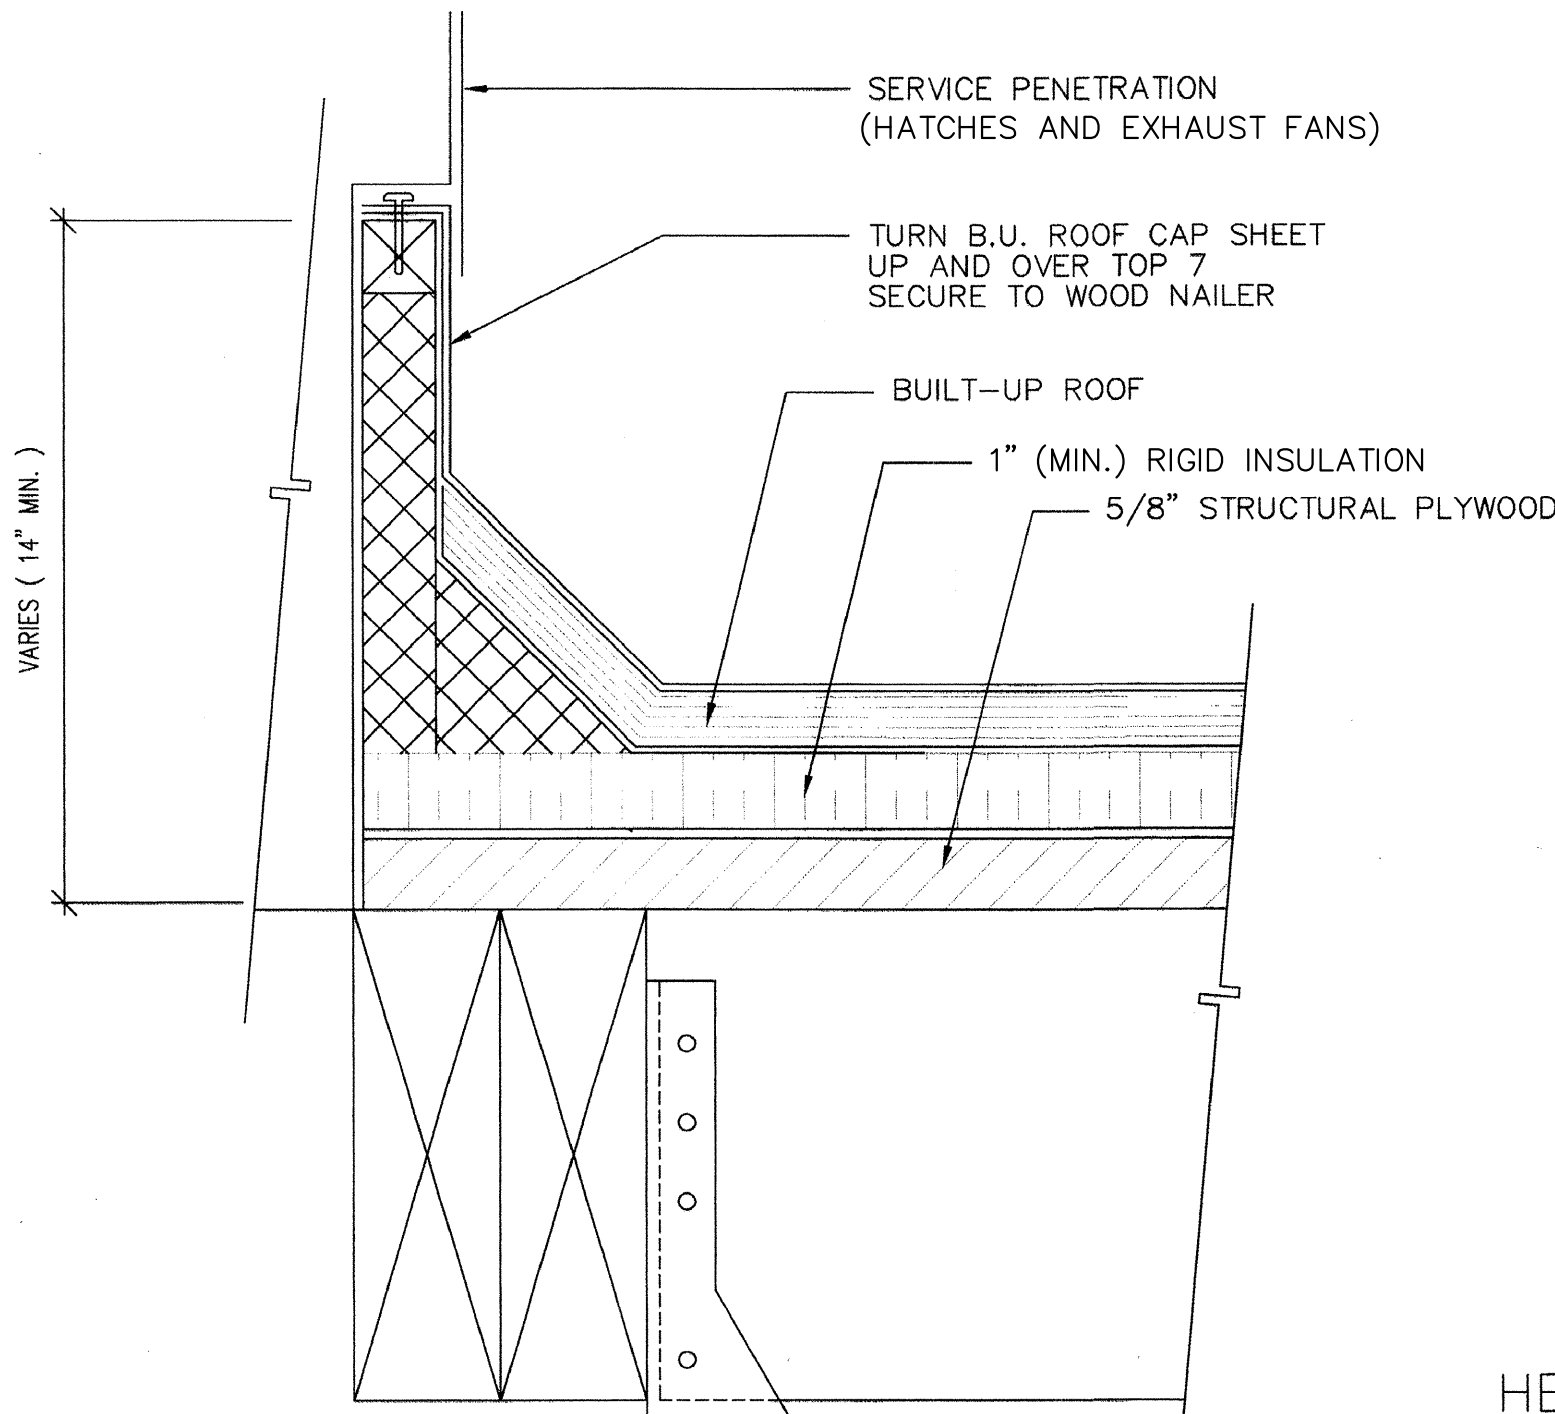

TYP. ROOF TOP CURB

N.T.S.

4
A-1

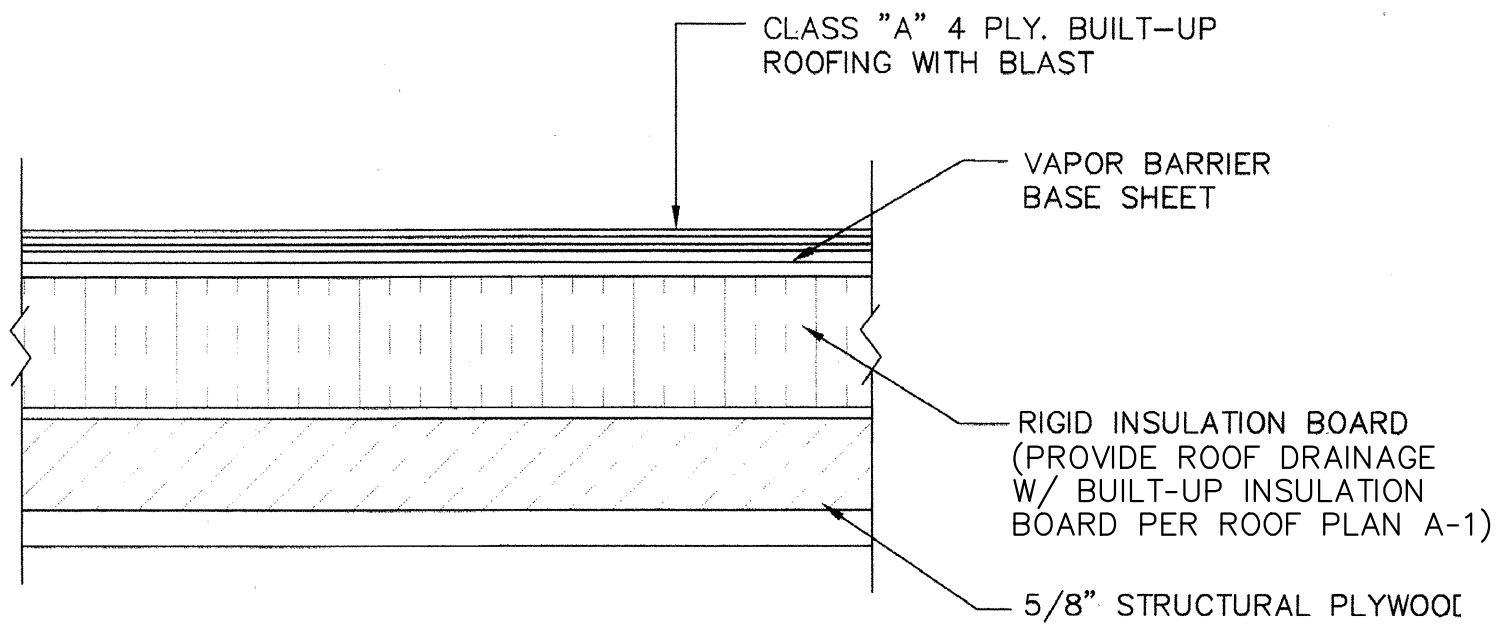


ROOF ASSEMBLY

N.T.S.

5
A-1

5
A-2

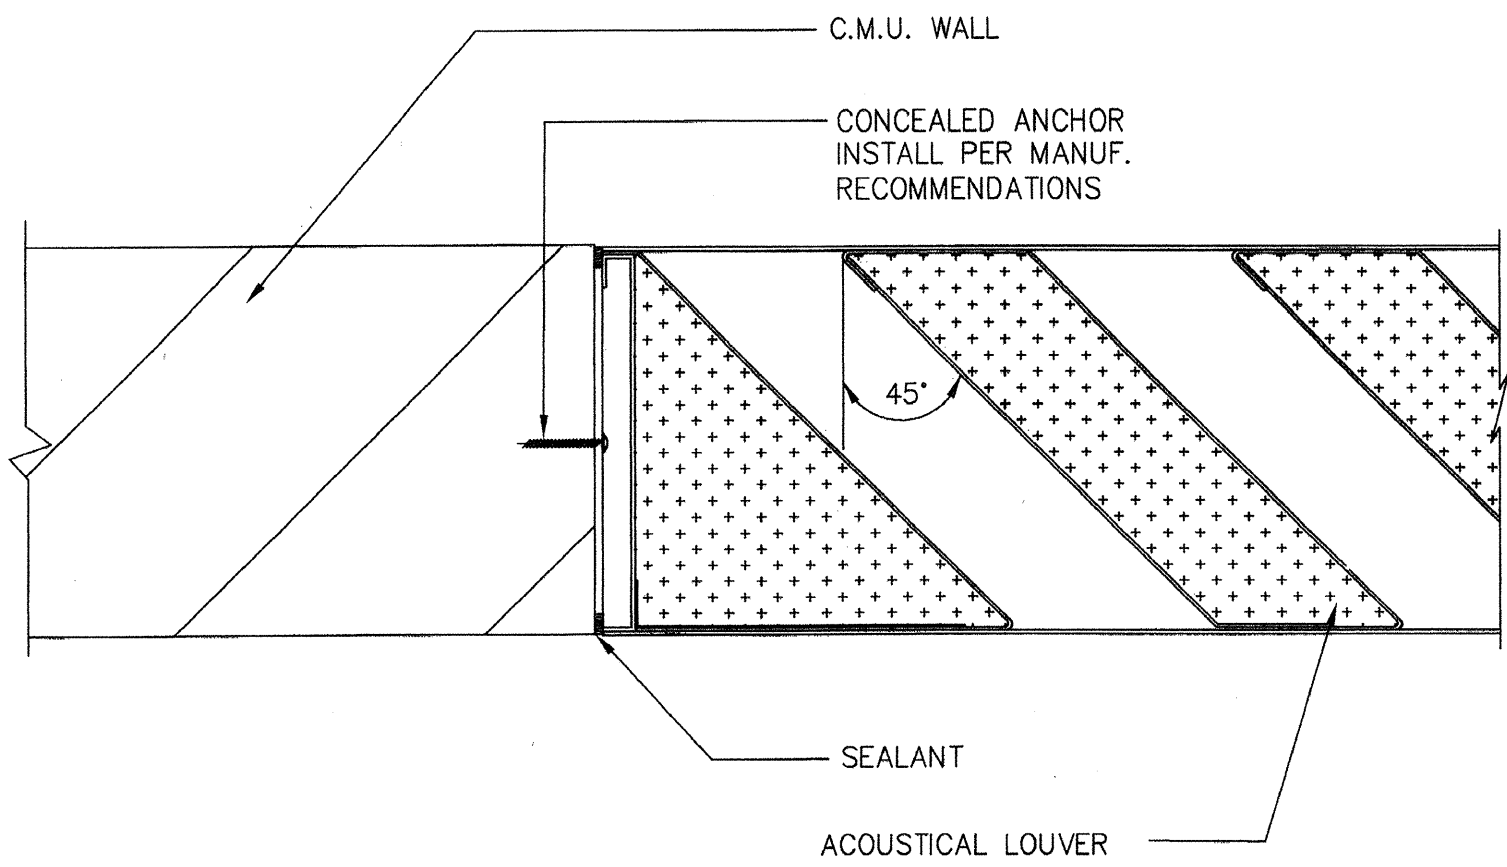


LOUVER JAMB

SCALE : 3" = 1'-0"

6
A-1


6
A-2

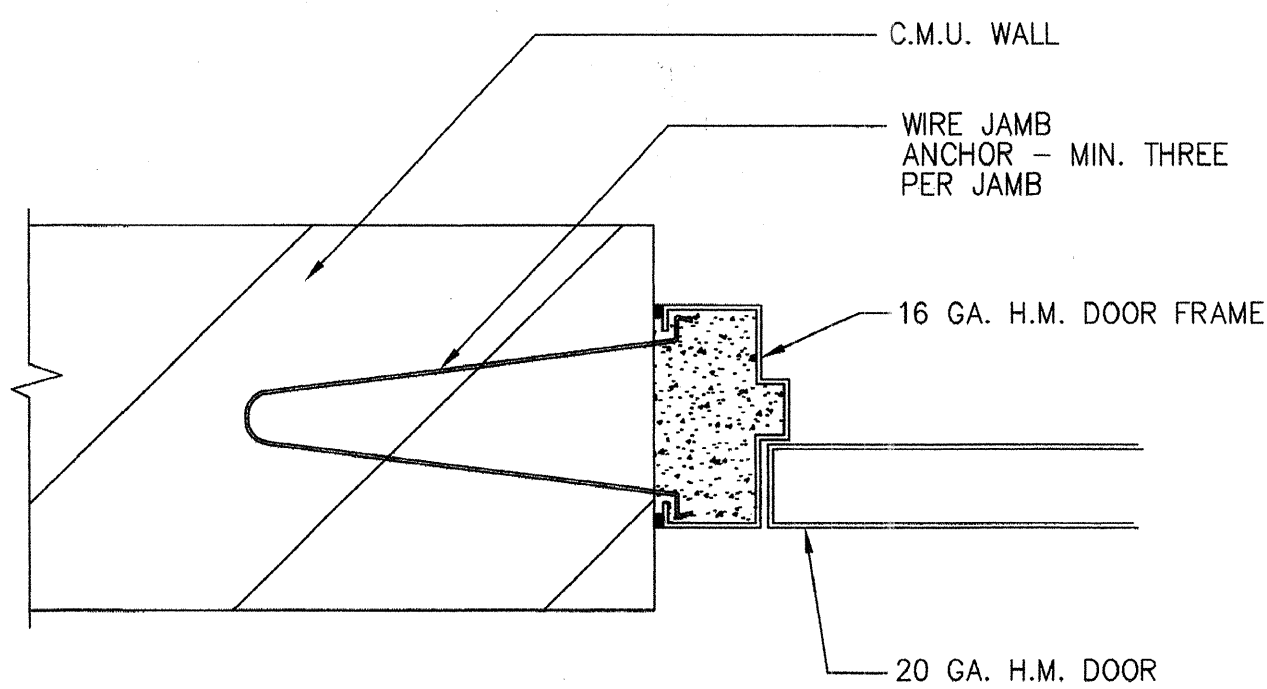

DOOR JAMB

SCALE : 3" = 1'-0"

7
A-1

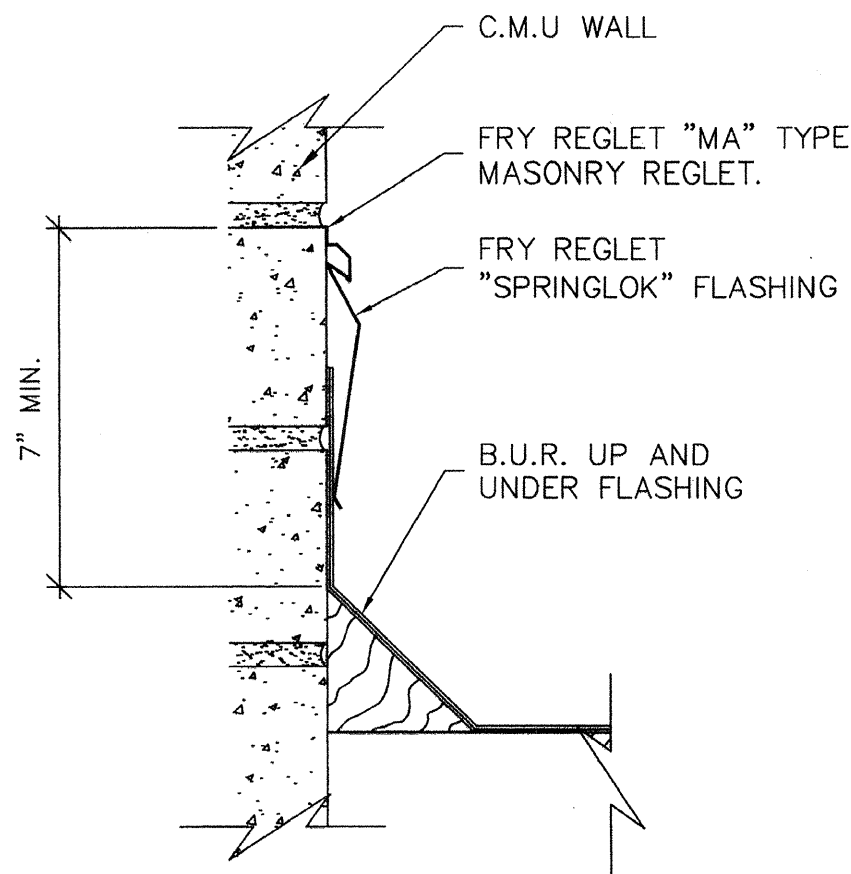


FLASHING

SCALE : 3" = 1'-0"


8
A-2

HEAD


SPACE DEFLECTION

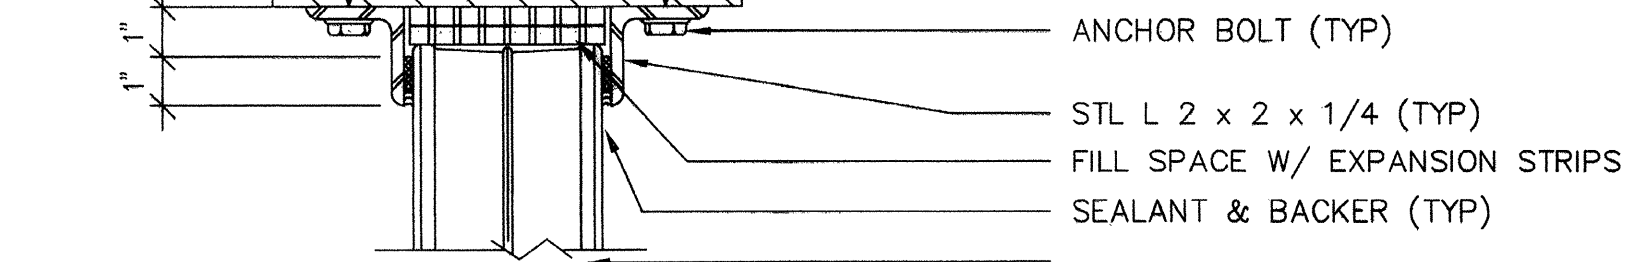

JAMB

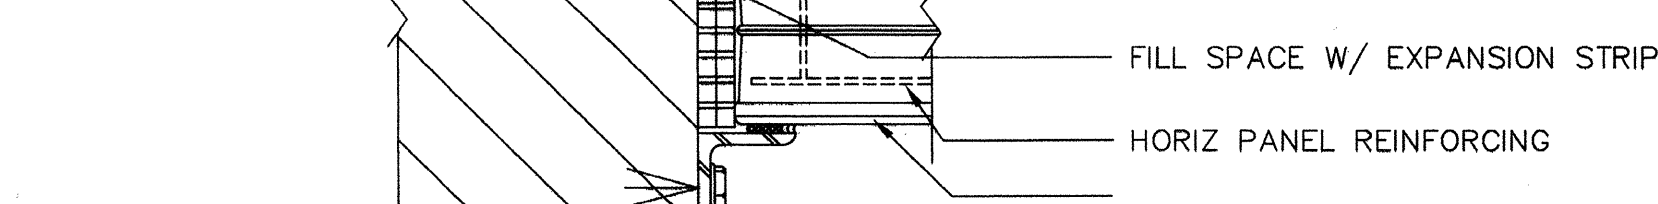

SILL

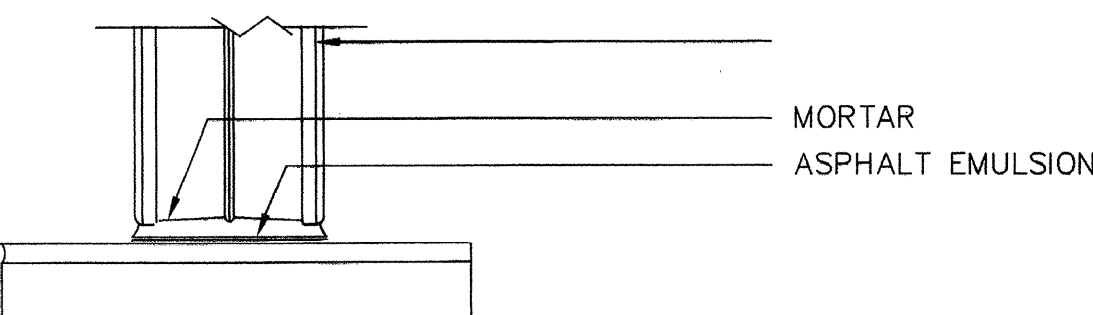

GLASS BLOCK

SCALE : 3" = 1'-0"

9
A-1

9
A-2



AKM JOB No. 0761209.00

Underground Service Alert
Call: TOLL FREE



TWO WORKING DAYS BEFORE YOU DIG

0 1/2 1 24x36 FORMAT
IF THIS BAR MEASURES 1" THEN
DRAWING SCALE IS AS NOTED
0 1/4 1/2 12x18 FORMAT
WARNING IF THIS BAR MEASURES
1/2" THEN DRAWING IS NOT FULL
SCALE AND IS 50% REDUCED

Designed by D. BAKER
Drawn by M.U. R.U.
Checked by G. HOBSON
PLANS PREPARED UNDER SUPERVISION OF
GARY J. HOBSON
Date JULY 2017 R.C.E. No. 40779

Reference Plans for
these Improvements

Date

By

REVISIONS

App'd



AKM CONSULTING ENGINEERS
553 WALD
IRVINE, CA. 92618
(949) 753-7333

Engineering
Operations

Department of Water and Power Approval
By: *[Signature]* 8/4/2017
Vernon R. Weisman, P.E.
District Engineer
R.C.E. No. 41610

CITY OF CORONA - RESIN TREATMENT OF NITRATE SOURCES
WELLS 32 AND 33 EQUIPPING
ARCHITECTURAL DETAILS

Drawing No.
13-038U
A-3
Sht. 11 of 21

STRUCTURAL NOTES

GENERAL

- ALL STRUCTURAL DRAWINGS SHALL BE USED IN CONJUNCTION WITH THE ARCHITECTURAL, MECHANICAL, ELECTRICAL, AND SHOP DRAWINGS AND THE PROJECT SPECIFICATIONS.
- CONSTRUCTION SHALL MEET THE REQUIREMENTS OF THE LATEST EDITION OF CALIFORNIA BUILDING CODE (CBC) THE CBC SHALL GOVERN EXCEPT WHERE OTHER APPLICABLE CODES OR THESE DOCUMENTS ARE MORE RESTRICTIVE.
- NOTHING SHOWN OR OMITTED FROM THESE DOCUMENTS SHALL RELIEVE THE CONTRACTOR FROM FULL COMPLIANCE WITH ALL APPLICABLE CODES AND ORDINANCES.
- THE CONTRACTOR ALONE IS RESPONSIBLE FOR JOB SITE SAFETY. SITE REVIEW OF THE CONSTRUCTION BY THE ENGINEER IS NOT ASSUMING ANY PROVISIONS OF SUPERVISION OF CONSTRUCTION METHODS OR PROCESSES.
- WITHOUT EXCLUSION OF ANY REFERENCE IN THE CONSTRUCTION DOCUMENTS TO ANY RULE OR REGULATION, THE ENGINEER IS NOT ASSUMING ANY PROVISIONS OF SUPERVISION OF CONSTRUCTION METHODS OR PROCESSES.
- STRUCTURES HAVE BEEN DESIGNED FOR OPERATIONAL LOADS ON THE COMPLETED STRUCTURES. DURING CONSTRUCTION, BRACING OR SHORING SHALL SUPPORT STRUCTURES WHEREVER EXCESSIVE CONSTRUCTION LOADS MAY OCCUR. BRACING AND SHORING REQUIREMENTS SHALL BE ACCEPTABLE TO THE ENGINEER.
- SEE ALL OTHER PROJECT DOCUMENTS FOR REGLETS, PIPE SLEEVES, CONDUITS OR OTHER ITEMS TO BE EMBEDDED OR PASSED THROUGH THE CONCRETE.
- PENETRATIONS THROUGH WALLS OR SLABS LESS THAN 12 INCHES IN DIAMETER MAY NOT BE SHOWN ON THE STRUCTURAL DRAWINGS. REFER TO ASSOCIATED DRAWINGS FOR LOCATIONS.
- THE MINIMUM CLEAR DISTANCE BETWEEN PIPE PENETRATIONS SHALL BE 3 TIMES THE DIAMETER OF THE PENETRATION OR 8 INCHES, WHICHEVER IS SMALLER.
- WRITTEN DIMENSIONS SHALL BE USED FOR CONSTRUCTION. DO NOT SCALE DRAWINGS.
- STRUCTURAL DIMENSIONS CONTROLLED BY OR RELATED TO MECHANICAL AND/OR ELECTRICAL EQUIPMENT SHALL BE VERIFIED BY THE CONTRACTOR PRIOR TO CONSTRUCTION.
- MECHANICAL AND ELECTRICAL EQUIPMENT SUPPORTS, ANCHORAGES, OPENINGS, RECESSES AND EMBEDMENTS NOT SHOWN ON THE DRAWINGS SHALL BE PROVIDED BY THE CONTRACTOR PRIOR TO PLACING CONCRETE.
- CONDUITS OR PIPING SHALL NOT BE PLACED IN THE PLANE OF CONCRETE WALLS, SLABS OR ROOFS.
- ALL DIMENSIONS SHALL BE FIELD VERIFIED BY THE CONTRACTOR. SHOULD CONFLICTS OR INTERFERENCE OCCUR, THEY SHALL BE RESOLVED WITH THE ENGINEER AT NO ADDITIONAL COST TO THE OWNER. EXISTING FIELD CONDITIONS AT VARIANCE WITH THE PLANS SHALL BE BROUGHT TO THE ATTENTION OF THE ENGINEER BEFORE ANY FURTHER WORK IS PERFORMED.
- USE PERTINENT STANDARD DETAILS SHOWN, EVEN THOUGH THEY MAY NOT BE CALLED OUT AT LOCATIONS WHERE THEY APPLY.
- CONDITIONS NOT SPECIFICALLY SHOWN OR INDICATED SHALL BE CONSTRUCTED SIMILAR TO DETAILS SHOWN FOR THE RESPECTIVE MATERIALS OR CONDITIONS.

SITE WORK

- ALL FOOTINGS SHALL BE FOUNDED A MINIMUM OF 24-INCHES BELOW THE LOWEST ADJACENT FINISH GRADE.
- EXCAVATION FOR FOUNDATIONS, TRENCHES, FOOTINGS, FLOOR SLABS, CONCRETE WALKS, CURBS AS SHOWN ON THE DRAWINGS. THE BOTTOMS OF ALL EXCAVATIONS SHALL BE LEVEL, TAMPED FIRM, CLEAN AND FREE FROM ALL DEBRIS OR FOREIGN MATTER.
- WHERE PRACTICABLE, SIDES OF FOOTINGS SHALL BE CUT NEAT AND CONCRETE POURED DIRECTLY AGAINST THE EXCAVATION. IF FORMING IS REQUIRED, THE TRENCHES SHALL BE EXCAVATED WIDE ENOUGH TO PERMIT THE ERECTION AND REMOVAL OF FORMS.
- PROVIDE ENGINEERING FILL BELOW FOOTING AND FLOOR SLAB. ENGINEERING FILL SHALL BE COMPACTED TO A MINIMUM OF 95 PERCENT RELATIVE COMPACTION AS DETERMINED BY ASTM TEST METHOD D1507.

SPECIAL INSPECTION

- UNLESS MODIFIED BY THIS NOTE, SPECIAL INSPECTION SHALL BE CONDUCTED IN ACCORDANCE WITH THE REQUIREMENTS SET FORTH IN CHAPTER 17 OF THE CBC. THE FOLLOWING ITEMS, AS A MINIMUM, SHALL RECEIVE SPECIAL INSPECTION:
 - BOLTS INSTALLED IN CONCRETE SHALL BE INSPECTED PRIOR TO AND DURING CONCRETE PLACEMENT.
 - ADHESIVE ANCHOR SYSTEMS - THE INSPECTOR SHALL RECORD DRILL BIT COMPLIANCE WITH ANSI B94.12-1977. HOLE DEPTH AND CLEANLINESS, PRODUCT DATA AND VERIFICATION OF ANCHOR INSTALLATION WITH THE MANUFACTURER'S PUBLISHED INSTRUCTIONS AND ESR EVALUATIONS REPORT.
 - CONCRETE - THE INSPECTOR SHALL SUPERVISE THE PREPARATION OF COMPRESSION TEST SPECIMENS, SLUMP TEST, AND BE PRESENT DURING PLACEMENT OF REINFORCED CONCRETE.
 - REINFORCING STEEL - THE INSPECTOR SHALL INSPECT THE REINFORCING STEEL SIZES, LOCATION AND SPACING PRIOR TO CLOSING THE FORMS OR DELIVERY OF CONCRETE TO JOBSITE.
 - WELDING- THE INSPECTOR SHALL INSPECT ALL STRUCTURAL WELDING DONE IN THE FIELD IN ACCORDANCE WITH SECTION 1704.3 OF CBC

SPECIAL INSPECTION

- NO SOILS REPORT HAS BEEN PREPARED EXPRESSLY FOR THIS PROJECT. DESIGN VALUES ARE BASED ON CBC TABLE 1806.2.
- BEFORE BEGINNING FOUNDATION EXCAVATION POTHOLE AND LOCATE ALL BURIED PIPING AND CONDUIT WHOSE PRESENCE:
 - IDENTIFIED BY UNDERGROUND SERVICE ALERT STAKING.
 - SHOWN ON PLANS OR
 - IS EVIDENT FROM MANHOLES, BOXES, PAVEMENT CUTS, STUBUPS, OR OTHER VISIBLE SURFACE FEATURES.
- IN THE EVENT FOUNDATION EXCAVATION IS CARRIED TO A DEPTH GREATER THAN REQUIRED, THE VEREXCAVATION SHALL BE BACKFILLED WITH THE SAME CONCRETE AS USED FOR THE FOOTING AT NO ADDITIONAL EXPENSE TO THE OWNER. DO NOT PLACE UNCONTROLLED FILL.
- KEEP FOUNDATION EXCAVATION CLEAR OF LOOSE MATERIAL AND STANDING WATER.
- UNLESS OTHERWISE NOTED, COMPACT BACKFILL FOR FOUNDATIONS AND IN UTILITY TRENCHES TO AT LEAST 95% OF MAXIMUM DENSITY PER ASTM D1557.
- SUBMIT COMPACTION REPORT TO BE APPROVED BY OWNER'S REPRESENTATIVE BEFORE PLACING ANY CONCRETE OR FILL.
- SLOPE FINISH GRADES TO DRAIN AWAY FROM BUILDINGS.

CONCRETE

- CONCRETE : ASTM C94, READY MIXED CONCRETE.
- CEMENT : ASTM C150, TYPE II OR V (PORTLAND CEMENT)
- AGGREGATES: ASTM C33 (NORMAL WEIGHT)
- ADMIXTURES: ASTM C260, AIR ENTRAINMENT
ASTM C618, POZZOLANS
- NO ADMIXTURES CONTAINING CHLORIDE SALTS PERMITTED.
MIN STRENGTH W/C
● 28 DAYS RATIO SLUMP
APPL. DESIGN:
STRUCTURAL 4000 PSI 0.45 4"
CONCRETE
NON-STRUCTURAL 2500 PSI 0.45 4"
FLY ASH IS NOT ALLOWED.
- MEASURE, MIX, TRANSPORT AND PLACE CONCRETE IN ACCORDANCE WITH ACI 304. CONFORM TO THE REQUIREMENTS OF ACI 301. MAX TEMPERATURE IN MIXER: 90 DEGREES F. MAX TIME IN MIXER: 1 1/2 HRS. CURING: PER ACI 308. TESTING: PER ASTM C39, ASTM C143
- SPACE CONTRACTION JOINTS AND CONSTRUCTION JOINTS FOR SLABS ON GRADE 15 FEET MAXIMUM IN EACH DIRECTION WITH MAXIMUM ASPECT RATIO OF 1.5 TO 1, U.N.O.
- CONSTRUCTION JOINTS, OTHER THAN THOSE SHOWN ON THE DRAWINGS, ARE NOT PERMITTED WITHOUT APPROVAL BY ENGINEER.
- SURFACES SHALL BE CLEAN AND FREE OF LAITANCE. PROVIDE 3/4" CHAMFERS AT EXPOSED CORNERS.
- SURFACES CALLED OUT ON THE DRAWINGS AS "ROUGHENED" SHALL BE RAKED TO A FULL AMPLITUDE OF 1/4".
- DRY PACK GROUT: HIGH STRENGTH, NON-SHRINK, METALLIC GROUT EQUIVALENT TO MASTER BUILDERS' EMBECCO 636, APPLIED PER MANUFACTURER'S RECOMMENDATIONS.
- FLOWABLE GROUT: HIGH STRENGTH, NON-SHRINK, NON-METALLIC GROUT EQUIVALENT TO MASTER BUILDER'S MASTERFLOW 713, WITH A MINIMUM COMPRESSIVE STRENGTH OF 5000 PSI, APPLIED PER MANUFACTURER'S RECOMMENDATIONS.

CONCRETE REINFORCING

- NEW BILLET STEEL (TYPE N OR S) PER ASTM A615, OR A706 GRADE 60.
- WELDING: PER AWS D1.4. NO TACK WELDING OF REINFORCING BARS PERMITTED WITHOUT APPROVAL BY ENGINEER.
- BAR EMBEDMENT: FOR DEVELOPMENT LENGTH OF STRAIGHT AND HOOKED BARS IN TENSION, PER ACI-318, U.N.O.
- WELDED WIRE FABRIC: SMOOTH - PER ASTM A185, DEFORMED - PER ASTM A497.
- DETAILING: ACI 315 FABRICATION & PLACING: CRSI MANUAL OF STD. PRACTICE.
- PROVIDE BENT CORNER BARS TO MATCH & LAP HORIZONTAL REINFORCEMENT AT CORNERS AND INTERSECTIONS OF WALLS, BEAMS AND FOOTINGS.
- CONCRETE PROTECTION FOR REINFORCING: CONCRETE CAST AGAINST EARTH: 3" CONCRETE EXPOSED TO EARTH OR WEATHER: #6 AND LARGER 2" #5 AND SMALLER 2" CONCRETE NOT EXPOSED TO EARTH OR WEATHER: SLABS, WALLS, JOISTS 2" BEAMS, COLUMNS: PRIMARY REINFORCEMENT, TIES, STIRRUPS, SPIRALS 2"
- REINFORCING IN CONCRETE PLACED AGAINST EARTH WITHOUT FORMS SHALL BE SUPPORTED BY CONCRETE BLOCK, APPROVED NON-METALLIC CHAIRS, OR ANOTHER METHOD APPROVED BY THE ENGINEER. SECURELY TIE ALL REINFORCING, INCLUDING DOWELS, PRIOR TO PLACING CONCRETE.

MASONRY

- CONCRETE MASONRY UNITS: ASTM C90, GRADE N-1, NET AREA COMPRESSIVE STRENGTH 1900 PSI AT 28 DAYS.
- MORTAR: ASTM C270, TYPE S, 1800 PSI AT 28 DAYS.
- GROUT: ASTM C476 COMPRESSIVE STRENGTH 2000 PSI AT 28 DAYS WITH COARSE AGGREGATE, AND NOT LESS THAN A 6-3/4 SACK MIX, SLUMP 8"(+/-). NO FLY ASH OR ADMIXTURES CONTAINING CHLORIDES PERMITTED.
- SPECIFIED COMPRESSIVE STRENGTH OF MASONRY, FM = 1500 PSI. SPECIAL INSPECTION SHALL BE PROVIDED DURING MASONRY CONSTRUCTION.
- LAY BLOCK IN RUNNING BOND.
- COMPLETE GROUTING OF ANY SECTION OF WALL IN ONE DAY WITH NO INTERRUPTIONS GREATER THAN ONE HOUR.
- GROUT BOND BEAMS, LINTELS AND REINFORCED CELLS. GROUT UNREINFORCED CELLS AS NOTED ON THE DRAWINGS. GROUT ALL CELLS SOLID IN MASONRY BELOW GRADE.
- REINFORCE AND GROUT AROUND EMBEDDED ITEMS PER STRUCTURAL DRAWINGS. SECURE EMBEDDED STRUCTURAL ITEMS IN PROPER POSITION BEFORE GROUTING. EMBED ANCHOR BOLTS IN REINFORCED GROUTED CELLS.
- HOLD GROUT 1-1/2" BELOW A MORTAR JOINT TO FORM A "GROUT KEY" WITH POUR ABOVE WHERE BOND BEAMS OCCUR, STOP GROUT POUR A MINIMUM OF 1/2 INCH BELOW TOP OF MASONRY.
- USE MECHANICAL VIBRATOR FOR GROUT POURS OVER 12 INCHES; GROUT POURS LESS THAN 12 INCHES MAY BE PUDDLED.
- MAXIMUM GROUT LIFT= 5'-0".
- HORIZONTAL GROUT STOP IN BOND BEAMS TO BE METAL LATH OR FIBERGLASS.
- LINTELS: AS NOTED ON DRAWINGS. USE OPEN-ENDED BLOCKS FOR MASONRY LINTELS WITH SPANS GREATER THAN 6'-0".

MASONRY REINFORCING

- BARS: NEW BILLET (TYPE N OR S) PER ASTM A615 OR A706, GRADE 60.
- WELDING: AWS 1.4. NO WELDING OF GRADE 60 BARS IS PERMITTED WITHOUT PRIOR APPROVAL BY ENGINEER.
- BAR LAP : 40 BAR DIAMETERS, U.N.O. FABRICATION: PER CRSI MANUAL OF STD. PRACTICE.
- SECURE VERTICALS IN PROPER POSITION PRIOR TO GROUTING WITH WIRE POSITIONERS AT INTERVALS NOT EXCEEDING 200 BAR DIAMETERS NOR 10 FEET.
- DETAILING: ACI 531, CHAPTER 8.
- VERTICAL REINFORCEMENT: AS NOTED ON THE DRAWINGS AND A MINIMUM OF ONE #5 VERTICAL CONTINUOUS AT ALL WALL ENDS, CORNERS AND INTERSECTIONS. EACH SIDE OF OPENINGS AND CONTROL JOISTS AND AT 48" O.C. MAXIMUM SPACING ELSEWHERE. VERTICAL REINFORCEMENT WHICH IS INTERRUPTED BY POCKETS OR OPENINGS SHALL BE MADE CONTINUOUS EACH SIDE.
- HORIZONTAL REINFORCEMENT: AS NOTED ON THE DRAWINGS AND A MINIMUM OF ONE #4 HORIZONTAL AT 48" O.C. MAXIMUM SPACING. USE TWO #4 CONTINUOUS IN BOND BEAMS, U.N.O.
- BOND BEAM REINFORCING INTERRUPTED BY POCKETS OR OPENINGS SHALL BE MADE CONTINUOUS ABOVE AND BELOW.

CONCRETE ANCHORS

- CAST-IN ANCHOR BOLTS SHALL CONFORM TO ASTM A307.
 - ADHESIVE ANCHORS SHALL CONFORM TO MANUFACTURER'S RECOMMENDATIONS AND THE APPROPRIATE ICBO REPORTS. ANCHORS WITHOUT APPROPRIATE ICBO REPORTS SHALL NOT BE USED.
 - CONTRACTOR SHALL LOCATE EXISTING REBAR USING NON-DESTRUCTIVE METHODS PRIOR TO DRILLING HOLES FOR ADHESIVE ANCHORS. ADJUST SPACING OF ANCHORS TO MISS EXISTING REINFORCING. TOTAL NUMBER OF ANCHORS PROVIDED SHALL BE EQUAL TO WHAT IS SHOWN ON THE DRAWINGS.
 - ADHESIVE ANCHORS SHALL CONSIST OF A TWO-COMPONENT RESIN ADHESIVE. THE PACKAGES CONTAINING EACH COMPONENT SHALL BE ATTACHED TO A DISPENSING MANIFOLD. AN AUGER STYLE NOZZLE SHALL BE ATTACHED FOR PROPER MIXING OF THE ADHESIVE COMPONENTS. WHERE THREADED RODS ARE REQUIRED, RODS SHALL CONFORM TO ASTM A193 GRADE B7, WHERE SST IS CALLED FOR ON THE DRAWINGS, CONTRACTOR SHALL USE ALLOY GROUP 1 TYPE 304 CONDITION CW.
- FINISHING, CURING AND PATCHING**
- AS SOON AS CONCRETE IN SLABS HAS SET SUFFICIENTLY TO BE WORKABLE, IT SHALL BE HAND FLOATED WITH A WOOD FLOAT. FINAL TROWELING OF THE INTERIOR SHALL BE DONE WITH A STEEL TROWEL EXCEPT WHERE DRAWINGS SPECIFICALLY CALL FOR OTHER TYPE OF FINISH. ALL EXTERIOR SLABS, SHALL BE GIVEN A LIGHT BROOM NON-SLIP FINISH UNLESS OTHERWISE NOTED ON THE DRAWINGS.
 - FINISHED SURFACES OF ALL SLABS AND PANELS SHALL BE TRUE AND FLAT IN ACCORDANCE WITH ELEVATIONS AND SLOPES SHOWN ON THE DRAWINGS. THE MAXIMUM VARIATION ALLOWED FROM THE SPECIFIED SLOPES AND SURFACES SHALL BE 1/8 INCH WITH NOT MORE THAN 1/8-INCH VARIATION IN ANY 10-FOOT LENGTH.
 - CONCRETE SLABS AND PANELS SHALL BE CURED BY MEANS OF AN APPROVED CURING COMPOUND APPLIED IN ACCORDANCE WITH THE MANUFACTURER'S INSTRUCTION.

STRUCTURAL AND MISCELLANEOUS STEEL

- STRUCTURAL SHAPES, PLATES AND BARS SHALL CONFORM TO ASTM A36.
- MACHINE BOLTS (MB) SHALL CONFORM TO ASTM A307.
- STEEL PIPE COLUMN SHALL CONFORM TO ASTM A53, GRADE B.
- STEEL TUBE SHALL CONFORM TO ASTM A500, GRADE B.
- ALL WELDING SHALL BE DONE IN ACCORDANCE WITH THE LATEST EDITION OF THE STRUCTURAL WELDING CODE OF THE AWS (D1.1) AND THE CALIFORNIA BUILDING CODE (1701). ALL WELDING SHALL BE PERFORMED BY CERTIFIED WELDERS.
- ALL WELDING ELECTRODES SHALL CONFORM TO ASTM E70XX. ALL WELDING SHALL BE DONE WITH LOW HYDROGEN ELECTRODES OR USING A LOW HYDROGEN WELDING PROCESS.
- ALL BOLT HOLES SHALL BE PUNCHED OR DRILLED (REAMED). BURNING OF HOLES IS NOT ACCEPTABLE.
- SHOP DRAWINGS SHALL BE SUBMITTED FOR REVIEW BY THE ENGINEER PRIOR TO FABRICATION.
- ALL STRUCTURAL STEEL SHALL BE GALVANIZED AFTER FABRICATION
- THE DESIGN, FABRICATION, ERECTION AND QUALITY CONTROL OF STRUCTURAL STEEL SHALL BE IN ACCORDANCE WITH AISC 360-05, AISI, MANUAL OF STEEL CONSTRUCTION, THIRTEEN EDITION AND CBC SECTION 2205.

STRUCTURAL OBSERVATION

- STRUCTURAL OBSERVATION SHALL BE CONDUCTED FOR THE STRUCTURAL SYSTEM IN ACCORDANCE WITH THE CALIFORNIA BUILDING CODE, SECTION 1709.
- STRUCTURAL OBSERVATION IS THE VISUAL OBSERVATION AT THE CONSTRUCTION SITE OF THE ELEMENTS AND CONNECTIONS OF THE STRUCTURAL SYSTEM AT SIGNIFICANT CONSTRUCTION STAGES AND THE COMPLETE STRUCTURE FOR GENERAL CONFORMANCE TO THE APPROVED PLANS AND SPECIFICATIONS. STRUCTURAL OBSERVATION DOES NOT WAIVE THE RESPONSIBILITY FOR THE INSPECTIONS REQUIRED OF THE BUILDING INSPECTOR OR THE DEPUTY INSPECTOR.
- THE FOLLOWING SIGNIFICANT CONSTRUCTION STAGES SHALL RECEIVE STRUCTURAL OBSERVATION:

CONSTRUCTION STAGE

- | CONSTRUCTION STAGE | ELEMENTS/CONNECTIONS TO BE OBSERVED |
|----------------------------------|---|
| a) FOUNDATION AND ROOF- CONCRETE | FOOTING REINFORCING STEEL AND DOWELS |
| b) BOLTS | ALL BOLTS INSTALLED IN CONCRETE |
| c) STEEL | REINFORCING STEEL |
| d) SOIL | SOIL COMPACTION TEST RESULT, BEARING VALUES |

DESIGN CRITERIA

- ROOF LIVE LOAD 20 psf
- WIND DESIGN DATA BASIC WIND SPEED 110 mph (11.20 psf) WIND EXPOSURE B
- EARTHQUAKE DESIGN DATA BUILDING CODE REFERENCE DOCUMENT ASCE 7-10 STANDARD 33-7774W LONGITUDE 117.52142°W LATITUDE 1.614 °N MAPED S1 0.691 °G SITE CLASS D SEISMIC DESIGN CATEGORY D BEARING WALL SYSTEM SPECIAL REINFORCED MASONRY SHEER WALLS 0.3352 S EQUIVALENT LATERAL FORCE PROCEDURE II OCCUPANCY (PER CBC 2013) U IMPORTANCE FACTOR 1.0 SITE SOIL D (1500 psf BA)

ABBREVIATIONS

AB	DIAMETER	f'c	CONCRETE COMPRESSIVE STRENGTH	P/F PL	PREMOLDED JOINT FILLER	
AB	ANCHOR BOLT	f'm	MASONRY PRISM STRENGTH	PL	PLATE	
ADDL	ADDITIONAL	FAB	FABRICATE (OR, ED)	FM	FIBERGLASS REINFORCED METAL	
AL	ALUMINUM	FD	FLOOR DRAIN	FM	PRECAST	
ALTERNATE	ALTERNATE(NG)	FDN	FOUNDATION	PT	PREFAB	
ANCH	ANCHOR	FHMS	FLATHEAD MACHINE SCREW	PREST	PRESSURE TREATED	
APPROX	APPROXIMATE(LY)	FHWS	FLATHEAD WOOD SCREW	REIN	POLYVINYL CHLORIDE	
ARND	AROUND	FIG	FIGURE	REOD	RECON	
B TO B	BACK TO BACK	FIN	FINISH (ED)	R	RISER	
BLDG	BUILDING	FL	FLOOR	RM	ROOM	
BULK	BLOCK(NG)	FLX	FLEXIBLE	RO	RADIUS	
BA	BEAM	FRC	FIBERGLASS REINFORCED	RAD	REINFORCED CONCRETE	
BOTTOM	BOTTOM OF	FRP	FIBERGLASS REINFORCED	REF	REFERENCE / REFER	
BOT	BOTTOM	FTG	FOOTING	REIN	REINFORCE (D, ING)	
BOT	BOTTOM	FURN	FURNISHED	REQD	REQUIRED	
BETW	BETWEEN	GA	GAGE	REVS	REVISION	
C TO C	CENTER TO CENTER	GALVS	GALVANIZED	RM	ROUGH OPENING	
CHKD	CHECKED	GEN	GENERAL	RO	RIGHT	
CIRC	CIRCUMFERENTIAL	GR	GRATING	SCHED	SCHEDULE	
OR	CONSTRUCTION JOINT	GRTG	GRATING	SECT	SECTION	
CL	CENTERLINE	H.A.S.	HEADED ANCHOR STUD	SHT	SHEET	
CLG	CEILING	HDR	HEADER	SIM	SIMILAR	
CLJ	CONTROL JOINT	HDWD	HARDWOOD	SLT	SLANT	
CLKG	CULKING	HDRP	HARDWARE	SPC	SPEC	
CLR	CLEAR	HNGR	HANGER	SQ	SQUARE	
CONC	CONCRETE	HNT	HIGHT	SST	STAINLESS STEEL	
CONC	CONCRETE	HM	HOLLOW METAL	STR	STIRRUP (S)	
CONV	CONNECTION	HOR	HORIZONTAL	STD	STANDARD	
CONST	CONSTRUCTION	HPT	HIGH POINT	STF	STIFFENER	
CONT	CONTINUOUS	HR	HANDRAIL	STRUC	STRUCTURE (S,URAL)	
CRS	COURSE(S)	ID	INSIDE DIAMETER	INT	INTERIOR	
CSK	COUNTERSINK	I.F.	INSIDE FACE	INVT	INVERT	
CTR	CENTER (ED)	INFO	INFORMATION	INT	INTERIOR	
CW	COLD WORKED	INVT	INVERT	INT	INTERIOR	
D	DEEP, DEPTH	JOINT	JOINT	T	TREAD (S)	
d	PENNY	JOINT FILLER	JOINT FILLER	T&B	TOP AND BOTTOM	
DEMO	DEMOLITION	LG	LONG	T&G	TONGUE AND GROOVE	
DET	DETAIL	LLH	LONG LEG HORIZONTAL	TD	TRENCH DRAIN	
DF	DOUGLAS FIR	LLV	LONG LEG VERTICAL	THD	THREADED	
DIA	DIAMETER	LNTL	LINTEL	THK	THICK (NESS)	
DIAG	DIAGONAL	LONG	LONG	TJ	TOOLED JOINT	
E	EACH	MAS	MASONRY	TRNSV	TRANSVERSE </tr <tr><td>EA</td><td>EACH</td><td>MATL</td><td>MATERIAL</td><td>TYP</td><td>TYPICAL</td></tr> <tr><td>ECC</td><td>ECCENTRIC</td><td>MAX</td><td>MAXIMUM</td><td>UN</td><td>UNLESS NOTED OTHERWISE</td></tr> <tr><td>ED</td><td>EQUIPMENT DRAIN</td><td>MB</td><td>MACHINE BOLT</td><td>VB</td><td>VAPOR BARRIER</td></tr> <tr><td>EF</td><td>EACH FACE</td><td>MCJ</td><td>MASONRY CONTROL JOINT</td><td>VERT</td><td>VERTICAL</td></tr> <tr><td>EL</td><td>ELEVATION</td><td>MFR</td><td>MANUFACTURER</td><td></td><td></td></tr> <tr><td>EM</td><td>EMBEDMENT</td><td>MIN</td><td>MINIMUM</td><td></td><td></td></tr> <tr><td>EMBED</td><td>EMBEDMENT</td><td>MO</td><td>MASONRY OPENING</td><td></td><td></td></tr> <tr><td>EQT</td><td>EQUIPMENT</td><td>MTL</td><td>METAL</td><td></td><td></td></tr> <tr><td>EQUIV</td><td>EQUIVALENT</td><td>NIC</td><td>NOT IN CONTRACT</td><td></td><td></td></tr> <tr><td>ES</td><td>EACH SIDE</td><td>NOM</td><td>NOMINAL</td><td></td><td></td></tr> <tr><td>ETC</td><td>ETCETERA</td><td>NSG</td><td>NON-SHRINK GROUT</td><td></td><td></td></tr> <tr><td>EW</td><td>EACH WAY</td><td>NTS</td><td>NOT TO SCALE</td><td></td><td></td></tr> <tr><td>EXP</td><td>EXPANSION</td><td>O/E</td><td>OR EQUAL</td><td></td><td></td></tr> <tr><td>EXP JT</td><td>EXPANSION JOINT</td><td>OC</td><td>ON CENTER</td><td></td><td></td></tr> <tr><td>EXST</td><td>EXISTING</td><td>OD</td><td>OUTSIDE DIAMETER</td><td></td><td></td></tr> <tr><td>EXT</td><td>EXTERIOR</td><td>O.F.</td><td>OUTSIDE FACE</td><td></td><td></td></tr> <tr><td>EX</td><td>EXTERIOR</td><td>OPNG(S)</td><td>OPENING(S)</td><td></td><td></td></tr> <tr><td></td><td>EPOXY</td><td>OPP</td><td>OPPOSITE</td><td></td><td></td></tr> <tr><td></td><td></td><td>OPP HD</td><td>OPPOSITE HAND</td><td></td><td></td></tr> <tr><td></td><td></td><td>OPT</td><td>OPTION (AL)</td><td></td><td></td></tr>

ABBREVIATION NOTES:

- ABBREVIATIONS AND DESIGNATIONS FOR STEEL MEMBERS MAY BE FOUND IN THE CURRENT MANUAL OF STEEL CONSTRUCTION BY AISC.
- ABBREVIATIONS OF TECHNICAL SOCIETIES AND TRADE ASSOCIATIONS MAY BE FOUND IN THE SPECIFICATIONS
- WELDING SYMBOLS AND ABBREVIATIONS MAY BE FOUND IN AWS 2.4.
- ABBREVIATIONS LISTED ARE FOR USE WITH STRUCTURAL DRAWINGS ONLY. SOME ABBREVIATIONS LISTED MAY NOT BE USED ON THE PLANS.


AKM JOB No. 0761209.00

Underground Service Alert

Call: TOLL FREE



TWO WORKING DAYS BEFORE YOU DIG

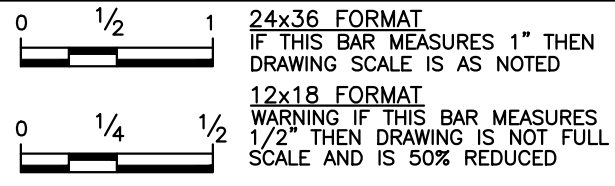

Designed by D. BAKER	Drawn by M.U. R.U.	Checked by G. HOBSON
PLANS PREPARED UNDER SUPERVISION OF GARY J. HOBSON R.C.E. No. 40779		
Date JULY 2017		

Reference Plans for these Improvements

REVISIONS



AKM CONSULTING ENGINEERS
553 WALD
IRVINE, CA. 92618
(949) 753-7333


Engineering
Operations

Department of Water and Power Approval
By: 8/4/2017
Vernon R. Weisman, P.E.
District Engineer
R.C.E. No. 41610


CITY OF CORONA - RESIN TREATMENT OF NITRATE SOURCES
WELLS 32 AND 33 EQUIPPING
WELLHOUSE GENERAL STRUCTURAL NOTES

Drawing No.
13-038U
S-1
Sht. 12 of 21




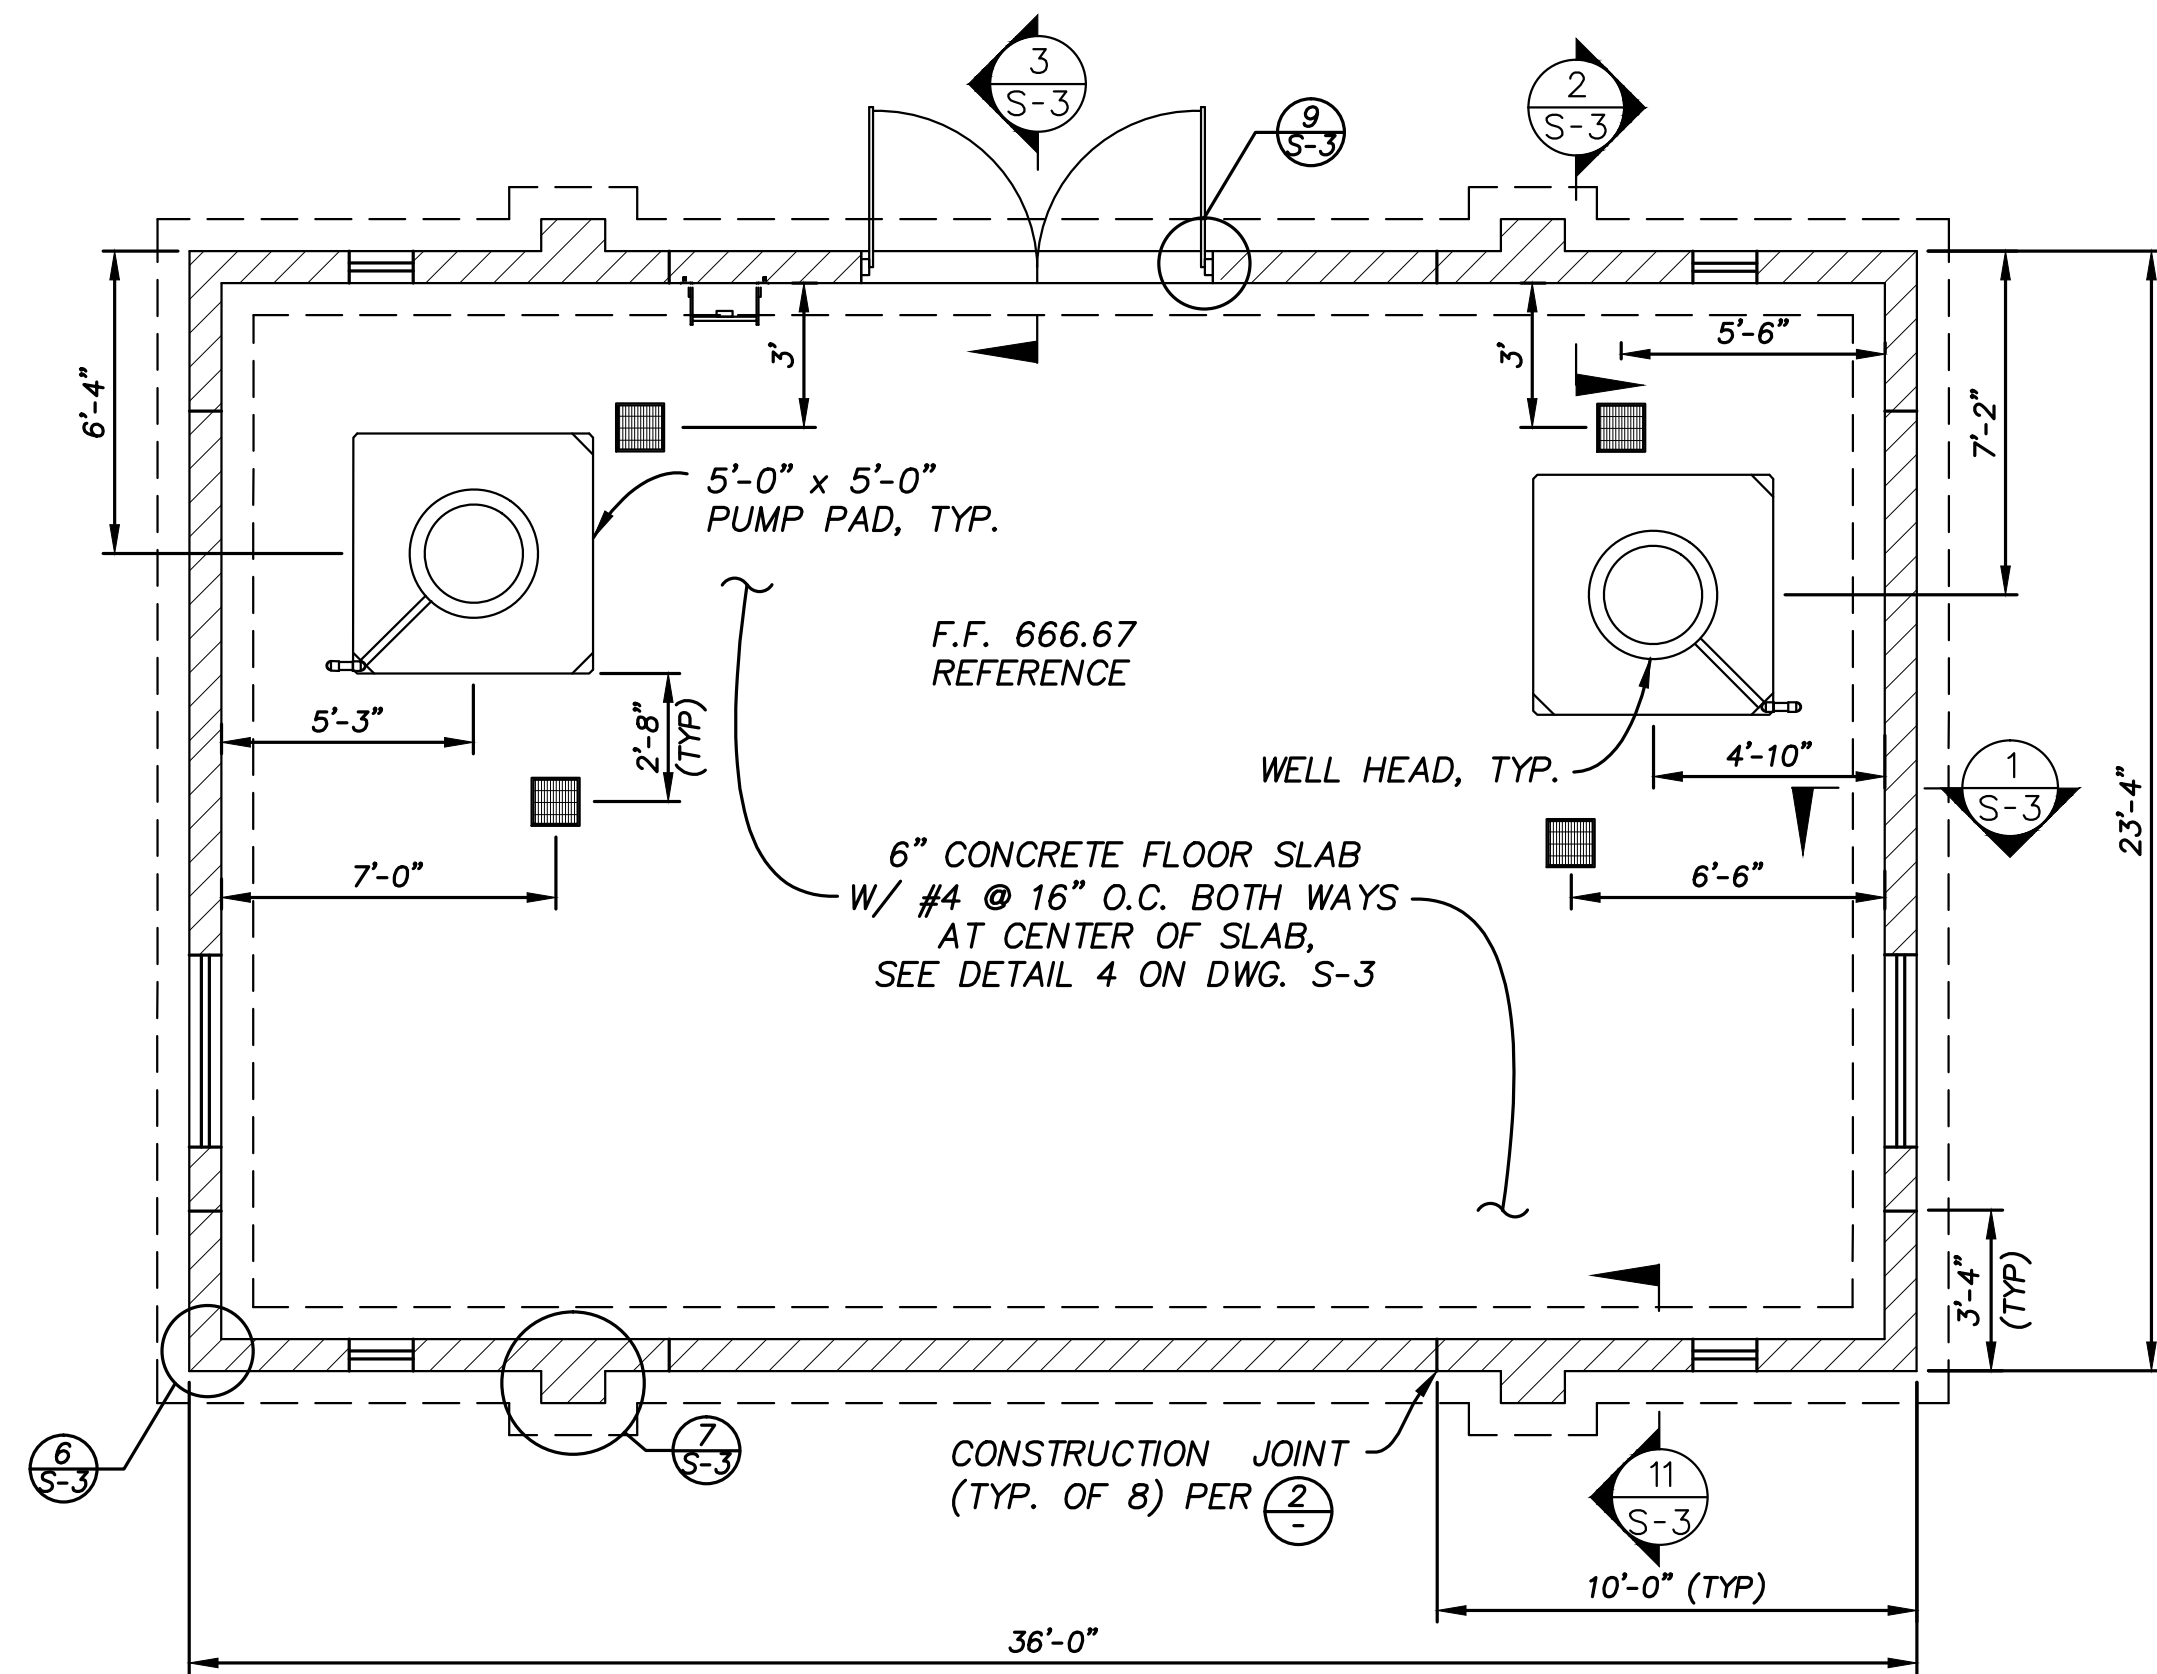

FLOOR PLAN
SCALE: 1/4" = 1'-0"

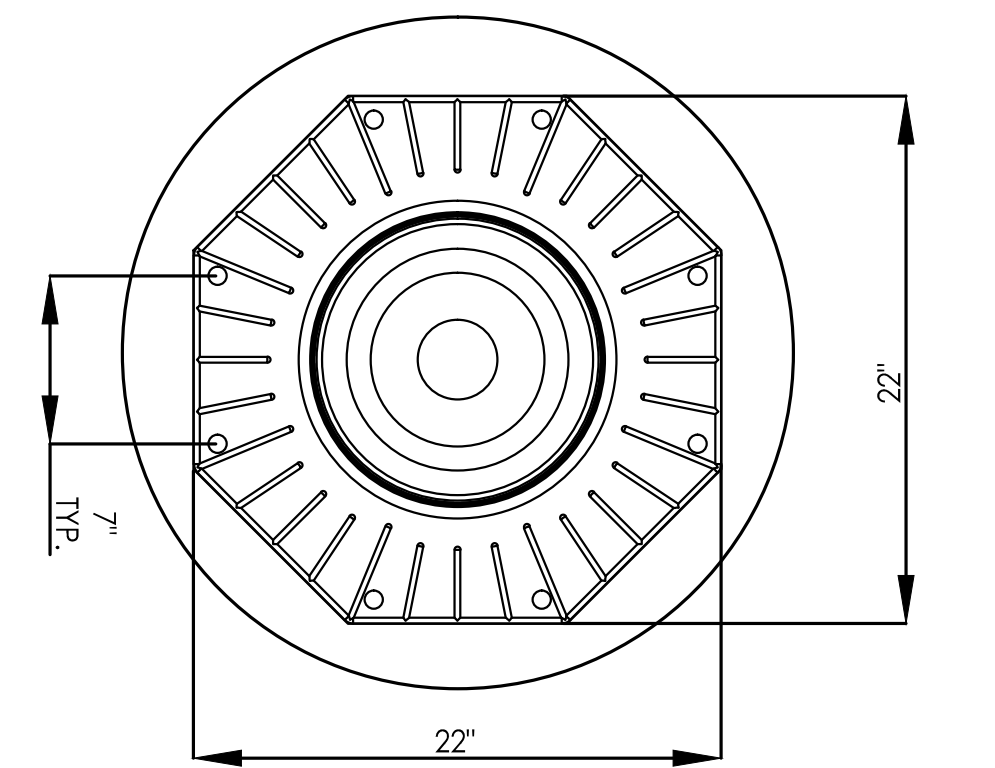


SOLA TUBE TOP VIEW 1
SCALE: 1 1/2" = 1'-0"

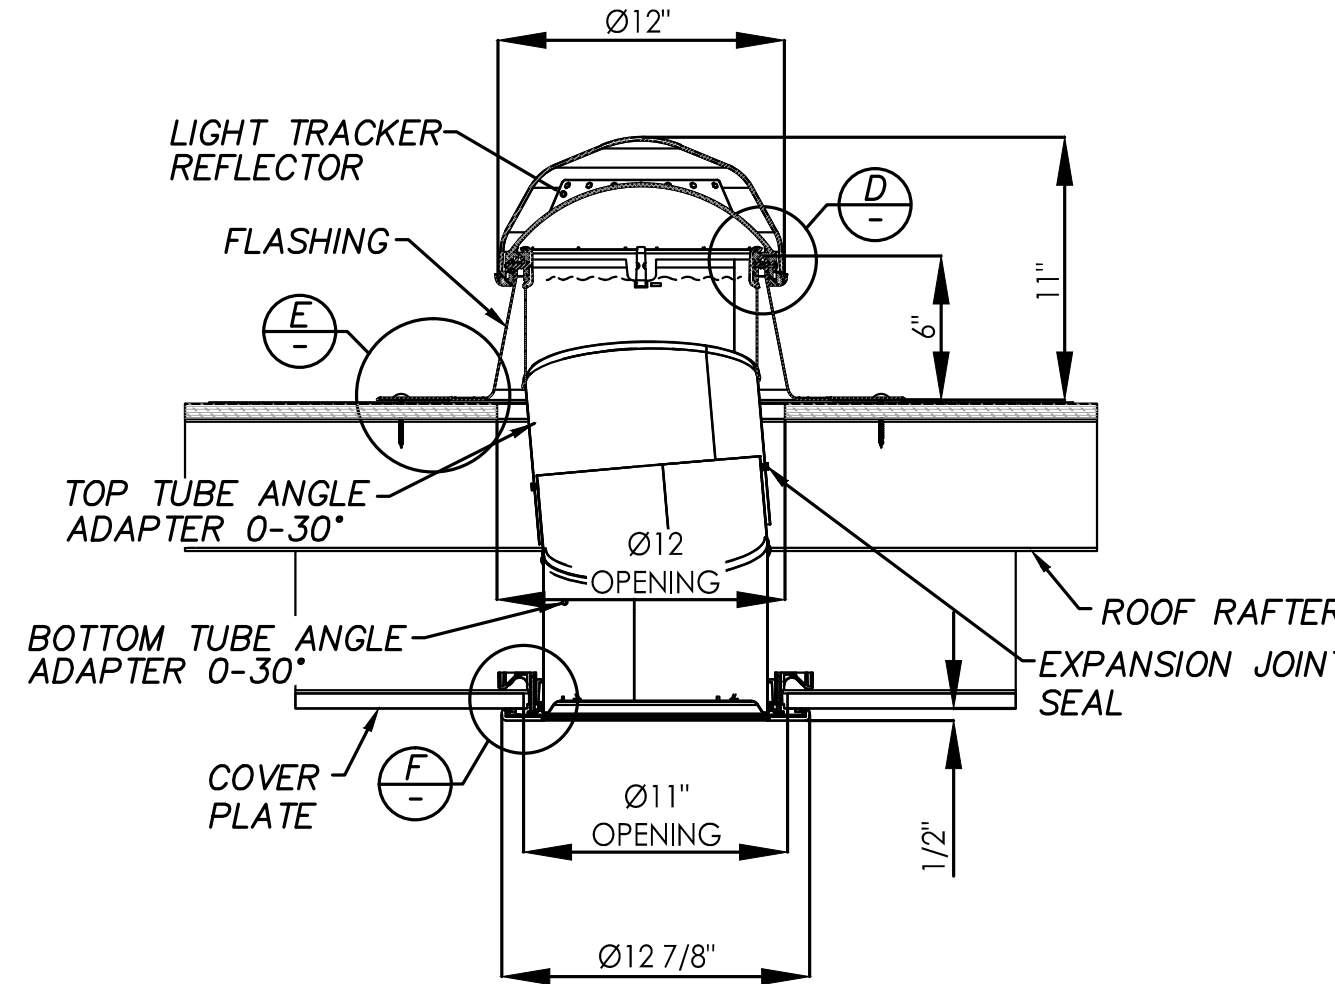


NOTES:

1. ALL TUBE JOINTS & SEAMS TAPED WITH 2" FOIL TAPE (NOT SHOWN).
2. 6" MIN CLEARANCE SHOULD BE MAINTAINED FROM ALL SOLATUBE COMPONENTS AND OTHER PLENUM COMPONENTS.


SOLA TUBE SECTION
SCALE: 1 1/2" = 1'-0"

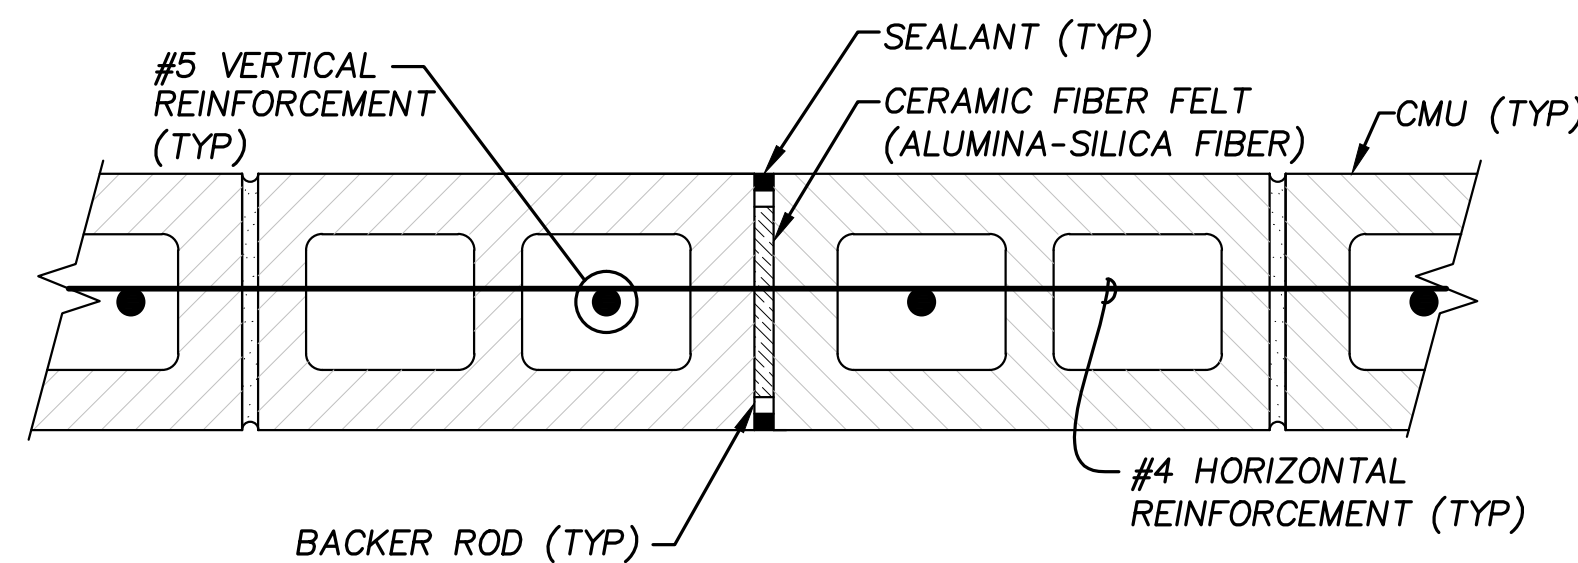


TYPICAL CONSTRUCTION JOINT DETAIL 2
NOT TO SCALE

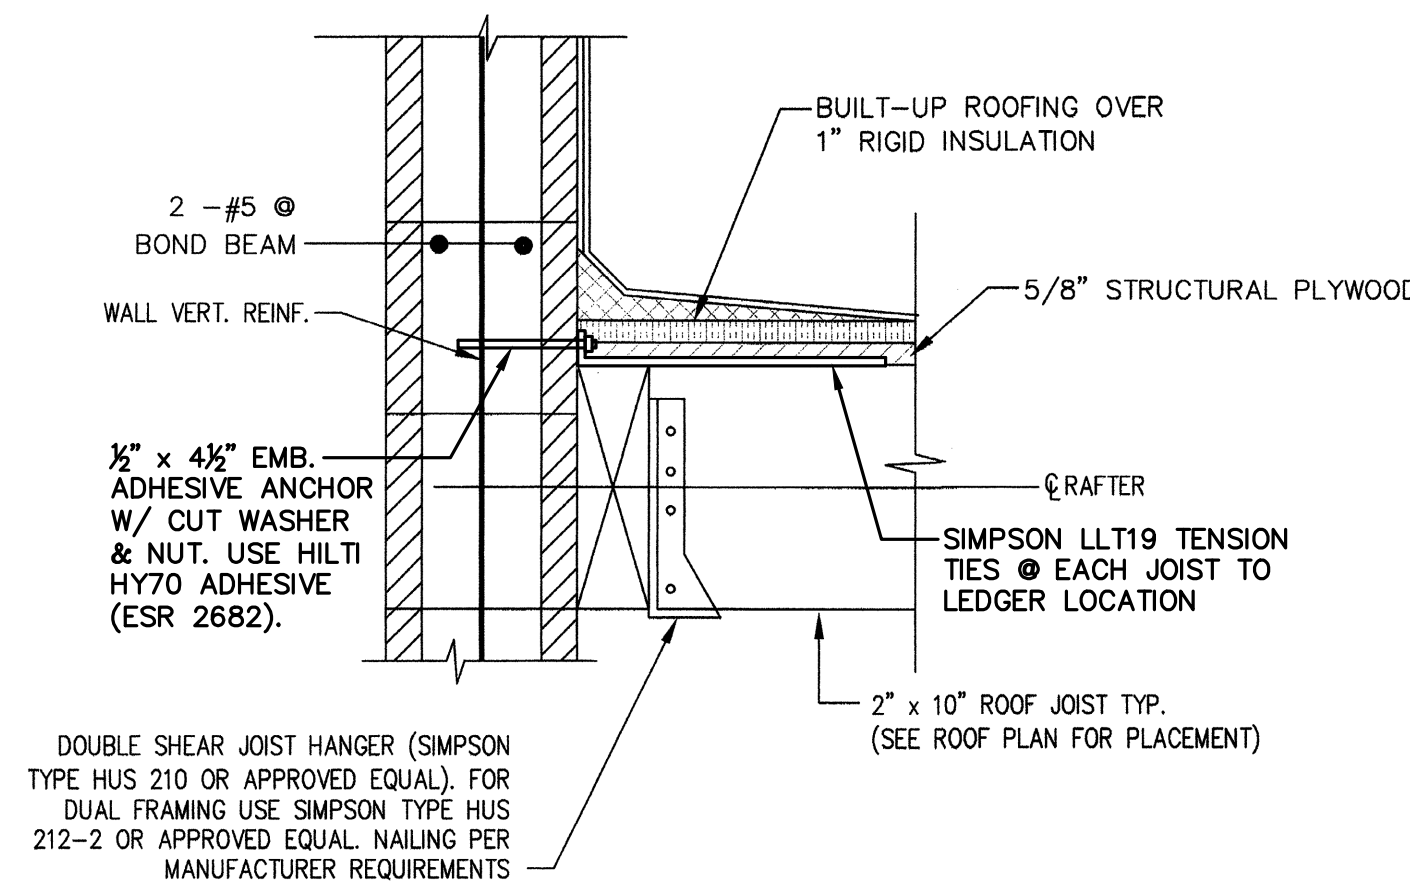


DETAIL A
NOT TO SCALE

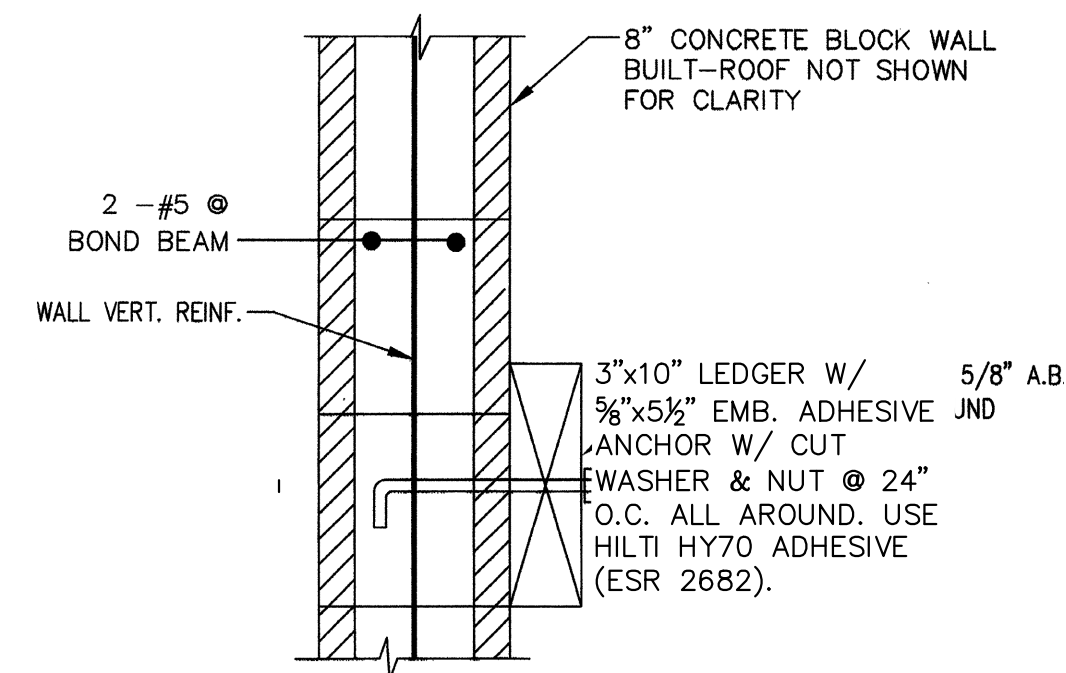


DETAIL B
NOT TO SCALE

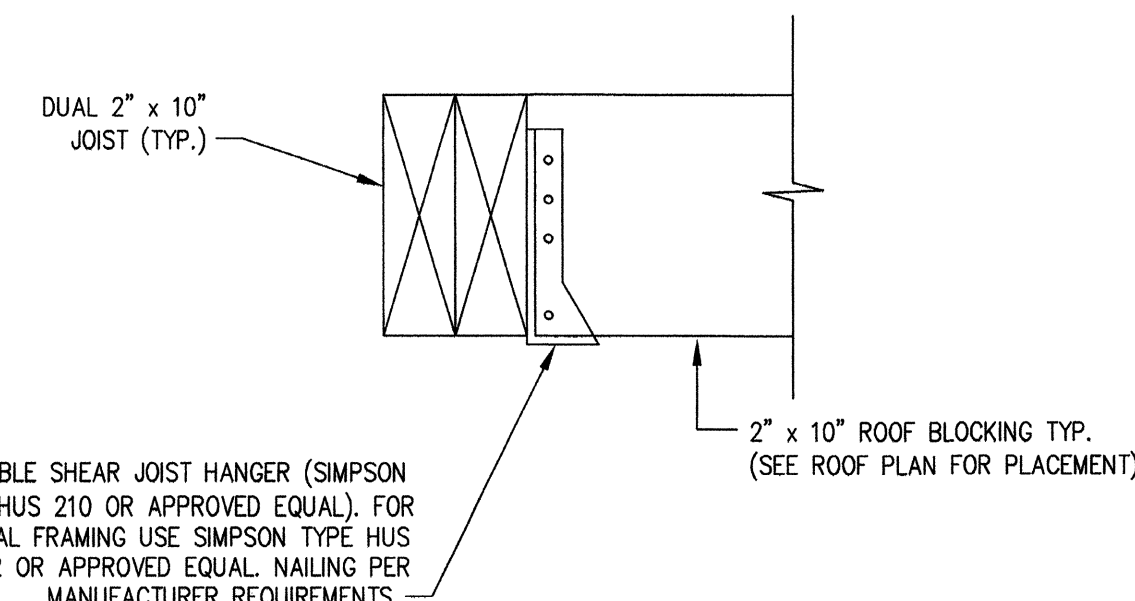

DETAIL C
NOT TO SCALE

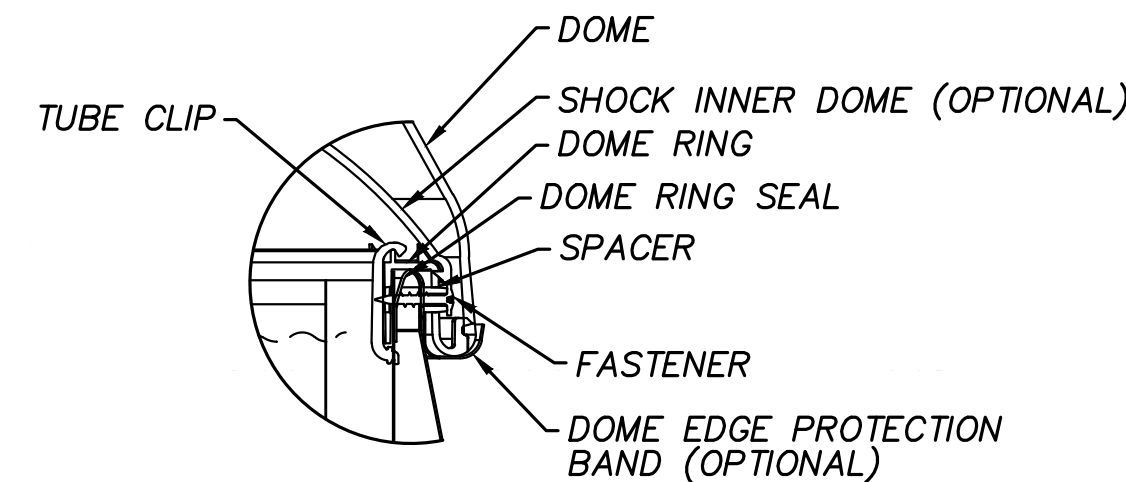


DETAIL D
SCALE: 3" = 1'-0"

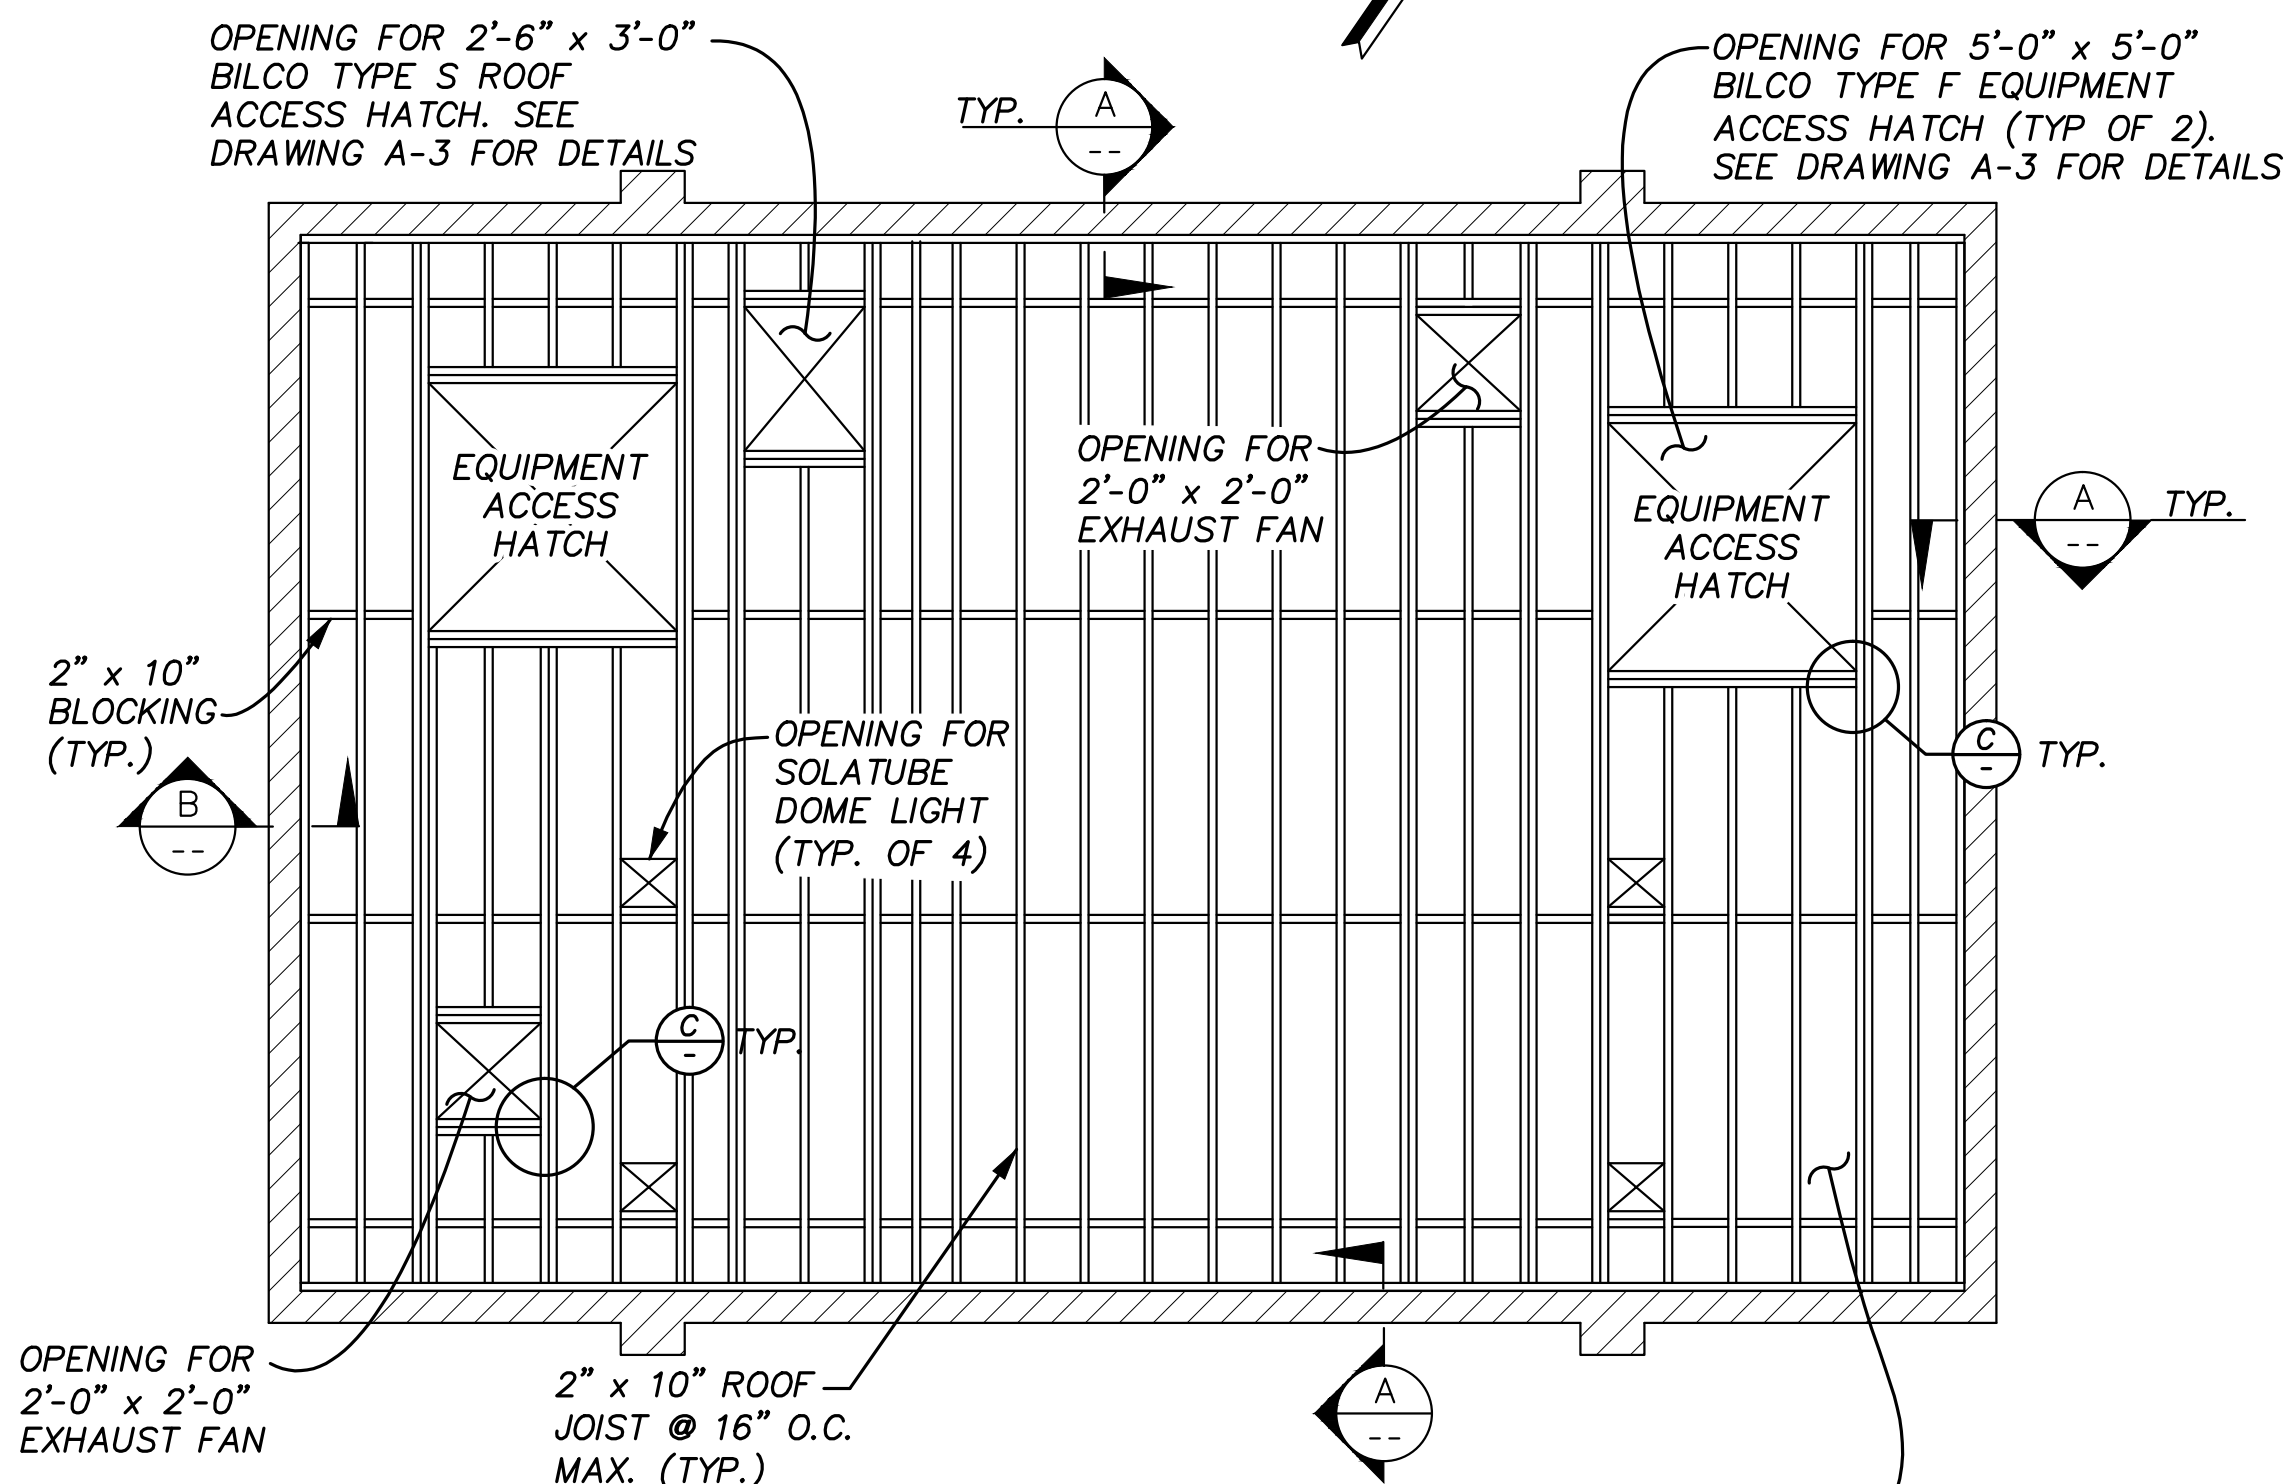


ROOF FRAMING PLAN
SCALE: 1/4" = 1'-0"

NOTE:

ROOF JOISTS SHALL BE DOUGLAS FIR-LARCH SELECT STRUCTURAL.

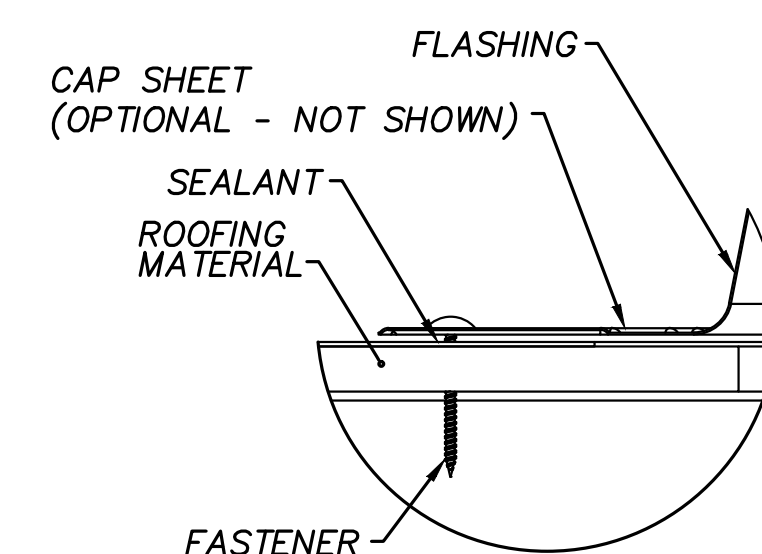


DETAIL E
SCALE: 3" = 1'-0"

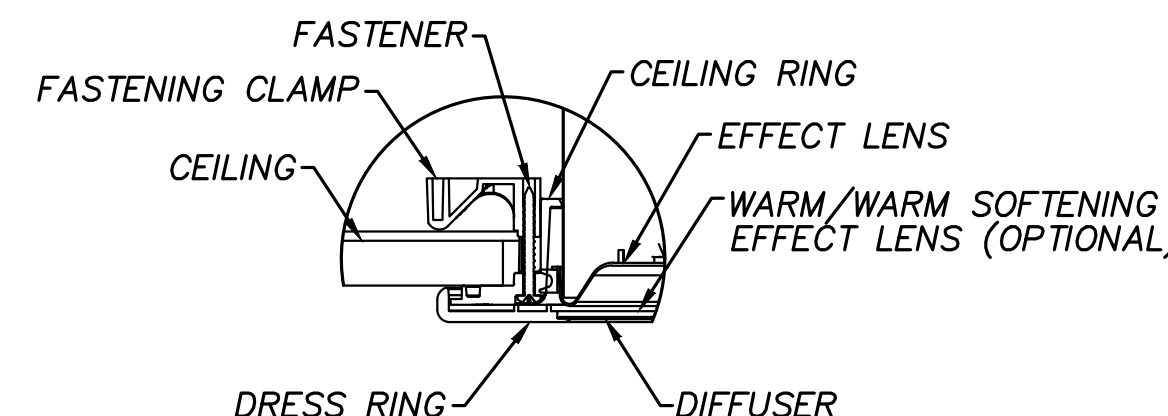

DETAIL F
SCALE: 3" = 1'-0"

AKM JOB No. 0761209.00

Underground Service Alert
Call: TOLL FREE

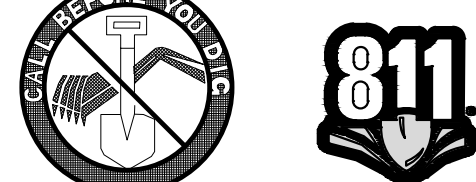

TWO WORKING DAYS BEFORE YOU DIG

0 1/2 1 24x36 FORMAT
IF THIS BAR MEASURES 1" THEN
DRAWING SCALE IS AS NOTED
0 1/4 1/2 12x18 FORMAT
WARNING IF THIS BAR MEASURES
1/2" THEN DRAWING IS NOT FULL
SCALE AND IS 50% REDUCED

Designed by D. BAKER
Drawn by M.U. R.U.
Checked by G. HOBSON
PLANS PREPARED UNDER SUPERVISION OF
GARY J. HOBSON
Date JULY 2017 R.C.E. No. 40779

Reference Plans for these Improvements
Date By REVISIONS App'd



AKM CONSULTING ENGINEERS
553 WALD
IRVINE, CA. 92618
(949) 753-7333

Engineering
Operations

Department of Water and Power Approval
By: 8/4/2017
Vernon R. Weisman, P.E.
District Engineer
R.C.E. No. 41610


CITY OF CORONA - RESIN TREATMENT OF NITRATE SOURCES
WELLS 32 AND 33 EQUIPPING
FOUNDATION AND ROOF FRAMING PLANS

Drawing No. 13-038U
S-2
Sht. 13 of 21




NOTE:

FOOTING AND SLAB SUBGRADE - PROVIDE 12-INCH AGGREGATE BASE
COMPACTED TO 95% RELATIVE COMPACTION, AND OVEREXCAVATE AND
RE-COMPACT 2' TO 95% RELATIVE COMPACTION.

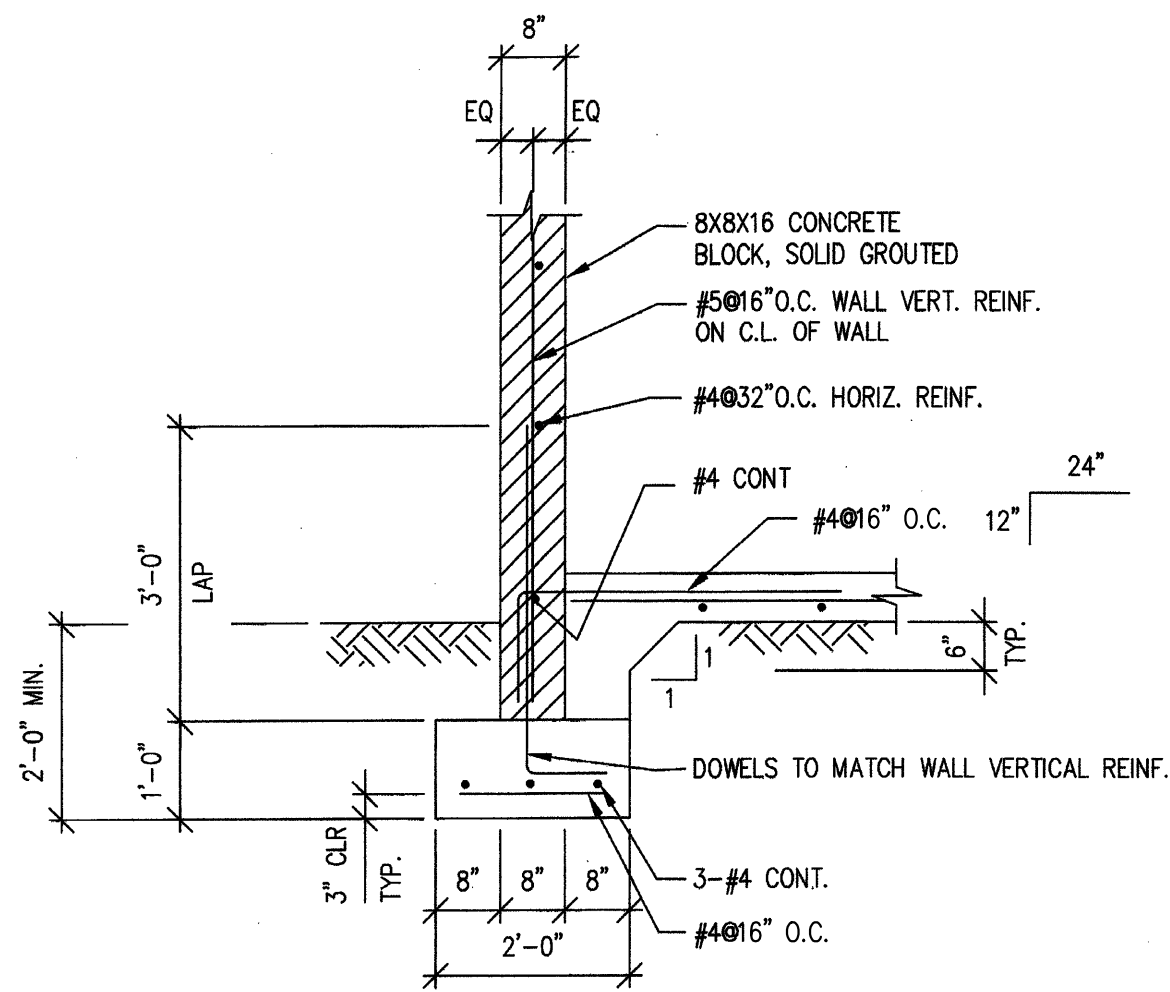


TYPICAL WALL SECTION

1

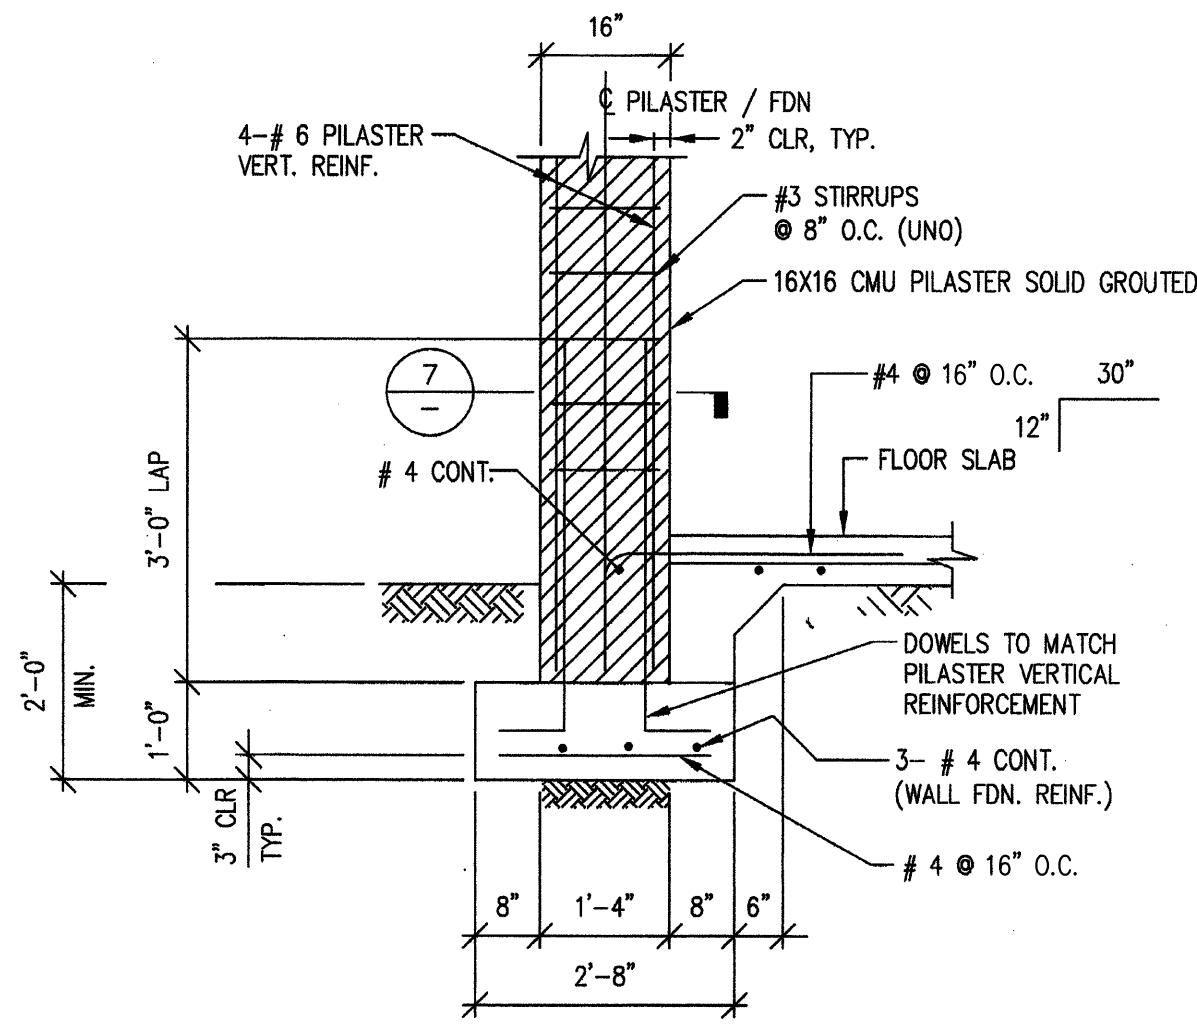


TYPICAL PILASTER SECTION

2

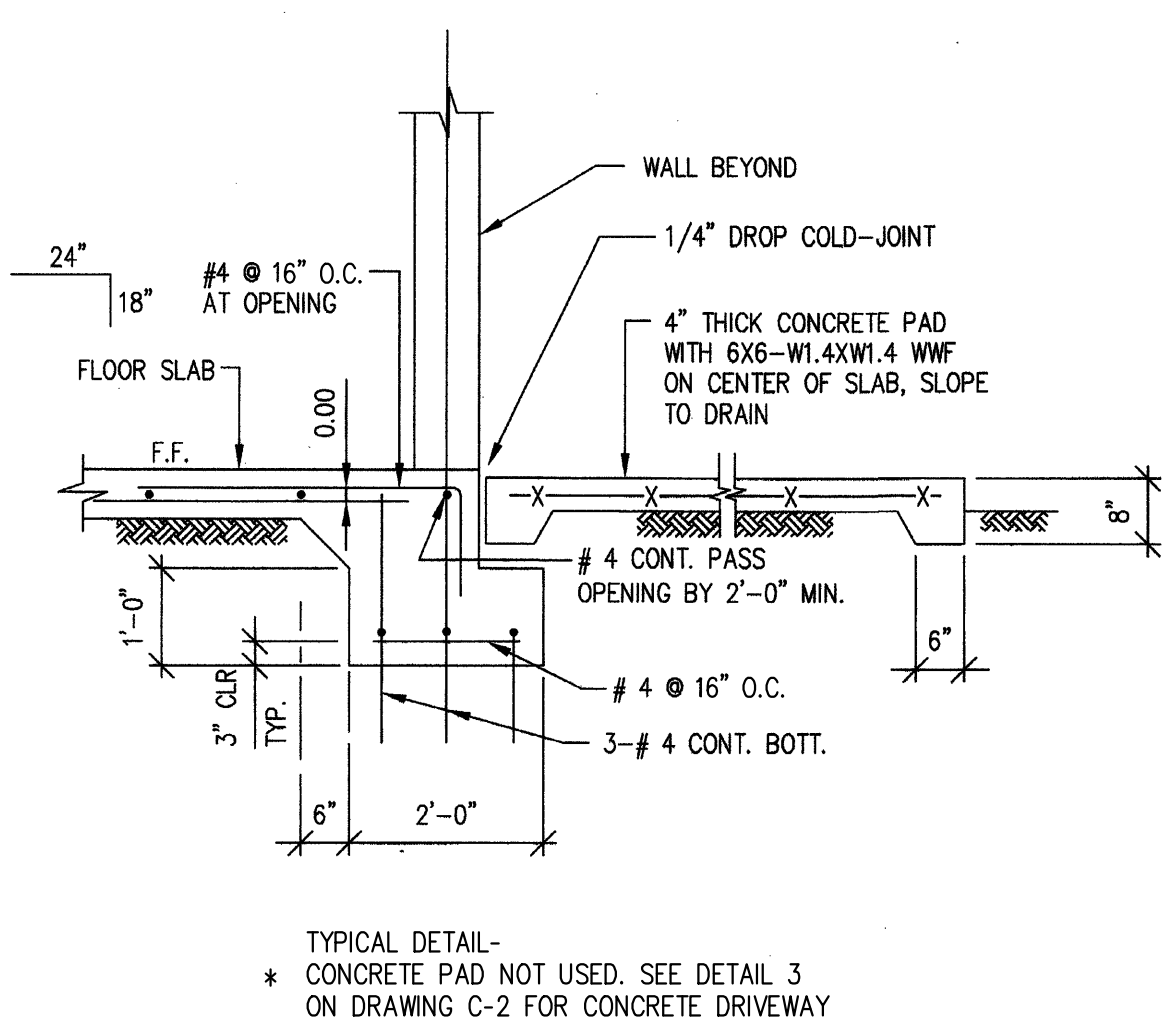

SECTION AT DOOR

3

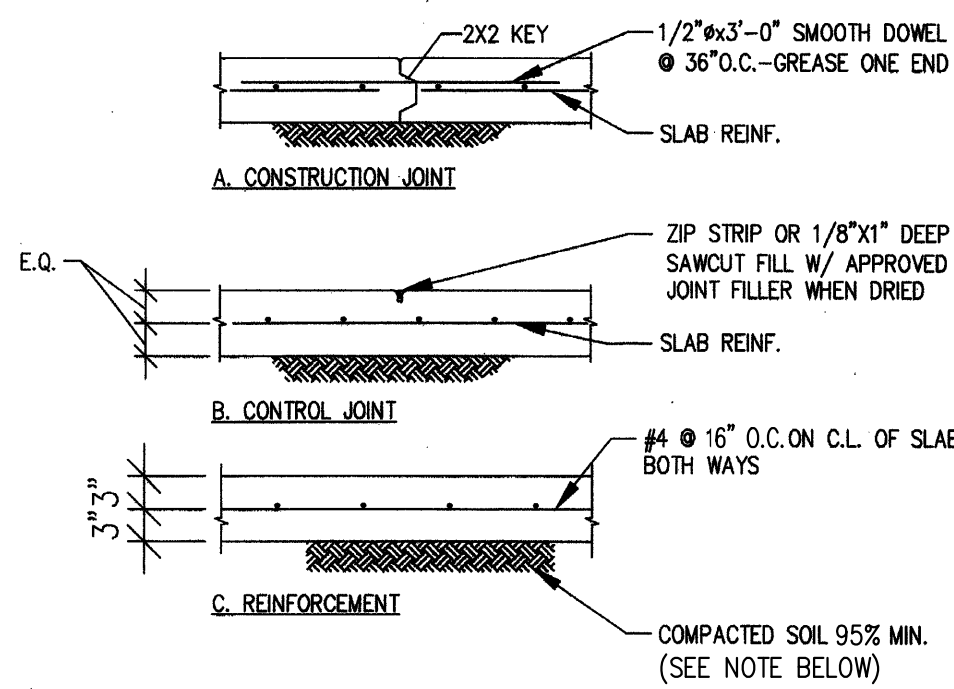


FLOOR SLAB AND JOINTS DETAILS

4

REINF.	CONCRETE		MASONRY
	TOP BAR	OTHER	
#3	24"	19"	18"
#4	32"	25"	24"
#5	40"	31"	30"
#6	48"	37"	36"
#7	70"	54"	42"
#8	80"	62"	48"
#9	90"	70"	54"


NOTES:

1. CONCRETE LAP LENGTH IS BASED ON CLASS B TENSION SPlice, $F_c = 4,000$ PSI AND GRADE 60 REBARS.
2. TOP BAR IS THE HORIZONTAL REINFORCEMENT SO PLACED THAT MORE THAN 12" OF FRESH CONCRETE IS CAST IN THE MEMBER BELOW THE SPlice.
3. USE THIS TABLE WHERE LAP SPlice LENGTH IS NOT SHOWN ON DRAWINGS.

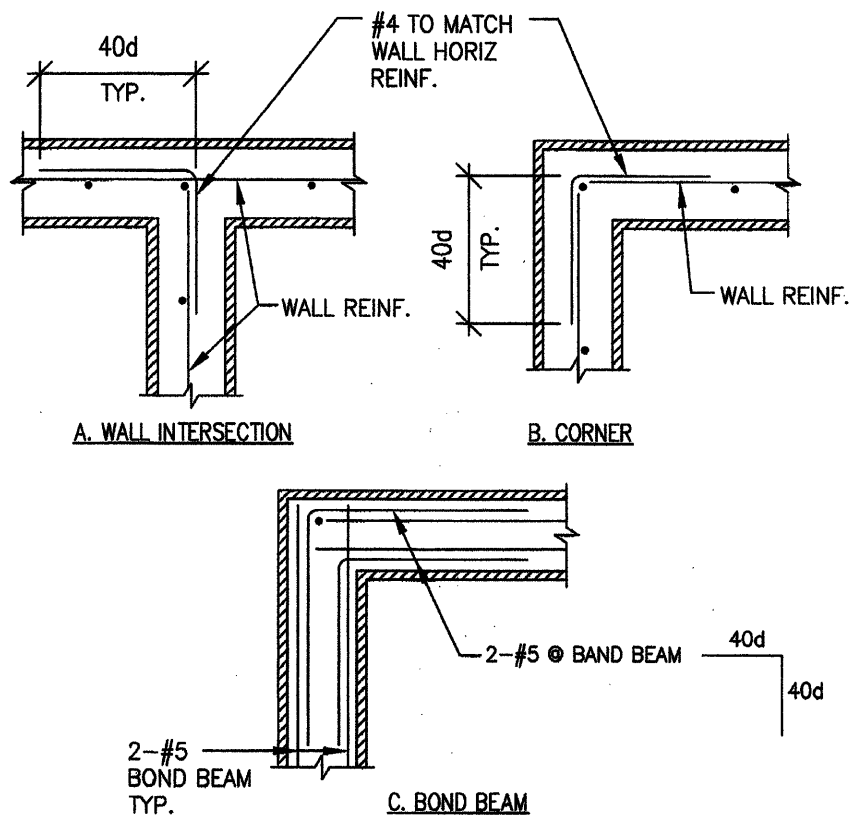


CMU WALL INTERSECTION DETAILS

6

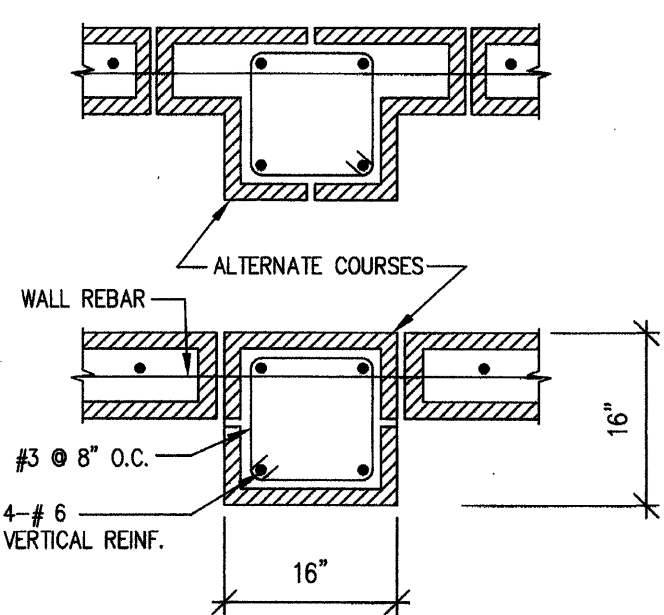

PILASTER SECTION

7

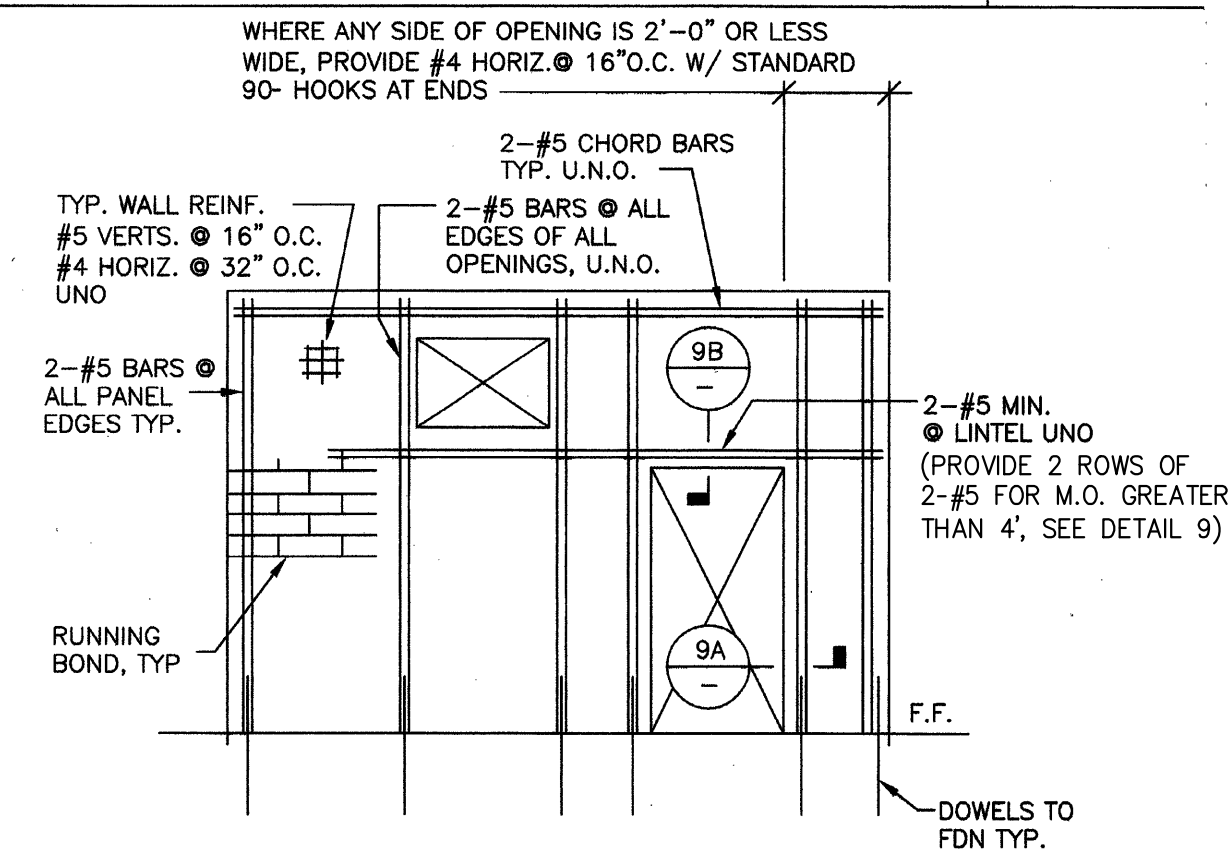


WALL REINFORCEMENT

8


REINFORCING LAP SPlice SCHEDULE

5

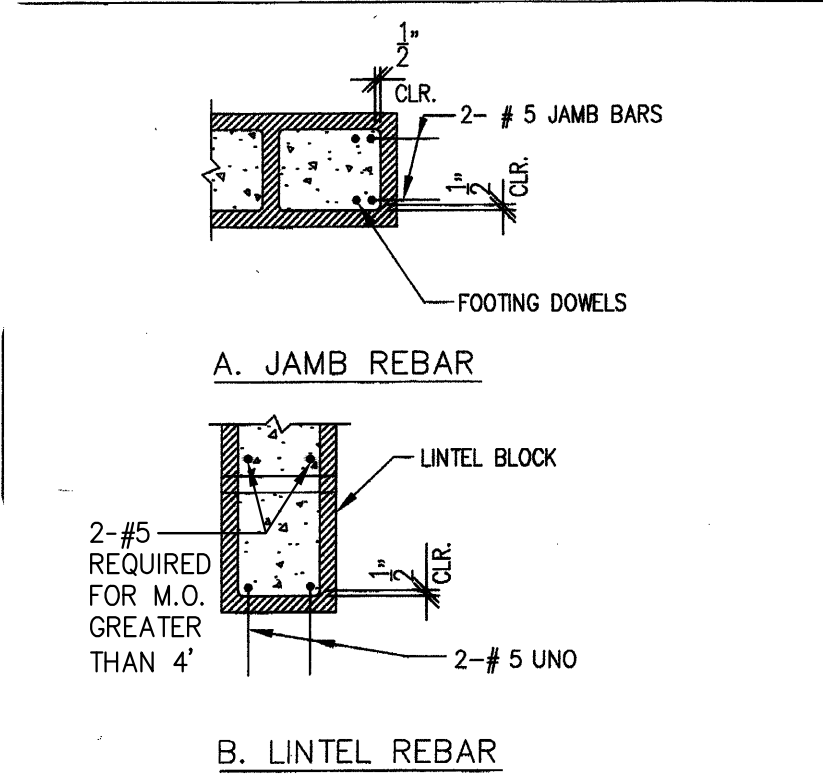


DETAIL

9

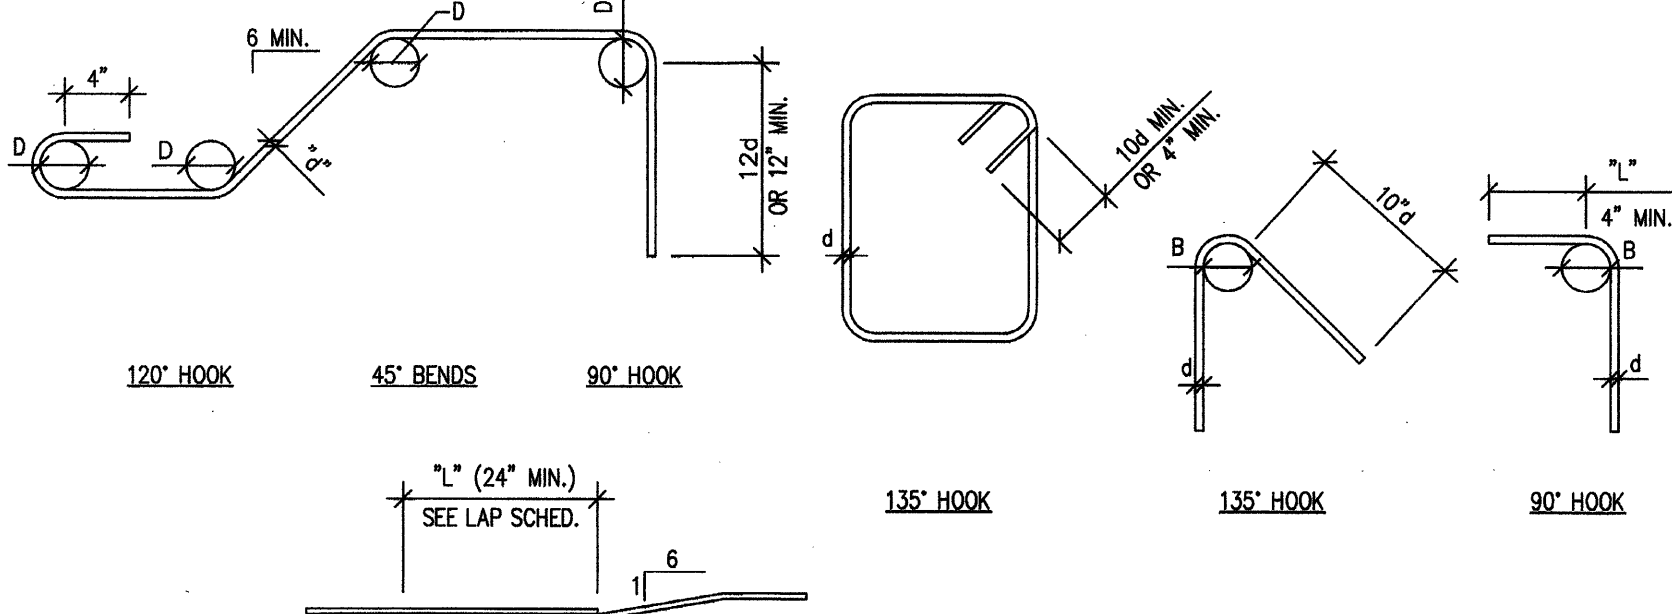

TYPICAL REBAR BENDING DETAILS

10

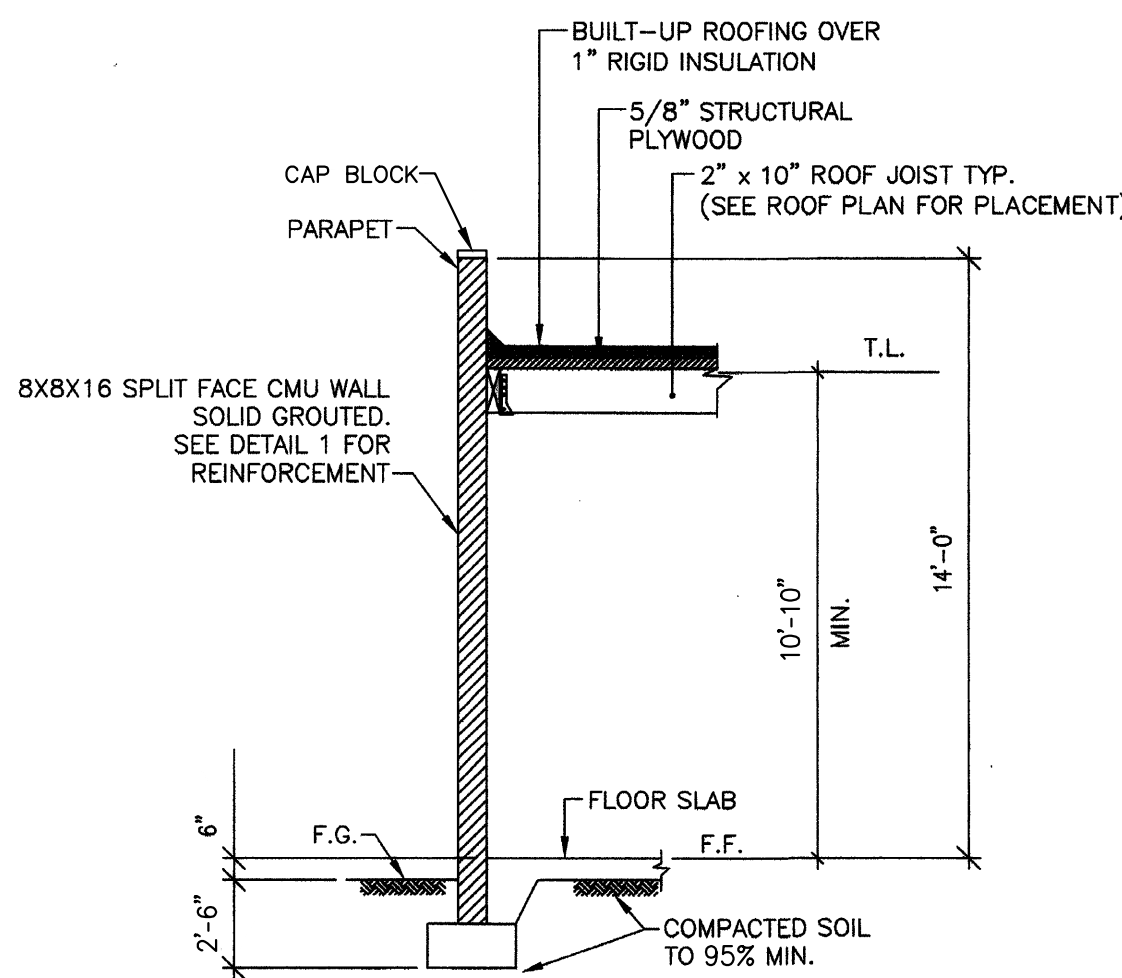

TYPICAL WALL SECTION

11

ADDITIONAL REINFORCING FOR PIPE PENETRATIONS

12

AKM JOB No. 0761209.00

Underground Service Alert

Call: TOLL FREE



TWO WORKING DAYS BEFORE YOU DIG

0 1/2 1 24x36 FORMAT
IF THIS BAR MEASURES 1" THEN
DRAWING SCALE IS AS NOTED
12x18 FORMAT
WARNING IF THIS BAR MEASURES
1/2" THEN DRAWING IS NOT FULL
SCALE AND IS 50% REDUCED

Designed by D. BAKER
Drawn by M.U. R.U.
Checked by G. HOBSON
PLANS PREPARED UNDER SUPERVISION OF
GARY J. HOBSON
Date JULY 2017 R.C.E. No. 40779

Reference Plans for these Improvements

Date

By

REVISIONS

App'd




AKM CONSULTING ENGINEERS
553 WALD
IRVINE, CA. 92618
(949) 753-7333









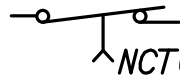



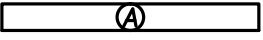
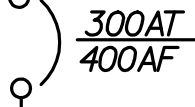
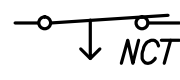

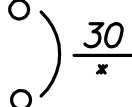

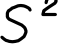

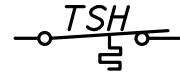


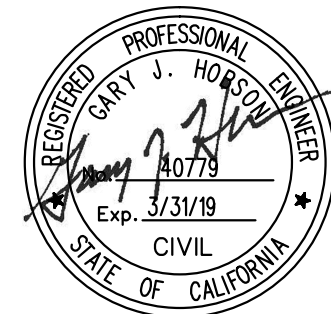

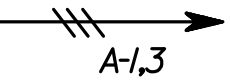
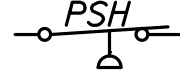

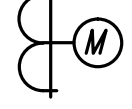

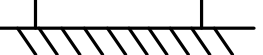
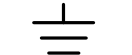

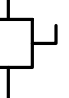

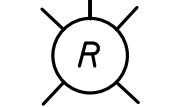
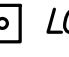


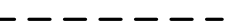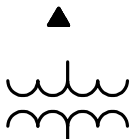
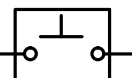
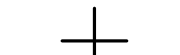




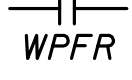




Engineering
Operations

Department of Water and Power Approval
By: [Signature] 8/4/2017
Vernon R. Weisman, P.E.
District Engineer
R.C.E. No. 41610




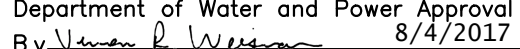
CITY OF CORONA - RESIN TREATMENT OF NITRATE SOURCES
WELLS 32 AND 33 EQUIPPING
STRUCTURAL DETAILS

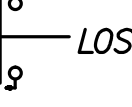Drawing No.
13-038U
S-3
Sht. 14 of 21





SYMBOL		SYMBOL		SYMBOL	
DESCRIPTION		DESCRIPTION		DESCRIPTION	
	CONDUIT RUN EXPOSED. HASH MARKS INDICATE NUMBER OF #12 AWG (MIN.) CONDUCTORS IN CONDUIT. ALL CONDUCTORS AND CONDUITS SHALL BE SIZED PER NEC. ARROW INDICATES HOME RUN TO PANEL "A" CIRCUITS 1 AND 3 (COMMON NEUTRAL).		JUNCTION BOX. AT ALL OUTDOOR LOCATIONS, BOX SHALL INCLUDE A NEMA 4 ENCLOSURE WITH HUBS FOR ALL CONDUIT ENTRANCES.		CONTROL RELAY. LETTERS IN CIRCLE IDENTIFY RELAY COIL
	CONDUIT RUN IN FLOOR, SLAB OR UNDERGROUND.		DEVICE LOCATED IN FIELD ON OR NEAR PUMP (MOTOR).		TIME DELAY RELAY. LETTERS IN CIRCLE IDENTIFY TIME DELAY RELAY. SEE SCHEMATIC FOR OPERATING PARAMETERS. PROVIDE POWER CONNECTION AS REQUIRED.
	FLEXIBLE CONDUIT CONNECTION WITH INTEGRAL GROUND CONDUCTOR		TRANSFORMER. DESCRIPTION AS NOTED ON PLANS OR SPECIFICATIONS.		NORMALLY CLOSED CONTACT TIMED TO OPEN AFTER ENERGIZATION.
	INCOMING LINE.		TRANSFORMER.		NORMALLY OPEN CONTACT TIMED TO CLOSE AFTER ENERGIZATION.
	FLUORESCENT LIGHTING FIXTURE. TYPE AND MOUNTING AS NOTED. A REPRESENTS CIRCUIT NUMBER FROM LP "A"		THERMAL MAGNETIC BREAKER. 300 AT INDICATES TRIP AMPS. 400 AF INDICATES FRAME SIZE.		NORMALLY CLOSED CONTACT. INSTANT OPEN ON ENERGIZATION. TIMED TO CLOSE AFTER DE-ENERGIZATION.
	SINGLE-POLE TOGGLE SWITCH, 120V, 20A, HUBBLE #1223 "a" DENOTES OUTLETS CONTROLLED BY SWITCH.		CIRCUIT BREAKER. UPPER NUMBER IS CONTINUOUS TRIP ELEMENT RATING. * INDICATES FIELD SETTING BASED ON INSTALLED MOTOR.		NORMALLY OPEN CONTACT. INSTANT CLOSE ON ENERGIZATION. TIMED TO OPEN AFTER DE-ENERGIZATION.
	DOUBLE-POLE TOGGLE SWITCH, 120V, 20A HUBBLE #1222.		FUSE.		TEMPERATURE SWITCH. NORMALLY CLOSED.
	MANUAL MOTOR STARTER, 1 HP MAX. , 120V WITH OVERLOAD HEATER FOR MOTOR SIZE INDICATED ON PLANS.		THERMOSTAT. MOUNT AS NOTED ON PLANS.		TEMPERATURE SWITCH. NORMALLY OPEN.
	DUPLEX CONVENIENCE RECEPTACLE, 2 POLE, 3 WIRE, 120VAC, 20A. MOUNTING HEIGHT AS NOTED. WP = OUTDOOR WEATHERPROOF. GFCI = GROUND FAULT CIRCUIT INTERRUPTER.		SQUIRREL CAGE MOTOR. 15 INDICATES HORSEPOWER.		PRESSURE SWITCH. NORMALLY CLOSED.
	ENCLOSURE TO BE DESCRIBED ON DRAWING.		POWER COMPANY METERING. SEE PLANS AND SPECIFICATIONS.		PRESSURE SWITCH. NORMALLY OPEN.
	SURFACE MOUNTED PANEL.		GROUND.		ON-OFF SWITCH.
	LINE DISCONNECT SWITCH. NON-FUSED UNLESS OTHERWISE NOTED. SWITCH RATING AS NOTED ON PLANS OR SPECIFICATIONS. NF = NON-FUSED. F = FUSED.		GROUND ROD 3/4" X 10' COPPERCLAD UNLESS OTHERWISE NOTED.		INDICATING LIGHT. R=RED, G=GREEN, W=WHITE.
	CONTROL STATION FOR MOTOR. SEE SCHEMATIC FOR SWITCH ARRANGEMENT. LOS = LOCK-OUT-STOP.		GROUND WELL.		CONDUCTORS-CONNECTED.
	ELECTRIC MOTOR, NUMBER INDICATES HORSEPOWER		NORMALLY OPEN PUSH BUTTON- MOMENTARY TYPE. DOTTED LINE INDICATES DEVICE MOUNTED REMOTE FROM PANEL.		CONDUCTORS- NOT CONNECTED.
			NORMALLY CLOSED PUSH BUTTON-MOMENTARY TYPE.		RUN TIME METER.
			LOCK-OUT-STOP PUSH BUTTON WITH LOCKING DEVICE.		SPACE HEATER.
			NORMALLY OPEN INTERLOCK. LETTERS IDENTIFY RELAY COIL.		TELEPHONE OUTLET.
			NORMALLY CLOSED INTERLOCK. LETTERS IDENTIFY RELAY COIL		MAGNETIC MOTOR STARTER, NEMA SIZE 4
					SOLID STATE SOFT STARTER

LIST OF ABBREVIATIONS							
A	AMPERE	DN	DOWN	G	GREEN	PSH	PRESSURE SWITCH HIGH
AC	ALTERNATING CURRENT	DWG	DRAWING	LTG	LIGHTING	PT	PRESSURE TRANSDUCER
AI	ANALOG INPUT	EC	ETHERNET CONNECTION	M	MOTOR, MAGNETIC STARTER	PWR	POWER
A I C	AMPERES INTERRUPTING CAPACITY	EF	EXHAUST FAN	mA	MILLIAMP	REC	RECEPTACLE
AFF	ABOVE FINISHED FLOOR	EL	ELEVATION	MCC	MOTOR CONTROL CENTER	RPM	REVOLUTIONS PER MINUTE
ALT	ALTERNATOR	GND	GROUND	MCP	MOTOR CIRCUIT PROTECTOR	RTU	REMOTE TELEMETRY UNIT
AO	ANALOG OUTPUT	HOA	HAND-OFF-AUTOMATIC	MCS	MOLDED CASE SWITCH	SHLD	SHIELDED
APPROX	APPROXIMATELY	HP	HORSEPOWER	MH	MANHOLE	SHT	SHEET
AWG	AMERICAN WIRE GAUGE	HZ	HERTZ	MIN	MINIMUM	SSMC	SOLID STATE MOTOR CONTROLLER
BC	BARE COPPER	INSTR	INSTRUMENTATION	MTD	MOUNTED	TEFC	TOTALLY ENCLOSED FAN COOLED
BKR	BREAKER	KVA	KILOVOLT AMPERES	NA	NOT APPLICABLE	TDR	TIME DELAY RELAY
BLDG	BUILDING	KW	KILOWATT	N/C	NORMALLY CLOSED	TYP	TYPICAL
C	CONDUIT	KWH	KILOWATT HOUR	NIC	NOT IN CONTRACT	TSP	TWISTED SHIELDED PAIR
C & I	CONTROLS & INSTRUMENTATION	LCL	LEAST COMMON LOAD	NO	NORMALLY OPEN, NUMBER	V	VOLT, VOLTMETER
CKT	CIRCUIT	LOS	LOCK-OUT STOP	NTS	NOT TO SCALE	VFD	VARIABLE FREQUENCY DRIVE
CO	CONDUIT ONLY	LP	LIGHTING PANEL	OIT	OPERATOR INTERFACE TERMINAL	W	WATT
COMB	COMBINATION	LPU	LIVE PROTECTION UNIT	O/L	OVERLOAD	W/	WITH
CONT	CONTROL	LSH	LEVEL SWITCH HIGH	P	POLE, PHASE	WP	WEATHER PROOF
CPT	CONTROL POWER TRANSFORMER	EM	EMERGENCY	PB	PULL BOX, PUSH BUTTON	XFMR	TRANSFORMER
DC	DIRECT CURRENT	FLA	FULL LOAD AMPERES	PCP	PUMP CONTROL PANEL	XMTR	TRANSMITTER
DI	DIGITAL INPUT	FLEX	FLEXIBLE	PI	PRESSURE INDICATOR	XP	EXPLOSION PROOF
DISCH	DISCHARGE	FLUOR	FLUORESCENT	PLC	PROGRAMABLE LOGIC CONTROLLER	ZS	POSITION SWITCH (LIMIT SWITCH)
DO	DIGITAL OUTPUT	FS	FLOW SWITCH	PVC	POLYVINYL CHLORIDE		
		FT	FOOT 1 FLOW TRANSMITTER	PRESS	PRESSURE		

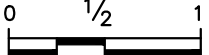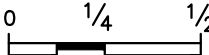		24x36 FORMAT IF THIS BAR MEASURES 1" THEN DRAWING SCALE IS AS NOTED 12x18 FORMAT WARNING IF THIS BAR MEASURES 1/2" THEN DRAWING IS NOT FULL SCALE AND IS 50% REDUCED	Designed by D. BAKER	Drawn by M.U. R.U.	Checked by G. HOBSON	PLANS PREPARED UNDER SUPERVISION OF GARY J. HOBSON Date JULY 2017 R.C.E. No. 40779	Reference Plans for these Improvements	Date	By	REVISIONS	App'd		AKM CONSULTING ENGINEERS 553 WALD IRVINE, CA 92618 (949) 753-7333	Engineering _____ Operations _____	Department of Water and Power Approval By  8/4/2017 Vernon R. Weisman, P.E. District Engineer R.C.E. No. 41610	CITY OF CORONA - RESIN TREATMENT OF NITRATE SOURCES WELLS 32 AND 33 EQUIPPING ELECTRICAL SYMBOLS AND LEGEND	Drawing No. 13-038U E-1 Sht. 15 of 21
---	---	--	-------------------------	-----------------------	-------------------------	--	---	------	----	-----------	-------	---	--	---------------------------------------	---	---	--



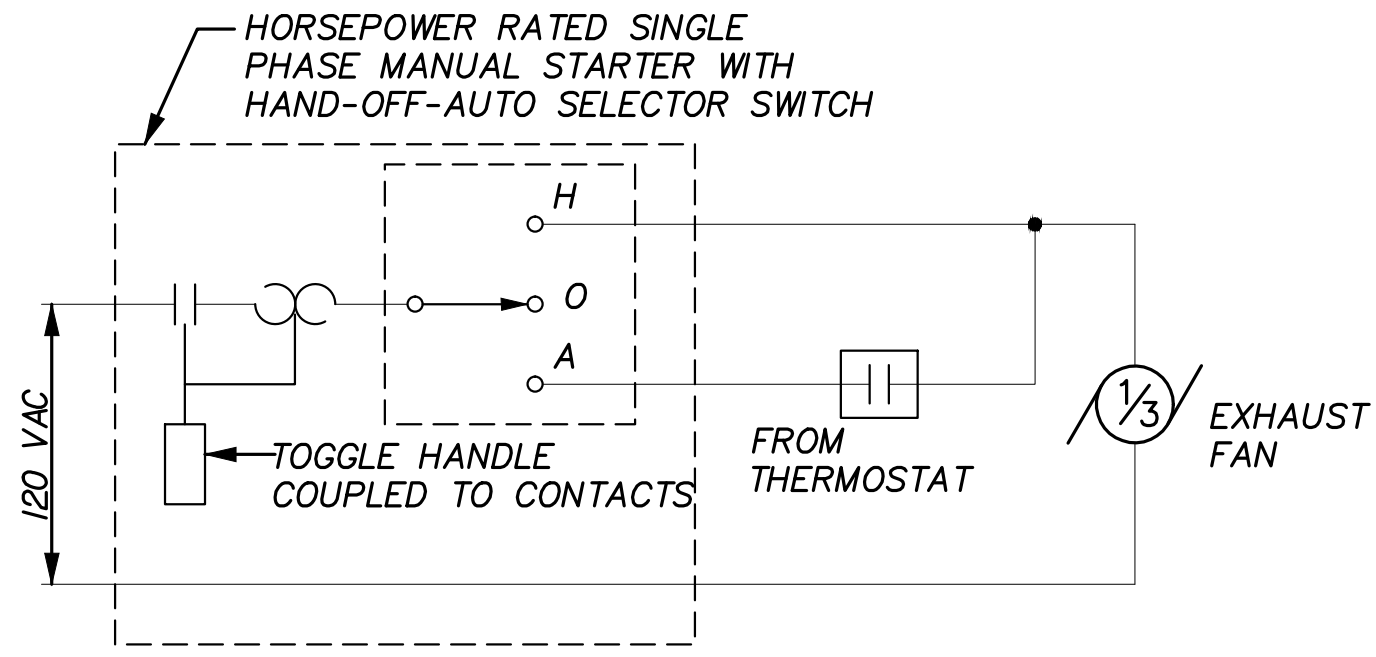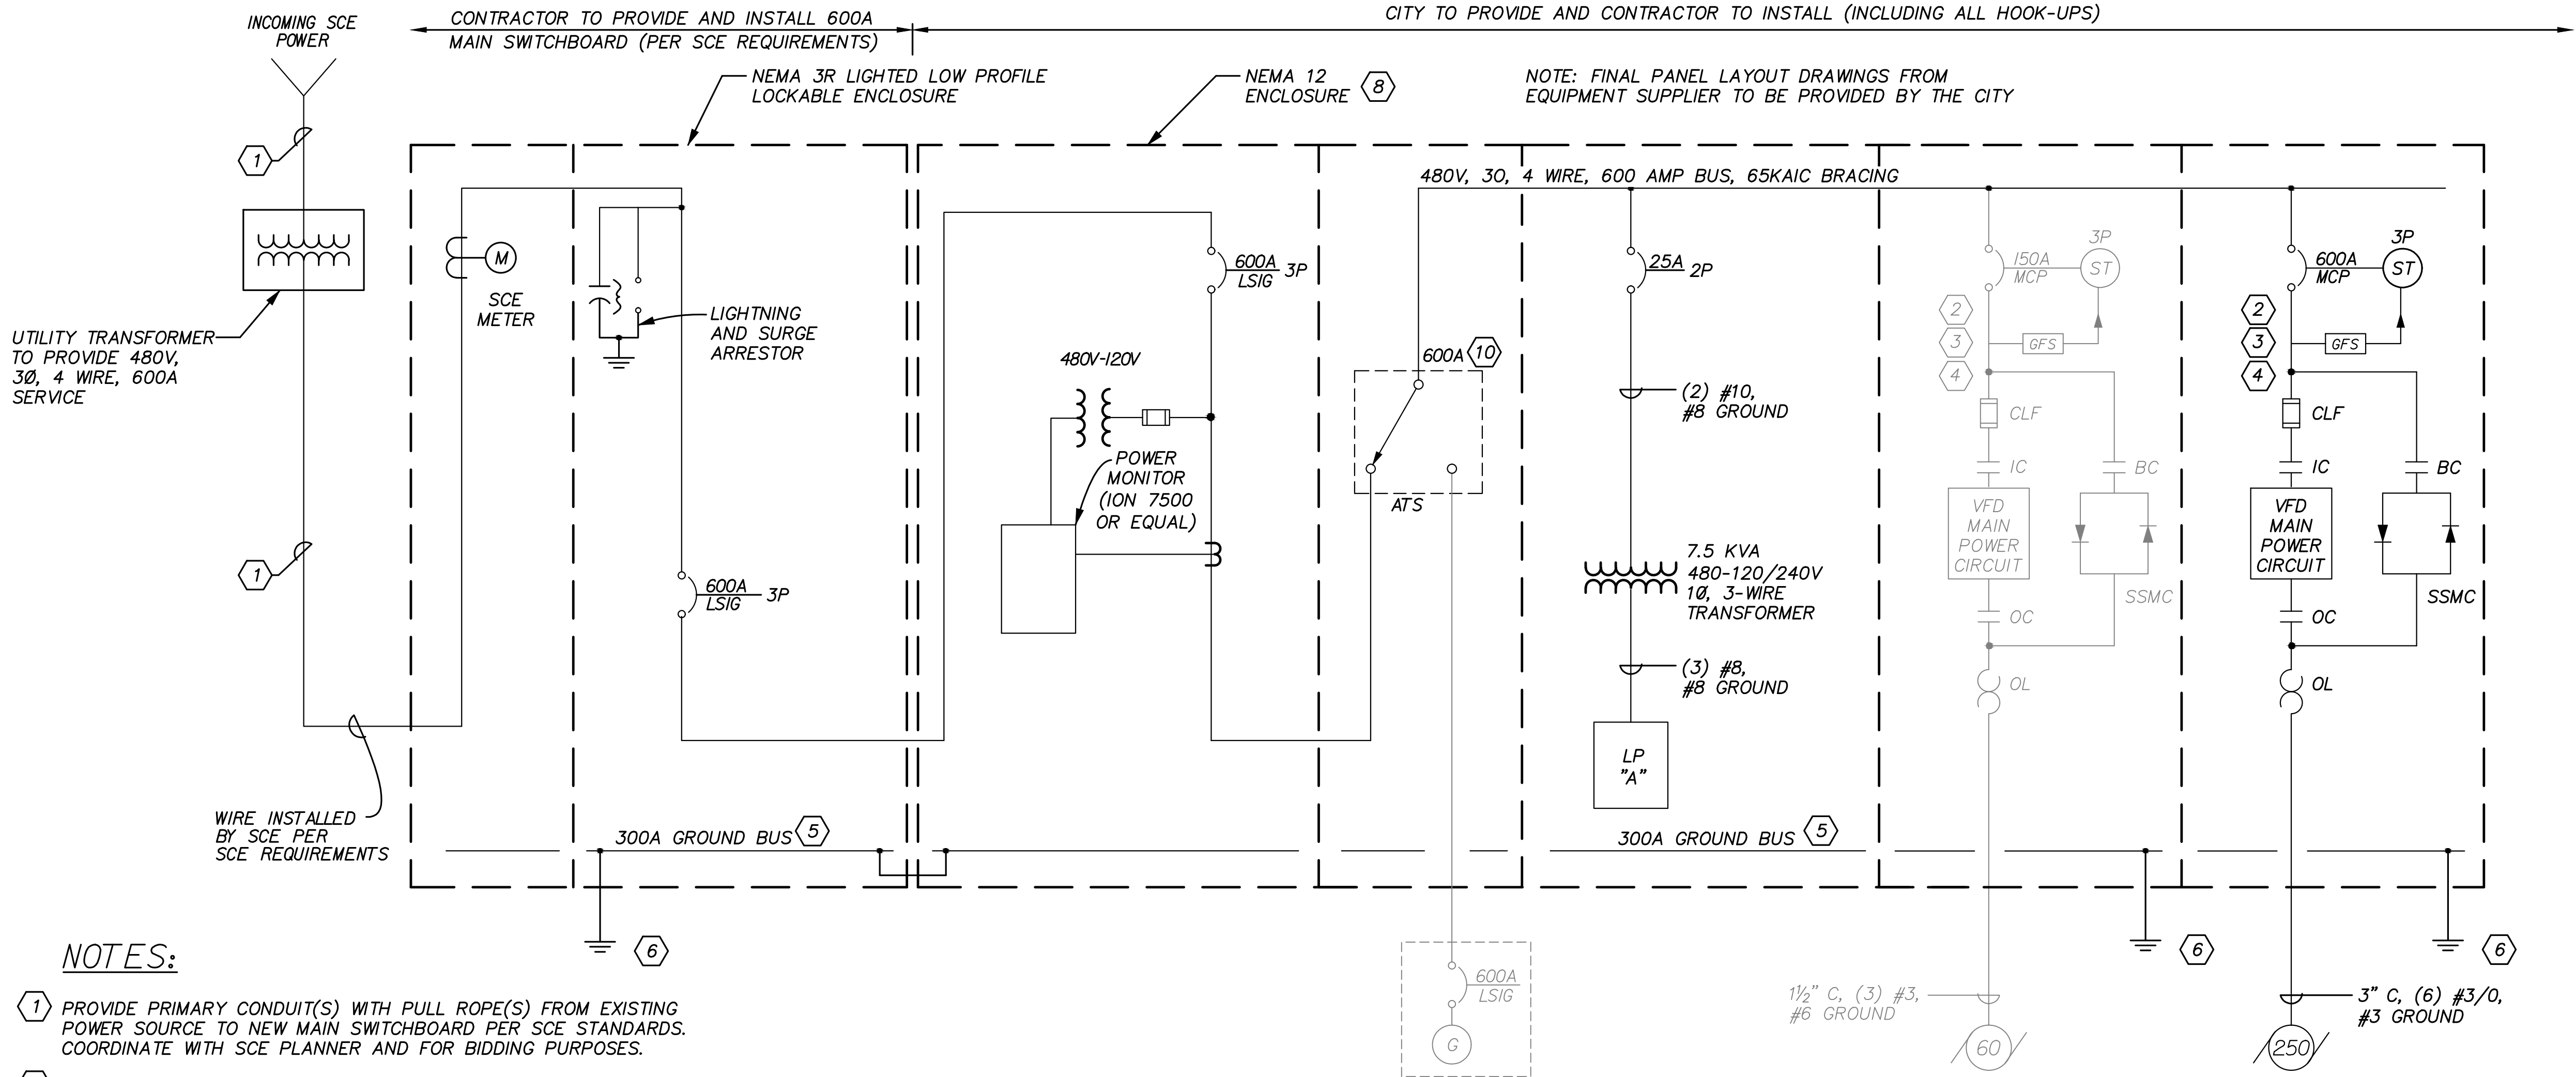


EXHAUST FAN CONTROL DIAGRAM


MASTER I/O LIST		
ITEM NO.	DESCRIPTION	SIGNAL TYPE
1	VFD WELL 33	EC
2	VFD WELL 32 (FUTURE)	EC
3	SSMC WELL 33	EC
4	SSMC WELL 32 (FUTURE)	EC
5	FLOW METER WELL 33	EC
6	FLOW METER WELL 32 (FUTURE)	EC
7	POWER MONITOR	EC
8	POWER MONITOR DISPLAY MODULE	EC
9	PLC	EC
10	HUMAN MACHINE INTERFACE (HMI)	EC
11	RADIO	EC
12	LOCAL PROGRAMMING PORT	EC
13	INTRUSION ALARM	DI
14	WELL 33 PUMP-TO-WASTE VALVE	DI
15	WELL 33 CHECK VALVE LIMIT SWITCH	DI
16	WELL 33 RUNNING	DI
17	WELL 33 VFD/SSMC FAULT	DI
18	WELL 33 IN LOCAL MODE	DI
19	WELL 33 IN REMOTE MODE	DI
20	WELL 33 POWER FAULT	DI
21	WELL 32 PUMP-TO-WASTE VALVE (FUTURE)	DI
22	WELL 32 CHECK VALVE LIMIT SWITCH (FUTURE)	DI
23	WELL 32 RUNNING (FUTURE)	DI
24	WELL 32 VFD/SSMC FAULT (FUTURE)	DI
25	WELL 32 IN LOCAL MODE (FUTURE)	DI
26	WELL 32 IN REMOTE MODE (FUTURE)	DI
27	WELL 32 POWER FAULT (FUTURE)	DI
28	WELL 33 PUMP-TO-WASTE SOLENOID VALVE	DO
29	WELL 33 START COMMAND	DO
30	WELL 32 PUMP-TO-WASTE SOLENOID VALVE (FUTURE)	DO
31	WELL 32 START COMMAND (FUTURE)	DO
32	WELL 33 LEVEL	AI
33	WELL 33 DISCHARGE PRESSURE	AI
34	WELL 32 LEVEL (FUTURE)	AI
35	WELL 32 DISCHARGE PRESSURE (FUTURE)	AI

- NOTES:**
- 1 PROVIDE PRIMARY CONDUIT(S) WITH PULL ROPE(S) FROM EXISTING POWER SOURCE TO NEW MAIN SWITCHBOARD PER SCE STANDARDS. COORDINATE WITH SCE PLANNER AND FOR BIDDING PURPOSES.
 - 2 ALL CIRCUIT BREAKERS IN THE MOTOR CONTROL CENTER SHALL HAVE AN INTERRUPTING RATING EQUAL TO OR GREATER THAN THE AVAILABLE FAULT CURRENT BUT SHALL NOT BE LESS THAN 30,000 AMPS RMS SYMMETRICAL.
 - 3 BREAKER TRIP SIZE SHALL BE COORDINATED WITH ACTUAL MOTOR INSTALLED.
 - 4 INSURE ALL LOAD BREAKERS ARE COORDINATED WITH FEEDER BREAKERS. PROVIDE COORDINATION CURVES TO THE ENGINEER.
 - 5 PROVIDE 300A GROUND BUS THE FULL LENGTH OF THE ENCLOSURE AND INSTALL UFER AND GROUND RODS.
 - 6 PROVIDE GROUNDING SYSTEM AS REQUIRED FOR GROUND RESISTANCE OF LESS THAN 5 OHMS. GROUND PER NEC ARTICLE 250.122. SEE DWG. E-6 FOR DETAIL.
 - 7 FOR MCC ELEVATION SEE HEREON.
 - 8 CITY WILL FURNISH AND CONTRACTOR TO INSTALL (INCLUDING ALL HOOK-UPS). THE MCC SHALL BE AN ALLEN BRADLEY MOTOR CONTROL CENTER CENTERLINE 2100 WITH ARCSHIELD AND SECURECONNECT, WITH AN ALLEN BRADLEY POWERFLEX 755 DRIVE (CITY STANDARD) RATED FOR INVERTER DUTY MOTORS.
 - 9 CONDUITS BELOW GRADE TO BE SCHEDULE 80 PVC, AND ABOVE GRADE TO BE PVC COATED RIGID METAL PER SPECIFICATIONS.
 - 10 600A THREE POLE DOUBLE THROW 3-PHASE AUTOMATIC TRANSFER SWITCH, ASCO 7000 SERIES.

WELLS 32 & 33 SINGLE LINE POWER DIAGRAM

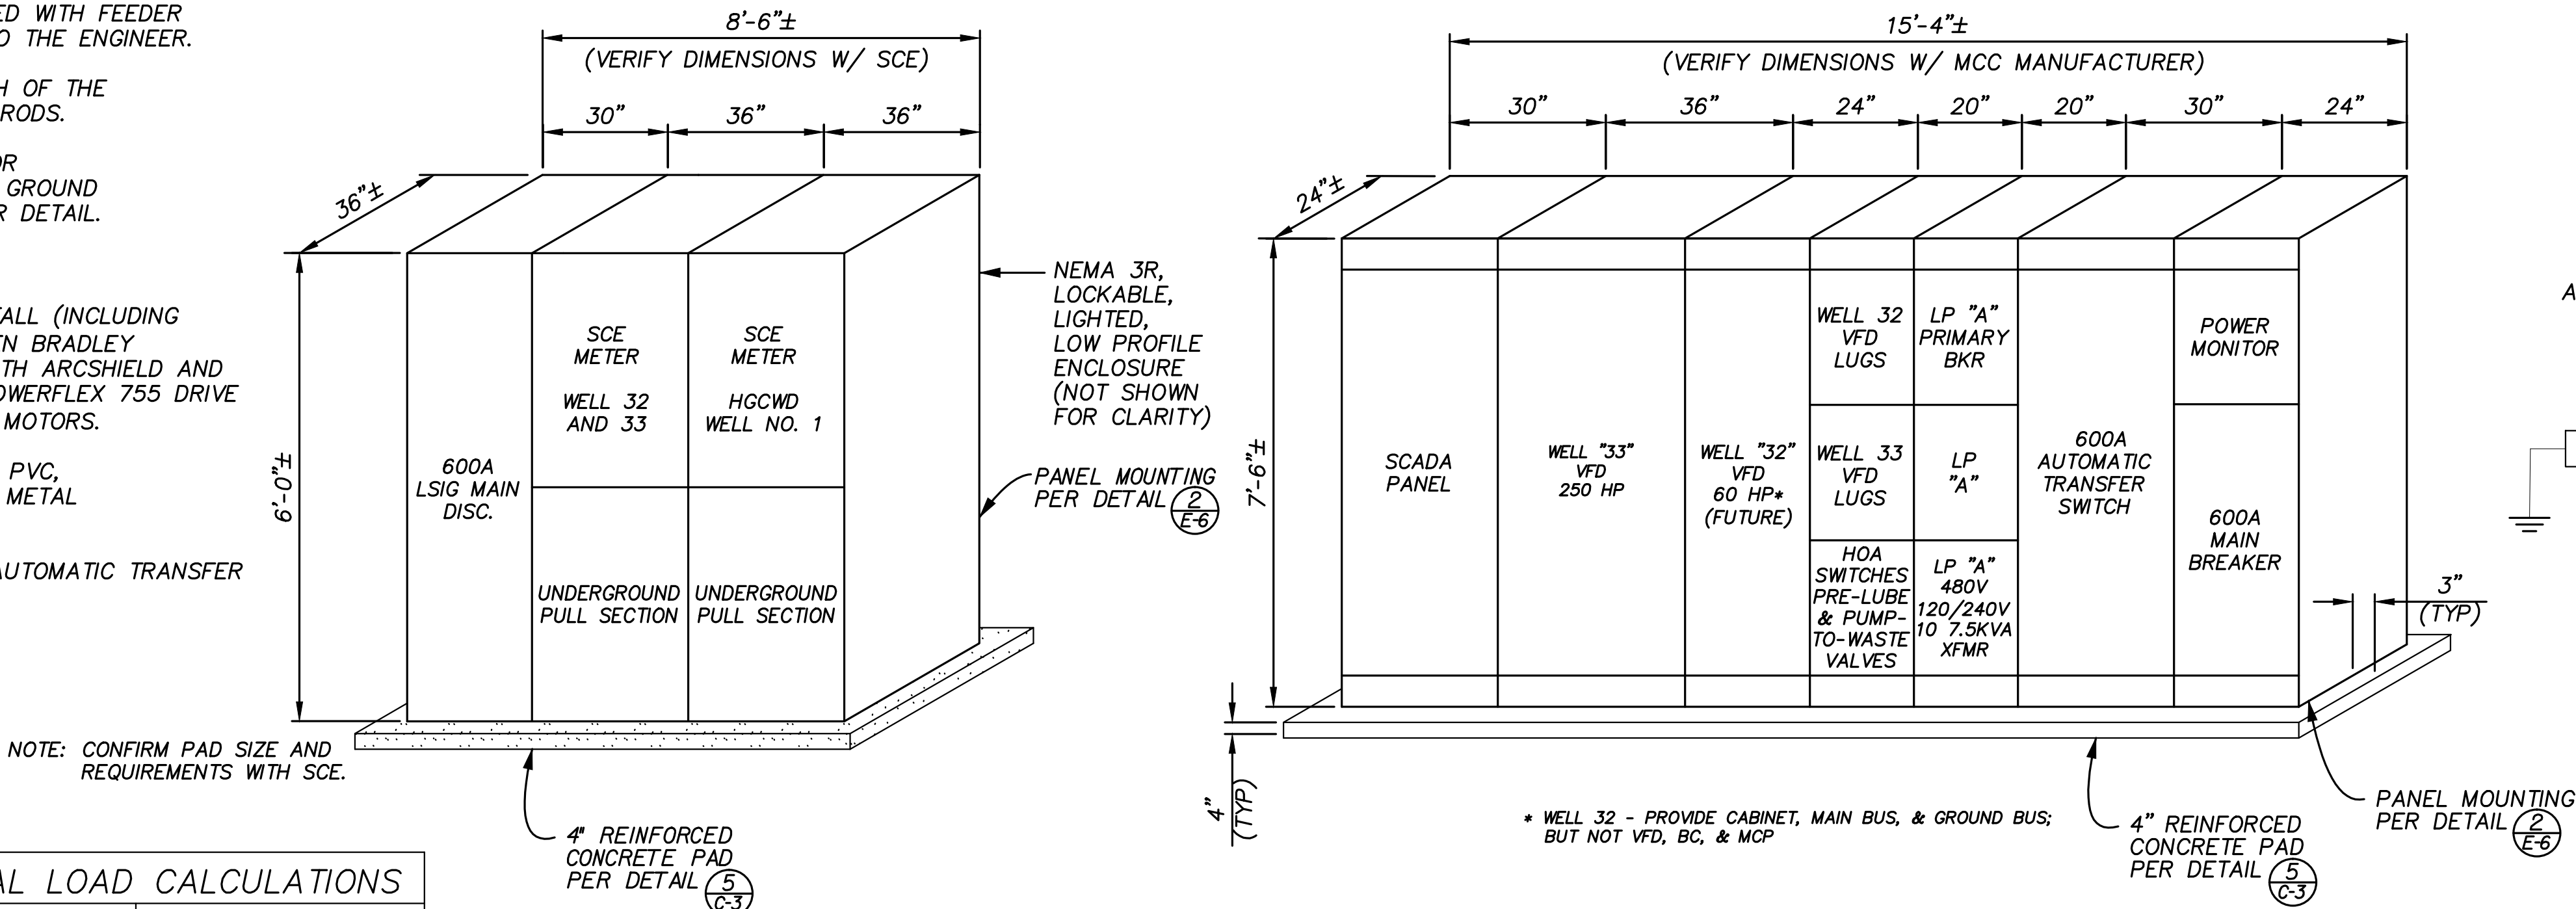

SWITCHBOARD AND MOTOR CONTROL CENTER ELEVATION
NOT TO SCALE

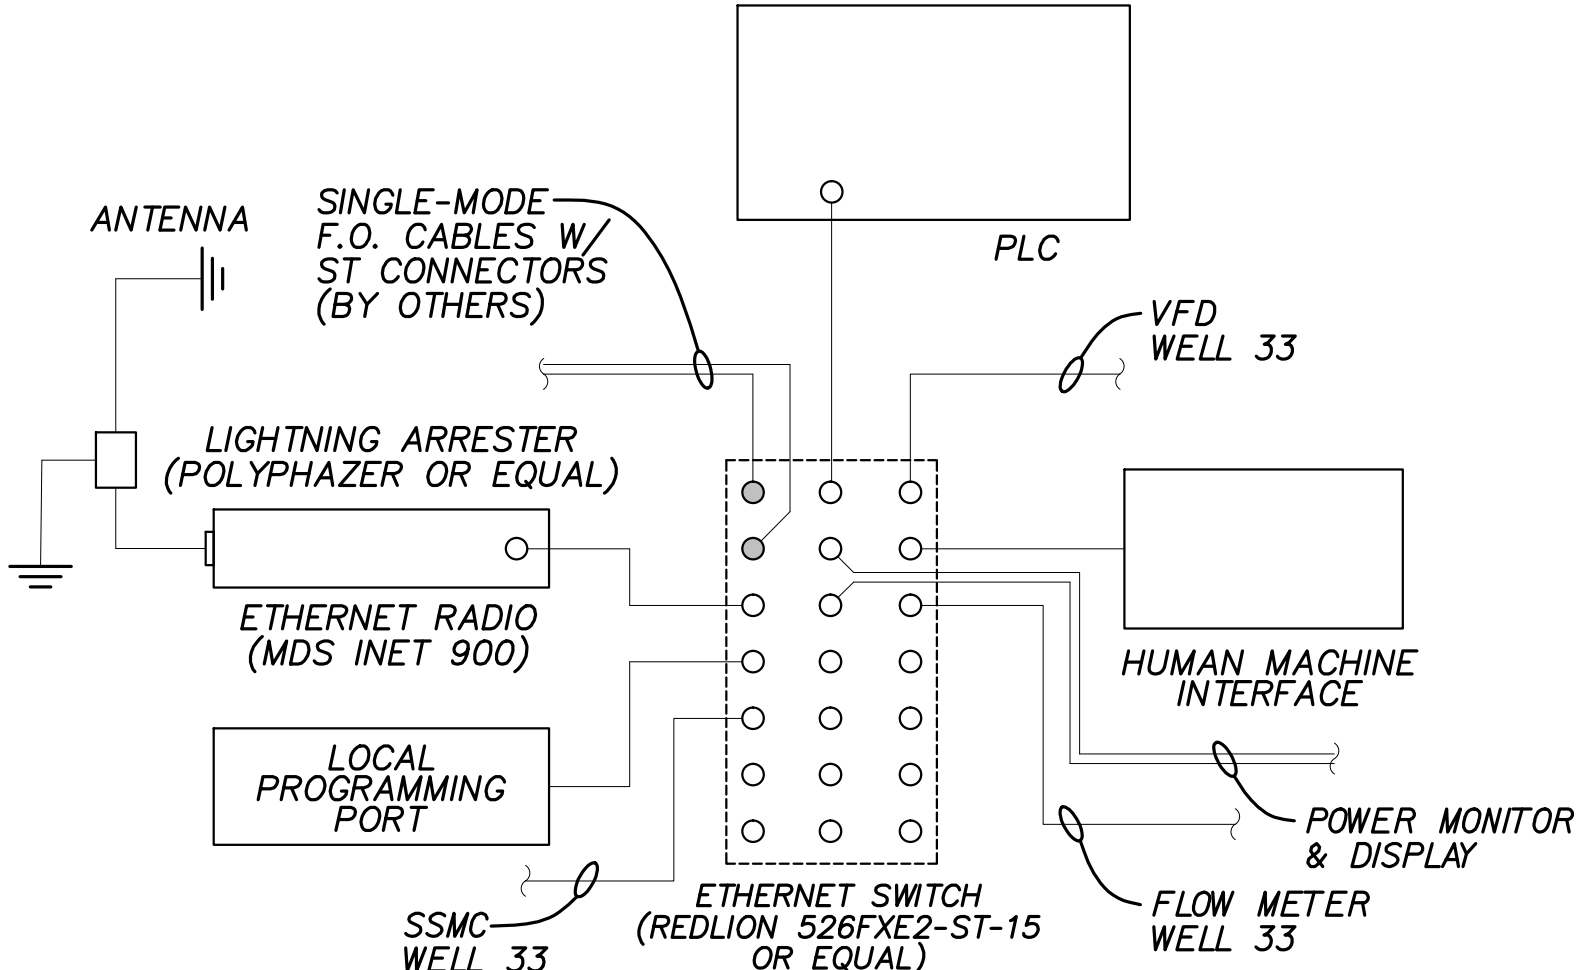

ETHERNET SWITCH
CONNECTION DIAGRAM

AKM JOB No. 0761209.00

Underground Service Alert
Call: TOLL FREE

811

TWO WORKING DAYS BEFORE YOU DIG

ELECTRICAL LOAD CALCULATIONS	
DESCRIPTION	LOAD (AMPS)
WELL PUMP 32 (FUTURE)	77
WELL PUMP 33	302
LOAD CENTER	22
25% OF LARGEST LOAD	76
TOTAL LOAD	477

Designed by D. BAKER
Drawn by M.U. R.U.
Checked by G. HOBSON

PLANS PREPARED UNDER SUPERVISION OF
GARY J. HOBSON
R.C.E. No. 40779

Date JULY 2017

Reference Plans for these Improvements

Date By

REVISIONS

App'd

AKM AKM CONSULTING ENGINEERS
553 WALD IRVINE, CA 92618
(949) 753-7333


Engineering
Operations

Department of Water and Power Approval
By: Vernon R. Weisman, P.E.
District Engineer
R.C.E. No. 41610

CITY OF CORONA - RESIN TREATMENT OF NITRATE SOURCES
WELLS 32 AND 33 EQUIPPING
ELECTRICAL SINGLE LINE DIAGRAM AND CONTROL DIAGRAMS

Drawing No. 13-038U
E-2
Sht. 16 of 21




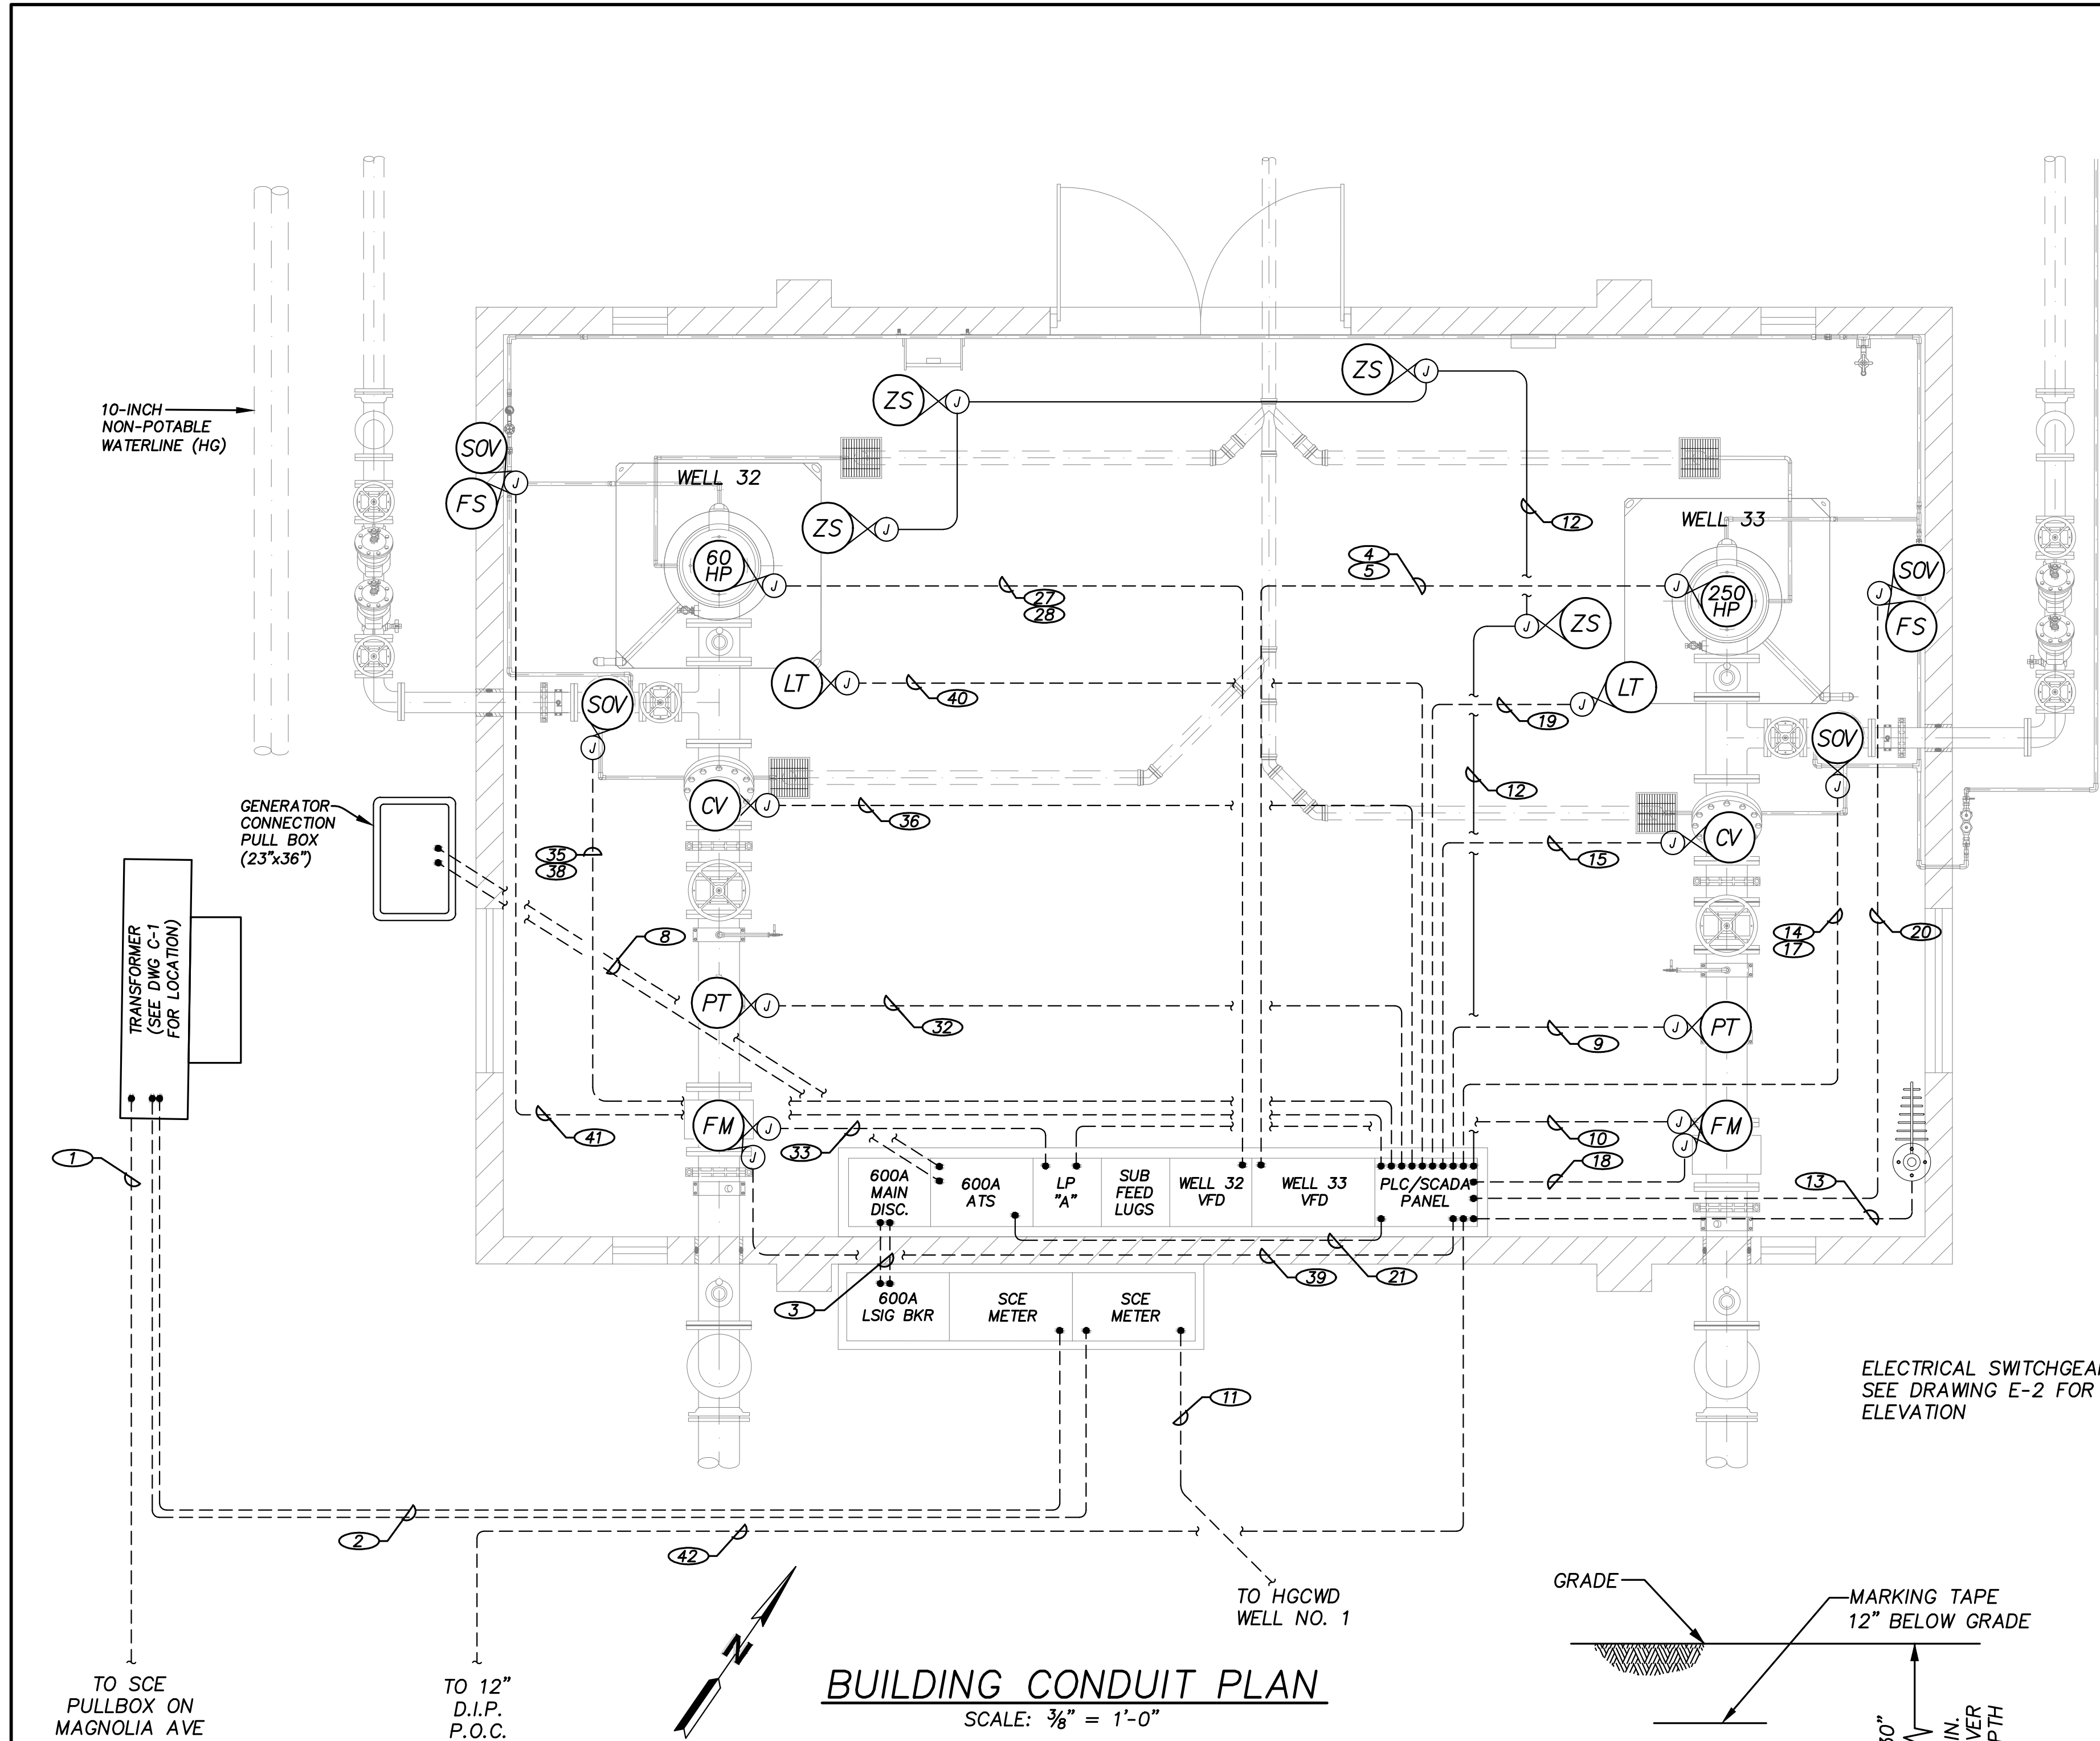

BUILDING CONDUIT PLAN
SCALE: 3/8" = 1'-0"

NOTES:

1. CONDUIT PLAN IS DIAGRAMATIC. CONTRACTOR SHALL ROUTE CONDUITS AS NECESSARY FOR FIELD CONDITIONS. CONDUIT ROUTING SHALL NOT CREATE TRIPPING HAZARDS IN THE BUILDING.
2. ALL ABOVE GRADE CONDUITS SHALL BE PVC COATED RIGID GALVANIZED STEEL.
3. -----DENOTES CONCEALED/BURIED CONDUIT.
4. -----DENOTES CONDUIT SUPPORTED ON WALL OR FROM CEILING.
5. ALL BURIED CONDUITS (EXCEPT THOSE UNDER BUILDING SLAB SHALL BE CONCRETE ENCASED PER DETAIL 1).
6. INSTALLATION OF PROTECTIVE BARRIERS SHALL CONFORM WITH SCE REQUIREMENTS.

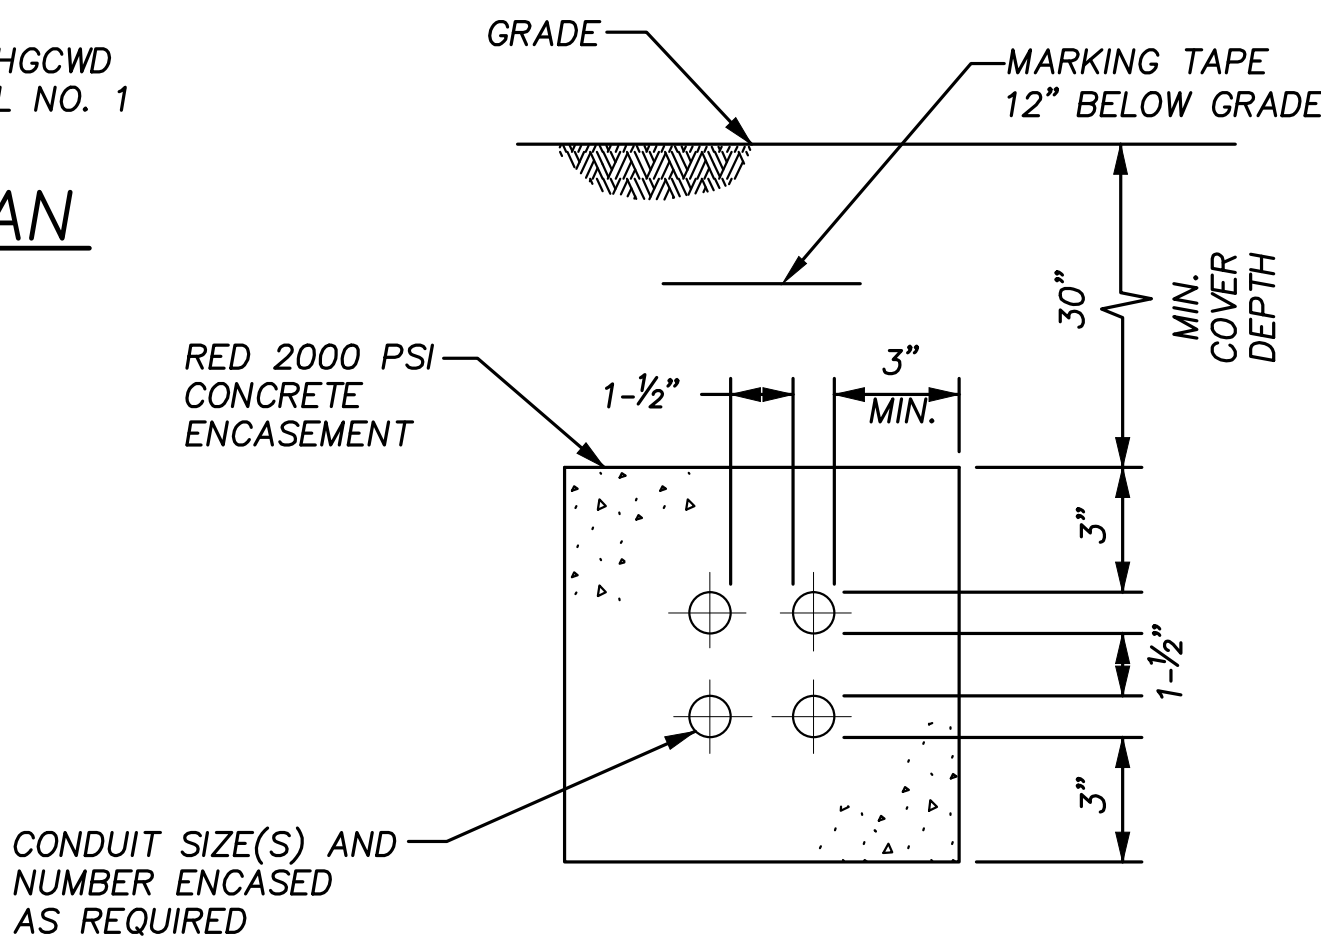

NOTE:
ALL BURIED CONDUIT SHALL BE RED CONCRETE ENCASED.
MINIMUM CONDUIT SIZE BELOW GROUND SHALL BE 1"

ENCASED CONDUIT DETAIL

NOT TO SCALE

1
--

CONDUIT SCHEDULE

CONDUIT		CABLE		FROM	TO	REMARKS
NO.	SIZE	QTY	SIZE			
1	5"		PULL ROPE	SCE PULLBOX	SCE TRANSFORMER	PULL ROPE ONLY, CABLE BY SCE
2	(2) 5"		PULL ROPE	SCE TRANSFORMER	SCE METER	PULL ROPE ONLY, CABLE BY SCE
3	(2) 3"	6, 2	#350 MCM, #1	SWITCHBOARD	MCC	480V, 3Ø POWER, GROUND
4	3"	6, 1	#3/0, #3	WELL 33 VFD	WELL 33 PUMP MOTOR	480V, 3Ø POWER, GROUND
5	1"	4	#12	WELL 33 PUMP MOTOR	WELL 33 VFD	SPACE HEATER, MOTOR TEMP SWITCH
8	(2) 4"		PULL ROPES	GENERATOR CONNECTION PULL BOX	ATS	PULL ROPE ONLY, CABLE BY CITY
9	1"	1	#16 TSP	WELL 33 PRESSURE TRANSDUCER	PLC/SCADA	PRESSURE SIGNAL
10	1"	2, 1	#12, #12	LP "A" - CKT 6	WELL 33 FLOWMETER DISPLAY	120V, 1Ø POWER, GROUND
11	5"	-	-	HOME GARDENS SCE METER	HOME GARDENS WELL #1	PULL ROPE ONLY CABLE BY OTHERS
12	1"	2	#12	DOOR/HATCH MOUNTED LIMIT SWITCH	PLC/SCADA	INTRUSION ALARMS DOOR & ROOF HATCHES
13	2"		ANTENNA CABLE BY RADIO SUPPLIER	ANTENNA	ETHERNET RADIO	ANTENNA CABLE
14	1"	4	#12	PLC/SCADA	WELL 33 DISCHARGE TO WASTE VALVE	OPEN/CLOSE SIGNAL
15	1"	2, 1	#12, #12	CHECK VALVE LIMIT SWITCH	PLC/SCADA	CHECK VALVE POSITION
17	1"	2	#12	WELL 33 DISCHARGE TO WASTE VALVE	PLC/SCADA	LIMIT SWITCH
18	1"		ETHERNET CABLE PROVIDED BY FLOWMETER SUPPLIER	WELL 33 FLOWMETER DISPLAY	ETHERNET SWITCH	FLOW SIGNAL
19	1"	1	#16 TSP	WELL 33 LEVEL DISPLAY	PLC/SCADA	LEVEL SIGNAL
20	1"	4	#12	PLC/SCADA	WELL 33 SOLENOID VALVE/ FLOW SWITCH	OPEN/CLOSE
21	1"		RS-232 CABLE	ATS	PLC/SCADA	ATS SIGNALS
* 27	1 1/2"	3, 1	#3, #6	WELL 32 VFD	WELL 32 PUMP MOTOR	480V, 3Ø POWER, GROUND
* 28	1"	4	#12	WELL 32 PUMP MOTOR	WELL 32 VFD	SPACE HEATER, MOTOR TEMP SWITCH
* 32	1"	1	#16 TSP	WELL 32 PRESSURE TRANSDUCER	PLC/SCADA	PRESSURE SIGNAL
* 33	1"	2, 1	#12, #12	LP "A" - CKT 7	WELL 32 FLOWMETER DISPLAY	120V, 1Ø POWER, GROUND
* 35	1"	4	#12	PLC/SCADA	WELL 32 DISCHARGE TO WASTE VALVE	OPEN/CLOSE SIGNAL
* 36	1"	2, 1	#12, #12	CHECK VALVE LIMIT SWITCH	PLC/SCADA	CHECK VALVE LIMIT SWITCH
* 38	1"	2	#12	WELL 32 DISCHARGE TO WASTE VALVE	PLC/SCADA	LIMIT SWITCH
* 39	1"		ETHERNET CABLE PROVIDED BY FLOWMETER SUPPLIER	WELL 32 FLOWMETER DISPLAY	ETHERNET SWITCH	FLOW SIGNAL
* 40	1"	1	#16 TSP	WELL 32 LEVEL DISPLAY	PLC/SCADA	LEVEL SIGNAL
* 41	1"	4	#12	PLC/SCADA	WELL 32 SOLENOID VALVE/ FLOW SWITCH	OPEN/CLOSE
42	2"		PULL ROPES	12" D.I.P. P.O.C.	PLC/SCADA	PULL ROPE ONLY, F.O. BY OTHERS


* PROVIDE CONDUITS AND PULL ROPES, BUT NO WIRES FOR WELL 32.

AKM JOB No. 0761209.00

Underground Service Alert
Call: TOLL FREE



TWO WORKING DAYS BEFORE YOU DIG

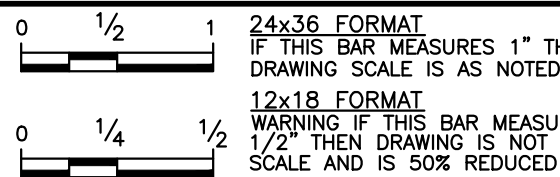

Designed by
D. BAKER

Drawn by
M.U. R.U.

Checked by
G. HOBSON

PLANS PREPARED UNDER SUPERVISION OF
GARY J. HOBSON
R.C.E. No. 40779

Date JULY 2017

Reference Plans for these Improvements

Date

By

REVISIONS

App'd



AKM CONSULTING ENGINEERS
553 WALD
IRVINE, CA. 92618
(949) 753-7333

Engineering _____
Operations _____

Department of Water and Power Approval
By: *Vernon R. Weisman* 8/8/2017
Vernon R. Weisman, P.E.
District Engineer
R.C.E. No. 41610

CITY OF CORONA - RESIN TREATMENT OF NITRATE SOURCES
WELLS 32 AND 33 EQUIPPING
CONDUIT PLAN


Drawing No.

13-038U

E-3

Sht. 17 of 21



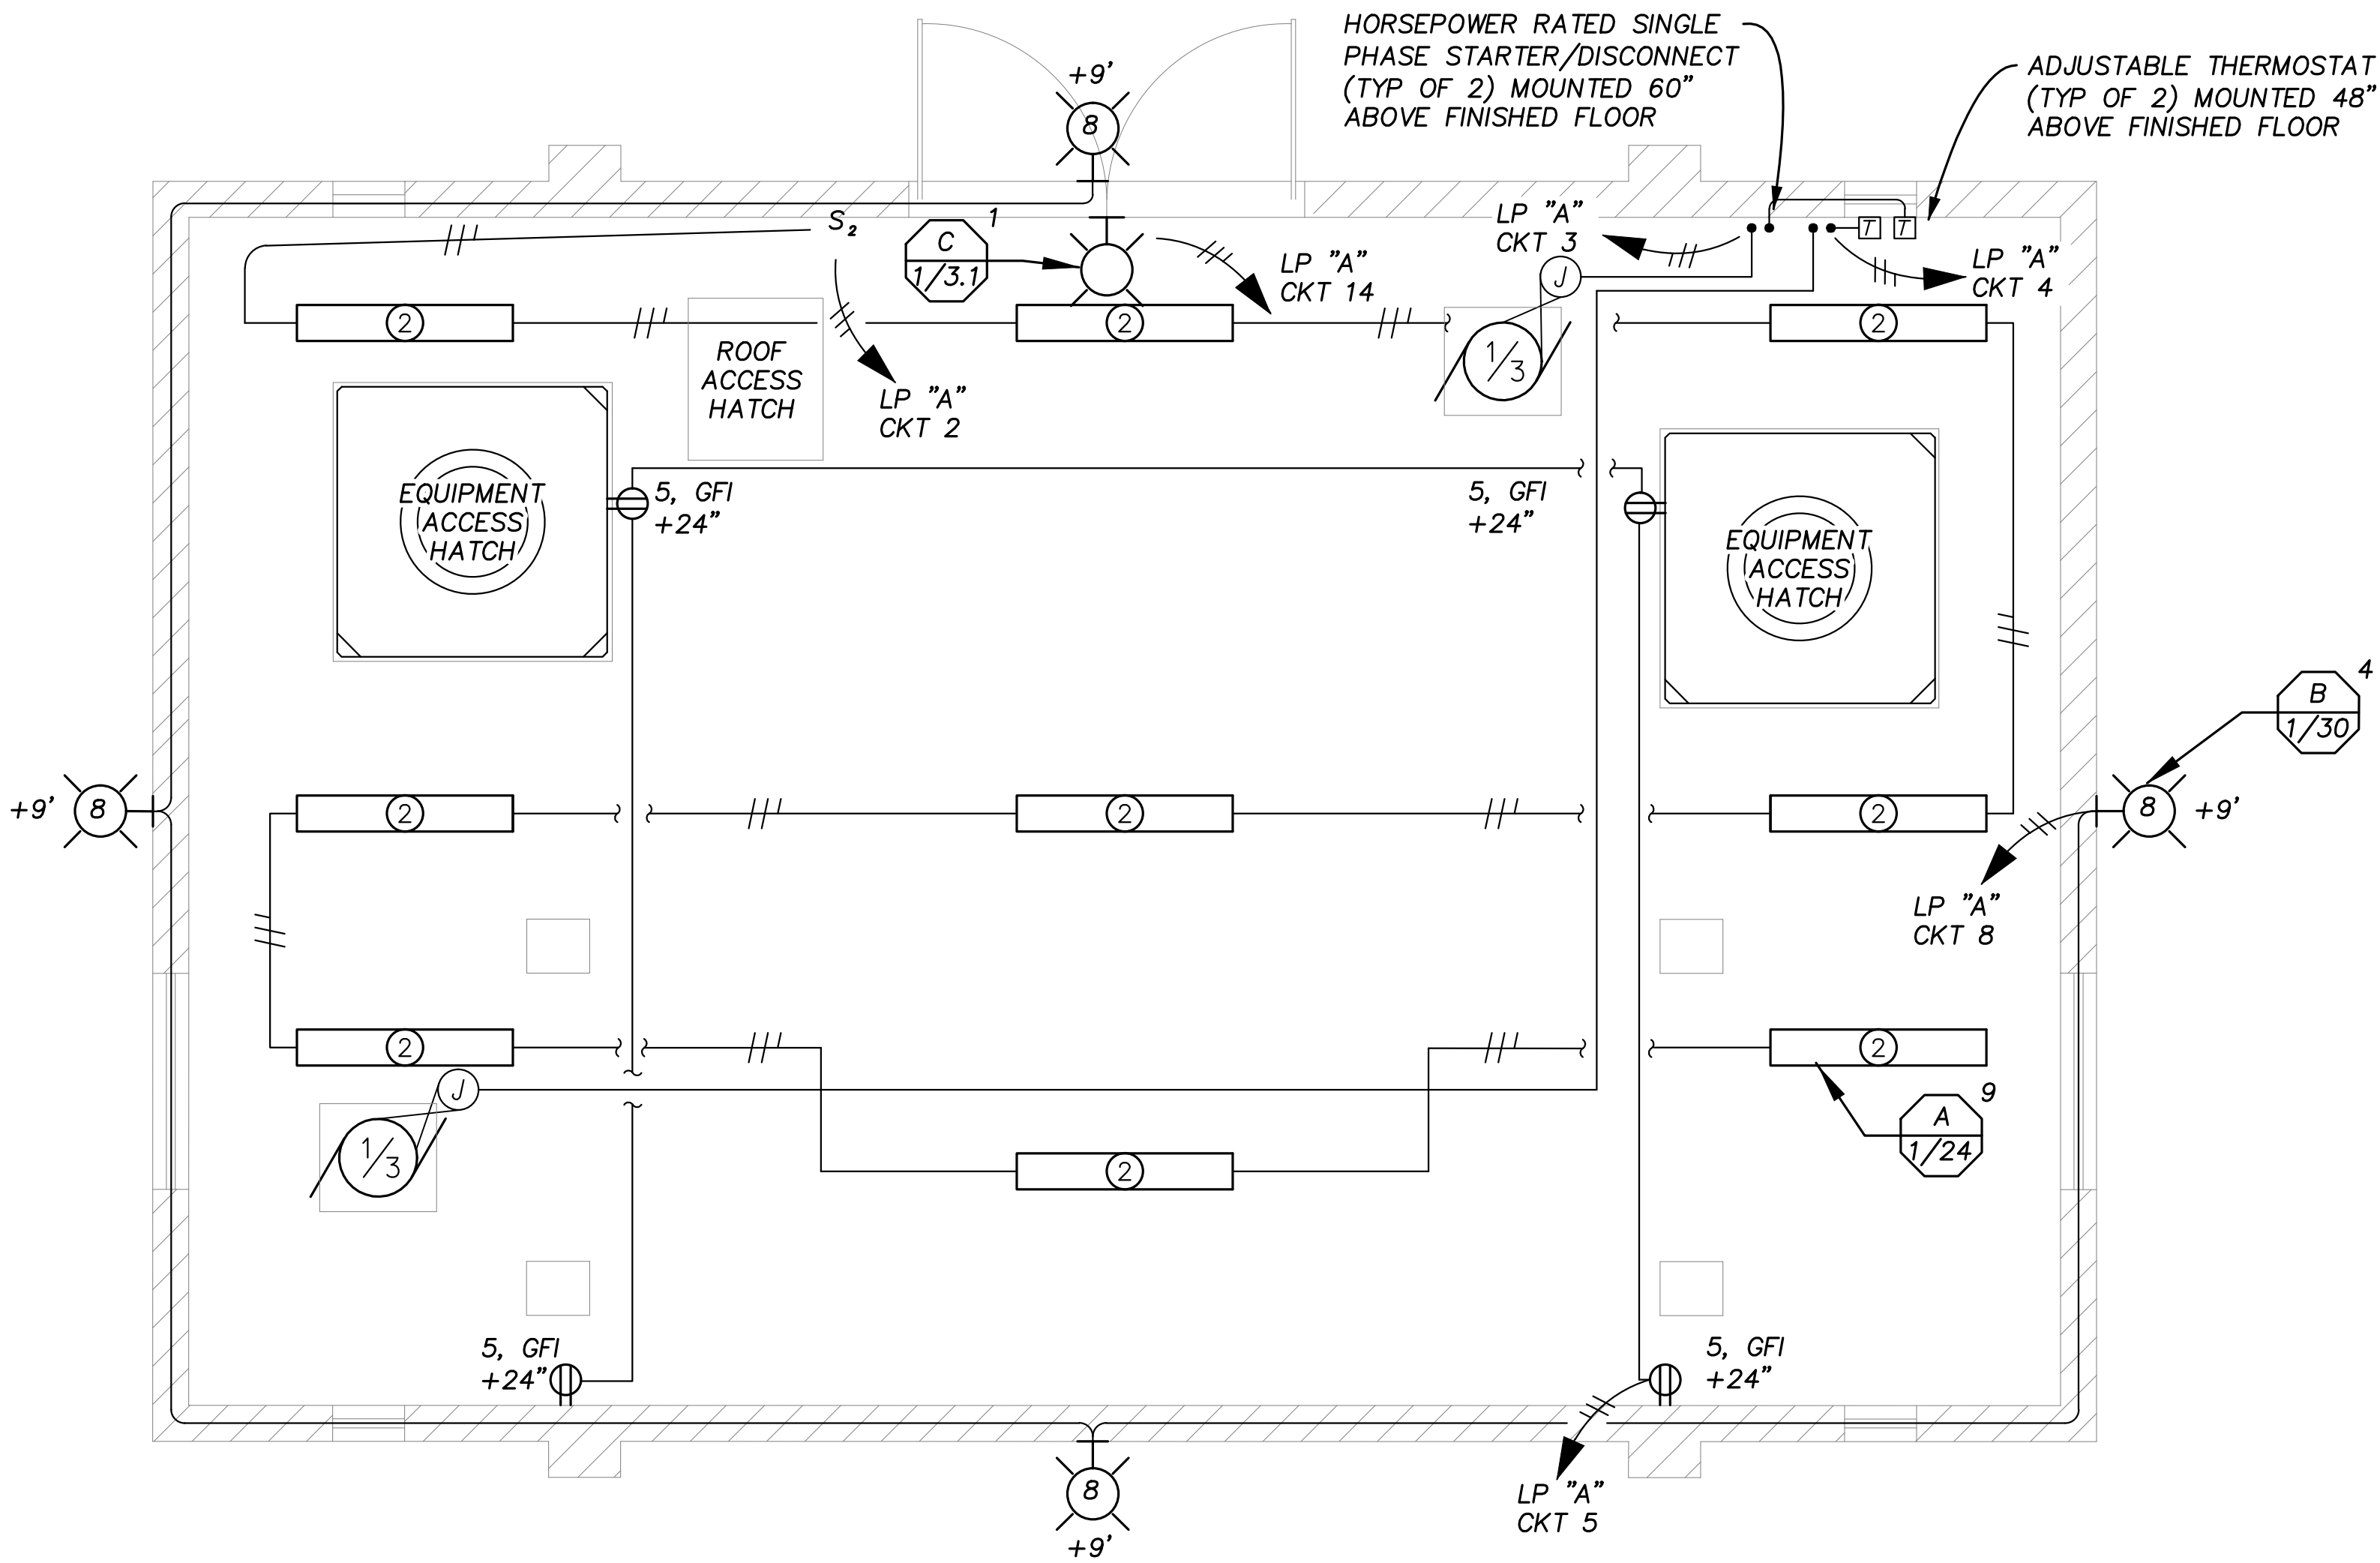

BUILDING LIGHTING AND RECEPTACLE PLAN
SCALE: 3/8" = 1'-0"


NOTES:

- CONDUIT PLAN IS DIAGRAMATIC. CONTRACTOR SHALL ROUTE CONDUITS AS NECESSARY FOR FIELD CONDITIONS. CONDUIT ROUTING SHALL NOT CREATE TRIPPING HAZARDS IN THE BUILDING.
- ALL ABOVE GRADE CONDUITS SHALL BE PVC COATED RIGID GALVANIZED STEEL.
- DENOTES CONCEALED/BURIED CONDUIT.
- DENOTES CONDUIT SUPPORTED ON WALL OR FROM CEILING.
- ALL BURIED CONDUITS SHALL BE CONCRETE ENCASED PER DETAIL 1.
- INSTALLATION OF PROTECTIVE BARRIERS SHALL CONFORM WITH SCE REQUIREMENTS.


MOUNTING MCC		PANEL LP-A		MAIN 40 A CB	
240/120	VOLTS 1	PHASE 3	WIRE	BUS 60 AMP	
WATTAGE	OTHER	Ø A	Ø B	WATTAGE	Ø A Ø B
100	PLC/SCADA	1	15 1	216	
900	EXHAUST FAN 1	1	15 3	900	
720	GFI RECEPTACLE	4	1 15 5	100	
-	100 FLOW METER 1	1	15 7	120	
-	200 SPARE	1	15 9	-	
-	GEN. ENCLOSURE	1	15 11	-	
-	SPARE	1	15 13	100	
-	SPARE	1	15 15	-	
-	SPARE	1	15 17	-	
820	1200	WATTS/LINE		416	1020
TOTAL WATTS = 3,456		AMPS/LINE		AMPS = 14.4	
				LCL AMPS = 18.0	

CIRCUIT NUMBERS ARE FOR REFERENCE. CONTRACTOR SHALL BALANCE LOADS, UNLESS OTHERWISE NOTED/SHOWN PROVIDE 1" C, (2) #12 AND (1) #12 GROUND FOR EACH CIRCUIT TO DEVICE AND/OR SWITCH

LOAD CENTER SCHEDULE

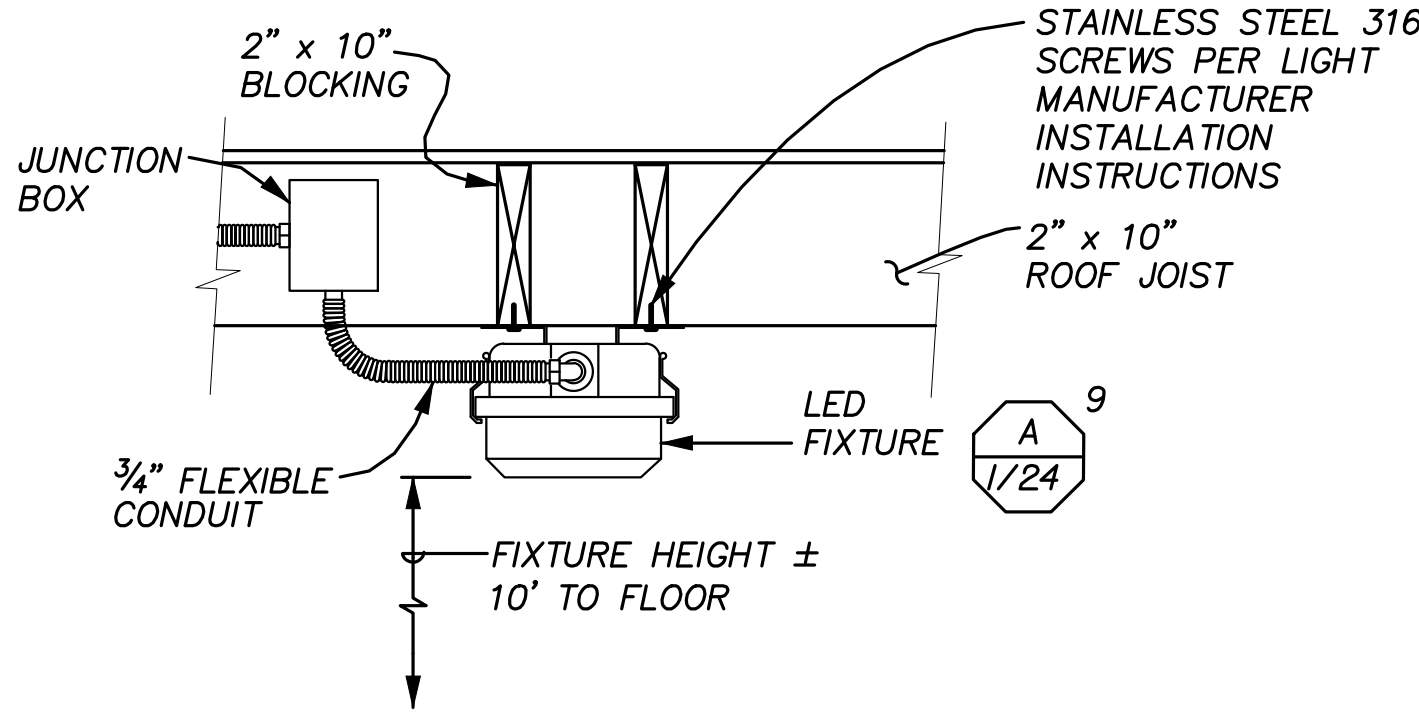

LED FIXTURE MOUNTING DETAIL 1
NOT TO SCALE

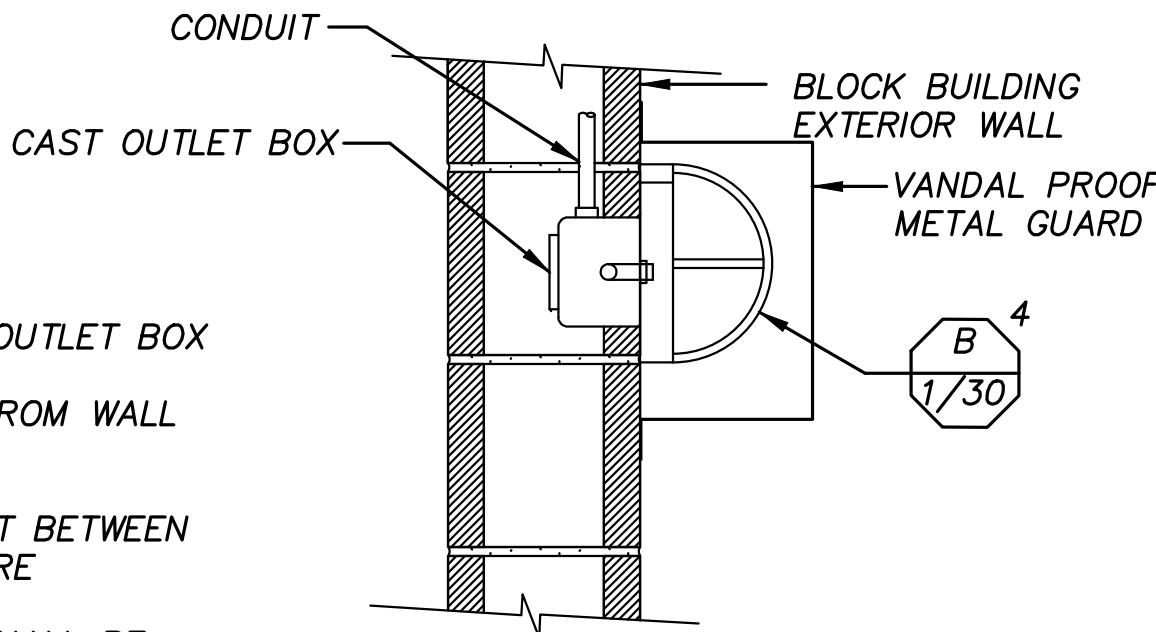

NOTES:

- PROVIDE CAST OUTLET BOX
- SET BOX OUT FROM WALL AS SHOWN
- PROVIDE GASKET BETWEEN BOX AND FIXTURE
- INSTALLATION SHALL BE WATER-TIGHT
- SEE FIXTURE SCHEDULE FOR FIXTURE DESCRIPTION


**WALL HUNG EXTERIOR
FIXTURE MOUNTING DETAIL 2**
NOT TO SCALE

MARK	VOLTAGE	DESCRIPTION	DETAIL
A 1/24	120 VAC	LED WET LOCATION STRIPLIGHT BY LITHONIA LIGHTING, MODEL XWMLD	1
B 1/30	120 VAC	LED WALL MOUNTED LUMINAIRES, WEATHERPROOF UL 1598 RATED FOR WET LOCATION USE, FULL CUTOFF LIGHTING WITH PHOTOCONTROL OPTION, HUBBELL LAREDO LCC COMPACT WALLPACK LCC-1211-2-PCI	2
C 1/3.1	120 VAC	LED SURFACE MOUNTED INTERIOR LOW-PROFILE ALUMINUM EXIT SIGNS (GREEN EMERGENCY WITH NICKEL-CADMIUM AND AUTOMATIC CHARGER) SHALL BE HUBBELL MODEL LEDS-1-EM-G-WW	--

LIGHTING FIXTURE SCHEDULE

AKM JOB No. 0761209.00

Underground Service Alert
Call: TOLL FREE

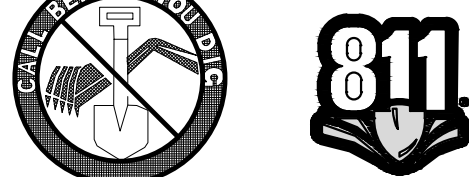

TWO WORKING DAYS BEFORE YOU DIG

0 1/2 1 24x36 FORMAT
IF THIS BAR MEASURES 1" THEN
DRAWING SCALE IS AS NOTED
0 1/4 1/2 12x18 FORMAT
WARNING IF THIS BAR MEASURES
1/2" THEN DRAWING IS NOT FULL
SCALE AND IS 50% REDUCED

Designed by D. BAKER
Drawn by M.U. R.U.
Checked by G. HOBSON
PLANS PREPARED UNDER SUPERVISION OF
GARY J. HOBSON
R.C.E. No. 40779
Date JULY 2017

Reference Plans for
these Improvements

Date

By

REVISIONS

App'd



AKM CONSULTING ENGINEERS
553 WALD
IRVINE, CA. 92618
(949) 753-7333


Engineering
Operations

Department of Water and Power Approval
By: Vernon R. Weisman, P.E.
District Engineer
R.C.E. No. 41610




CITY OF CORONA - RESIN TREATMENT OF NITRATE SOURCES
WELLS 32 AND 33 EQUIPPING
LIGHTING PLAN

Drawing No.
13-038U
E-4
Sht. 18 of 21



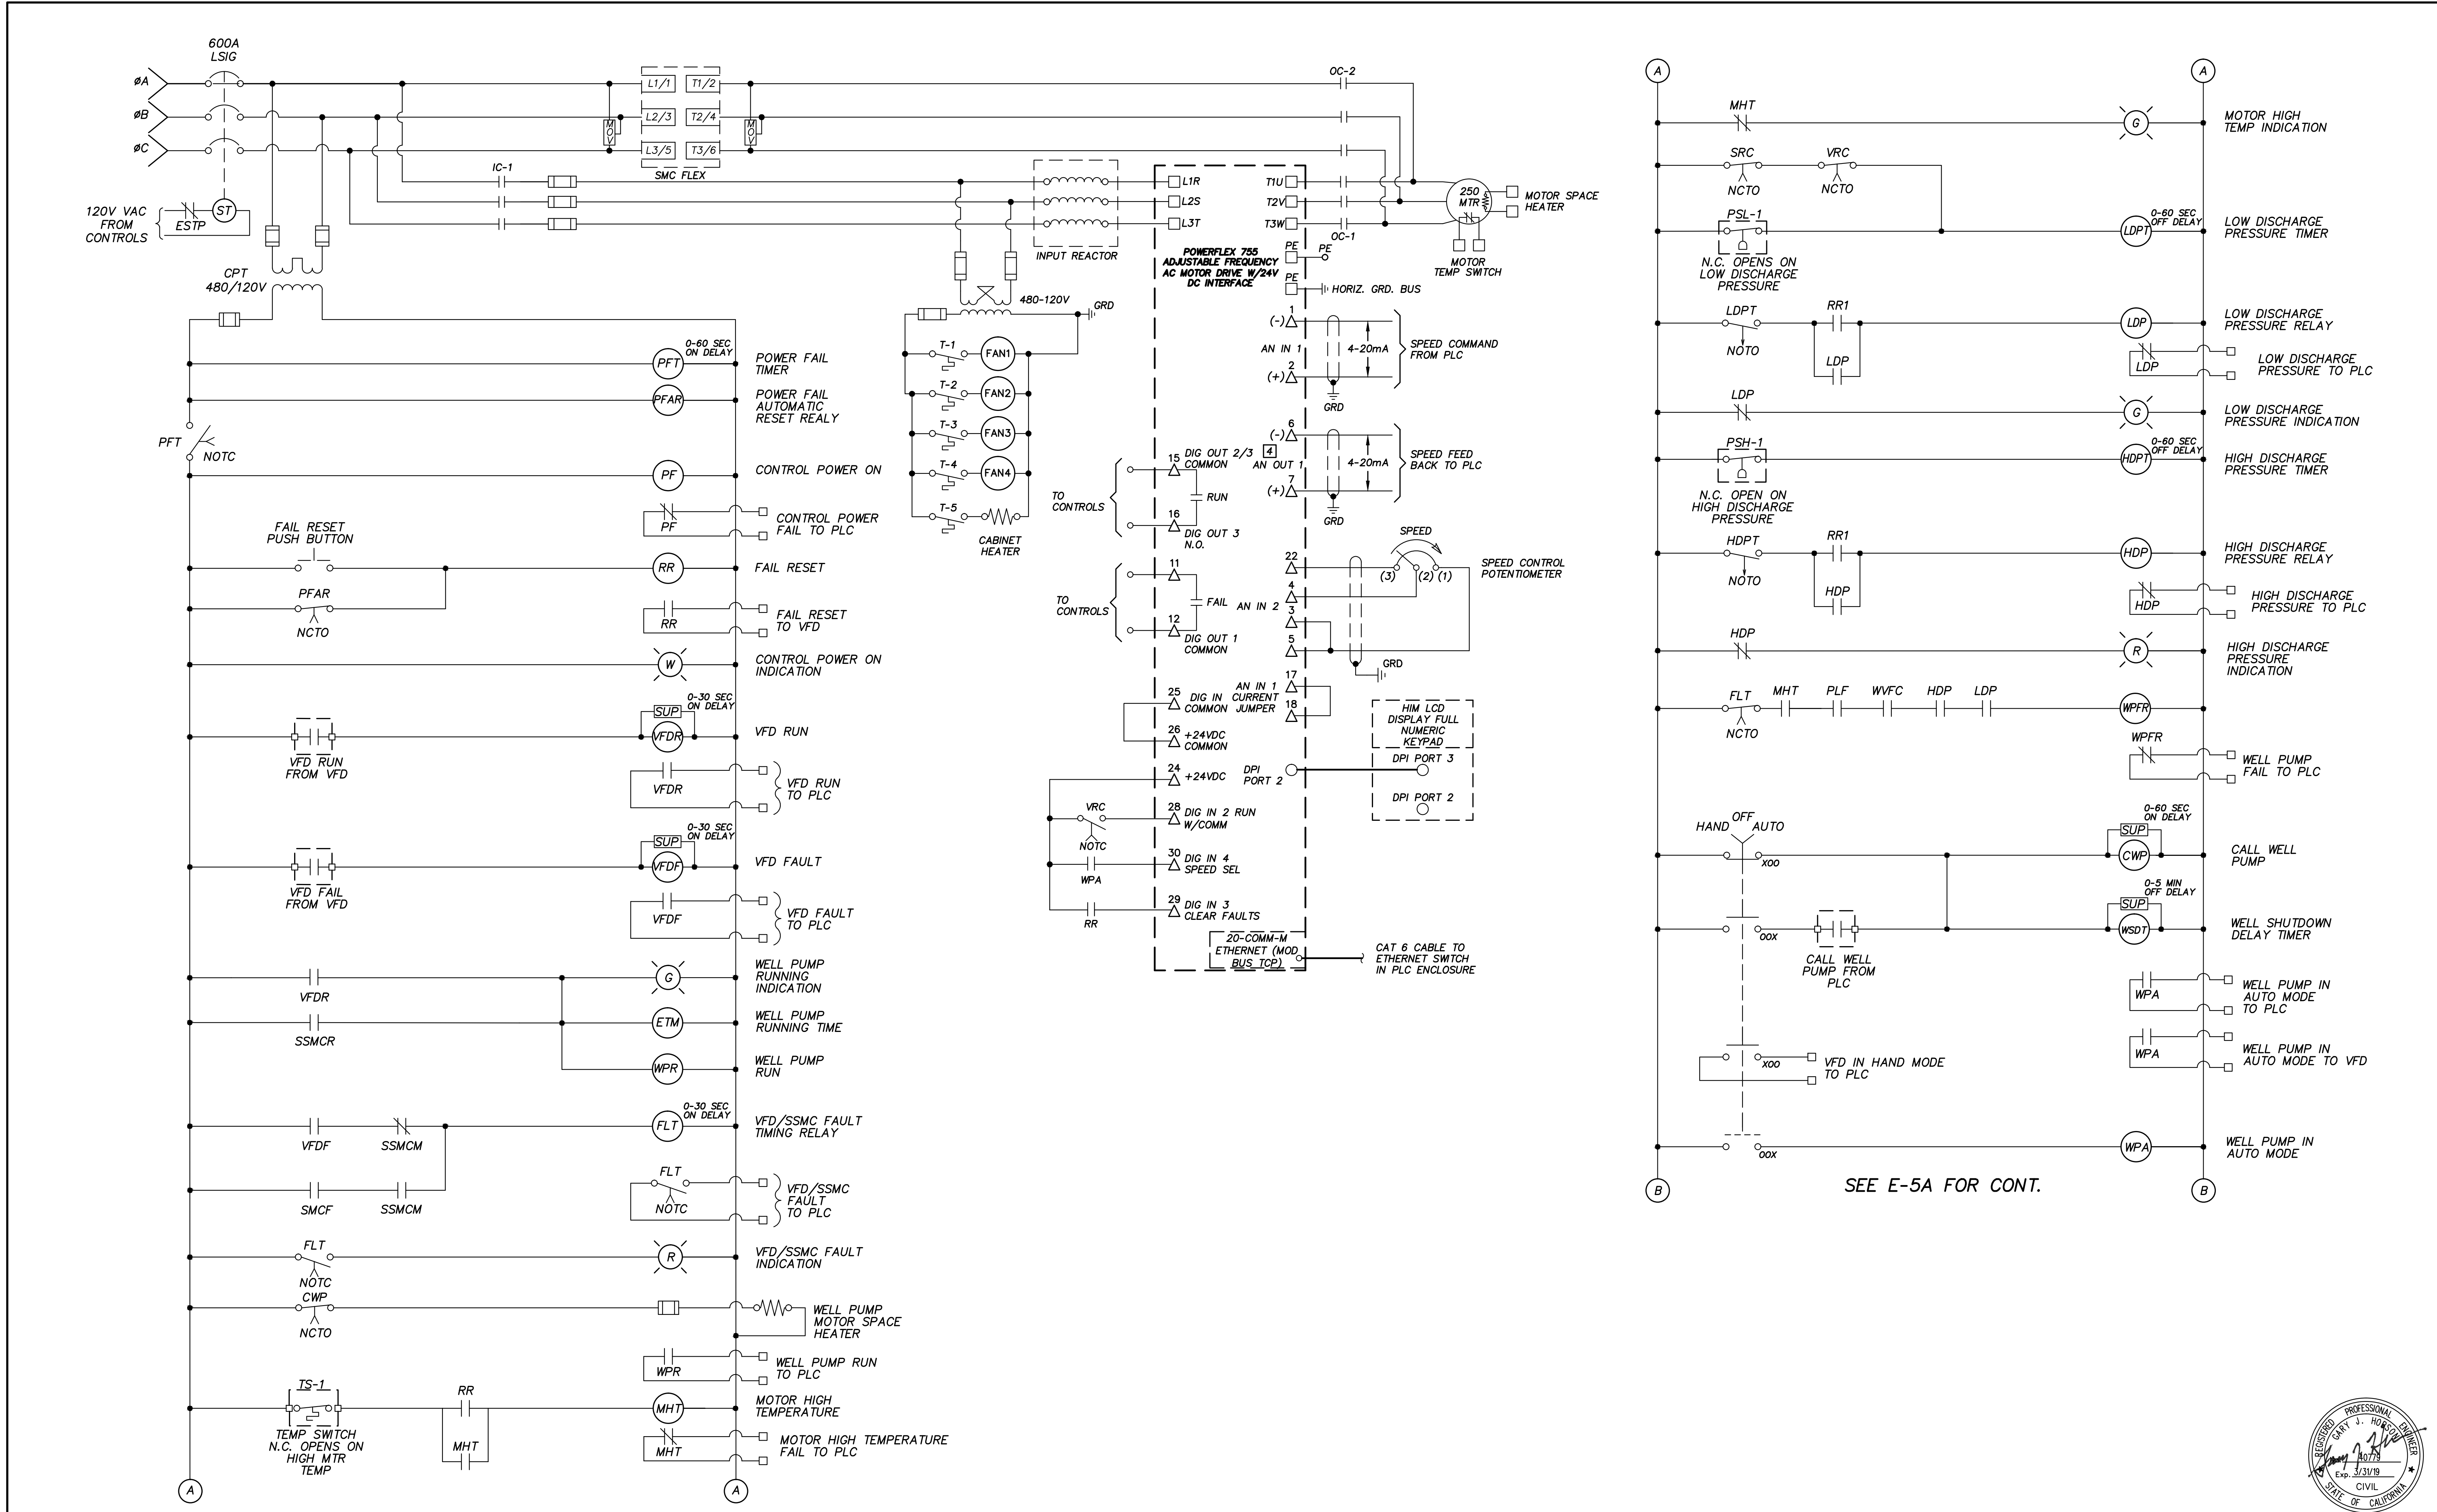

CONTINUED FROM E-5

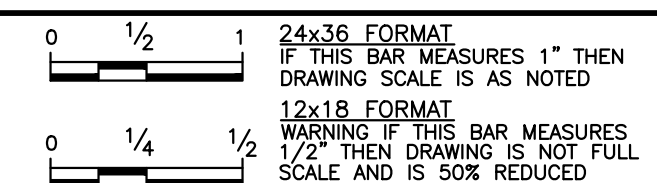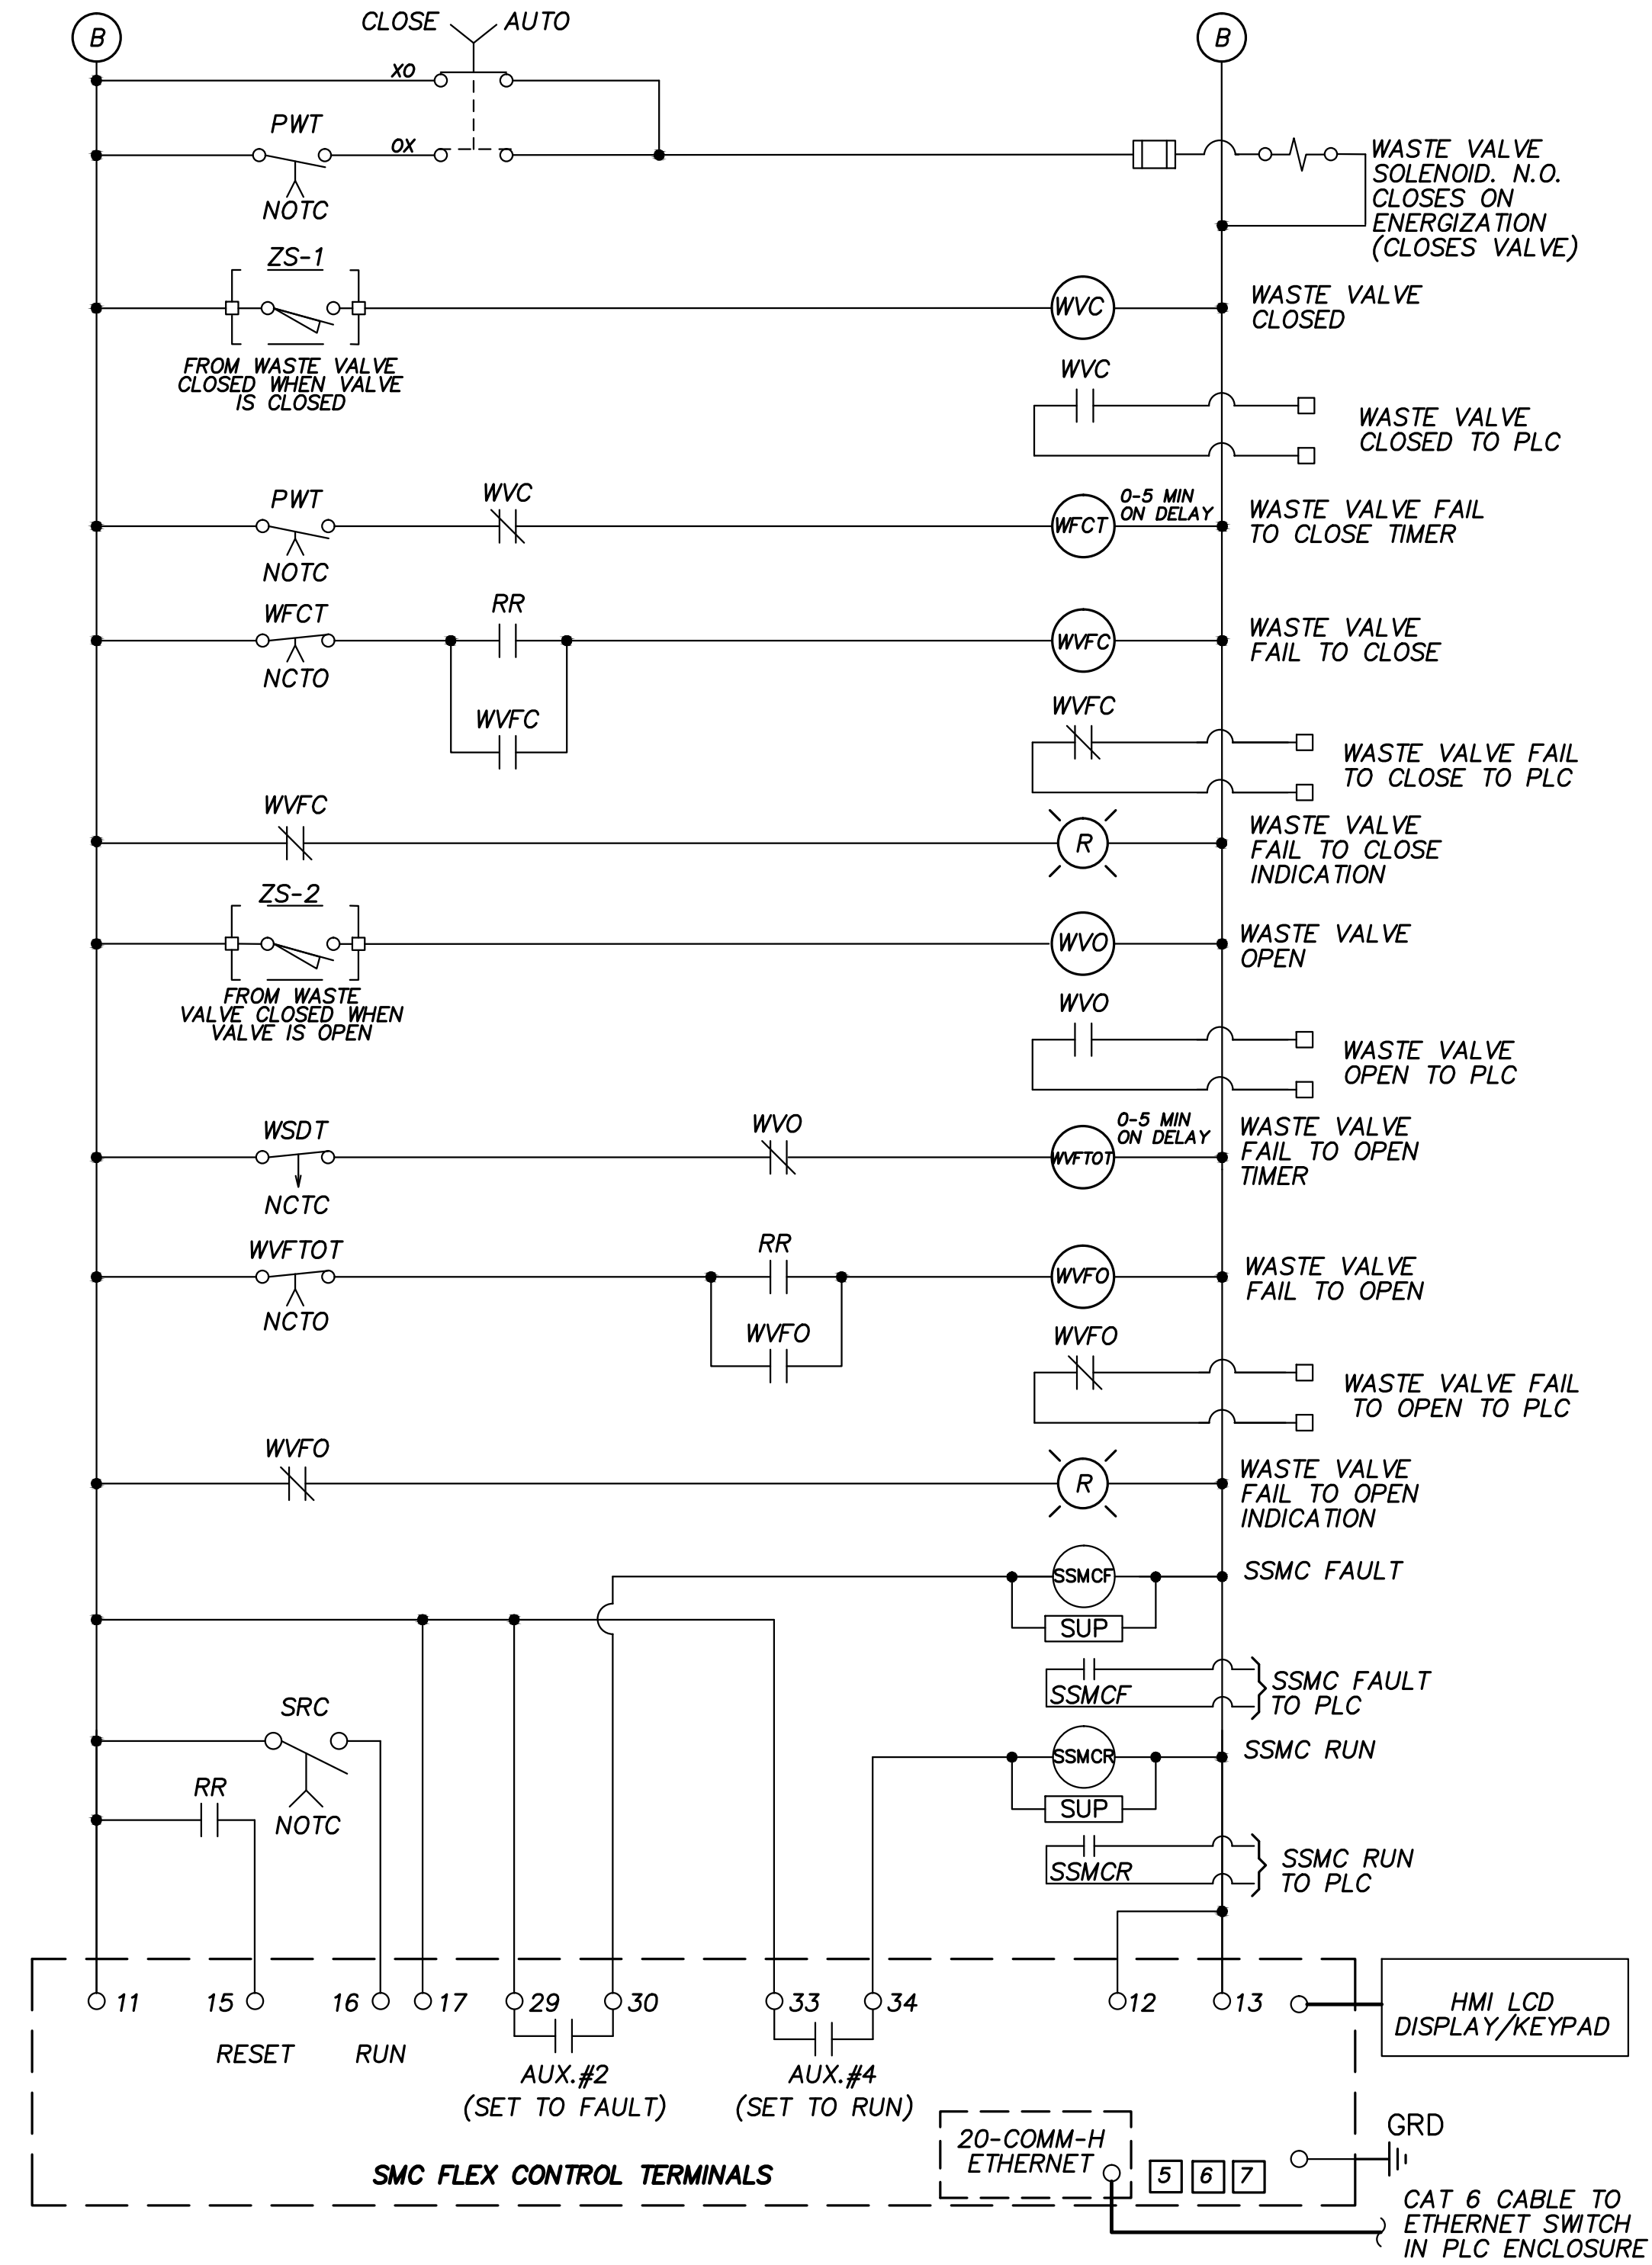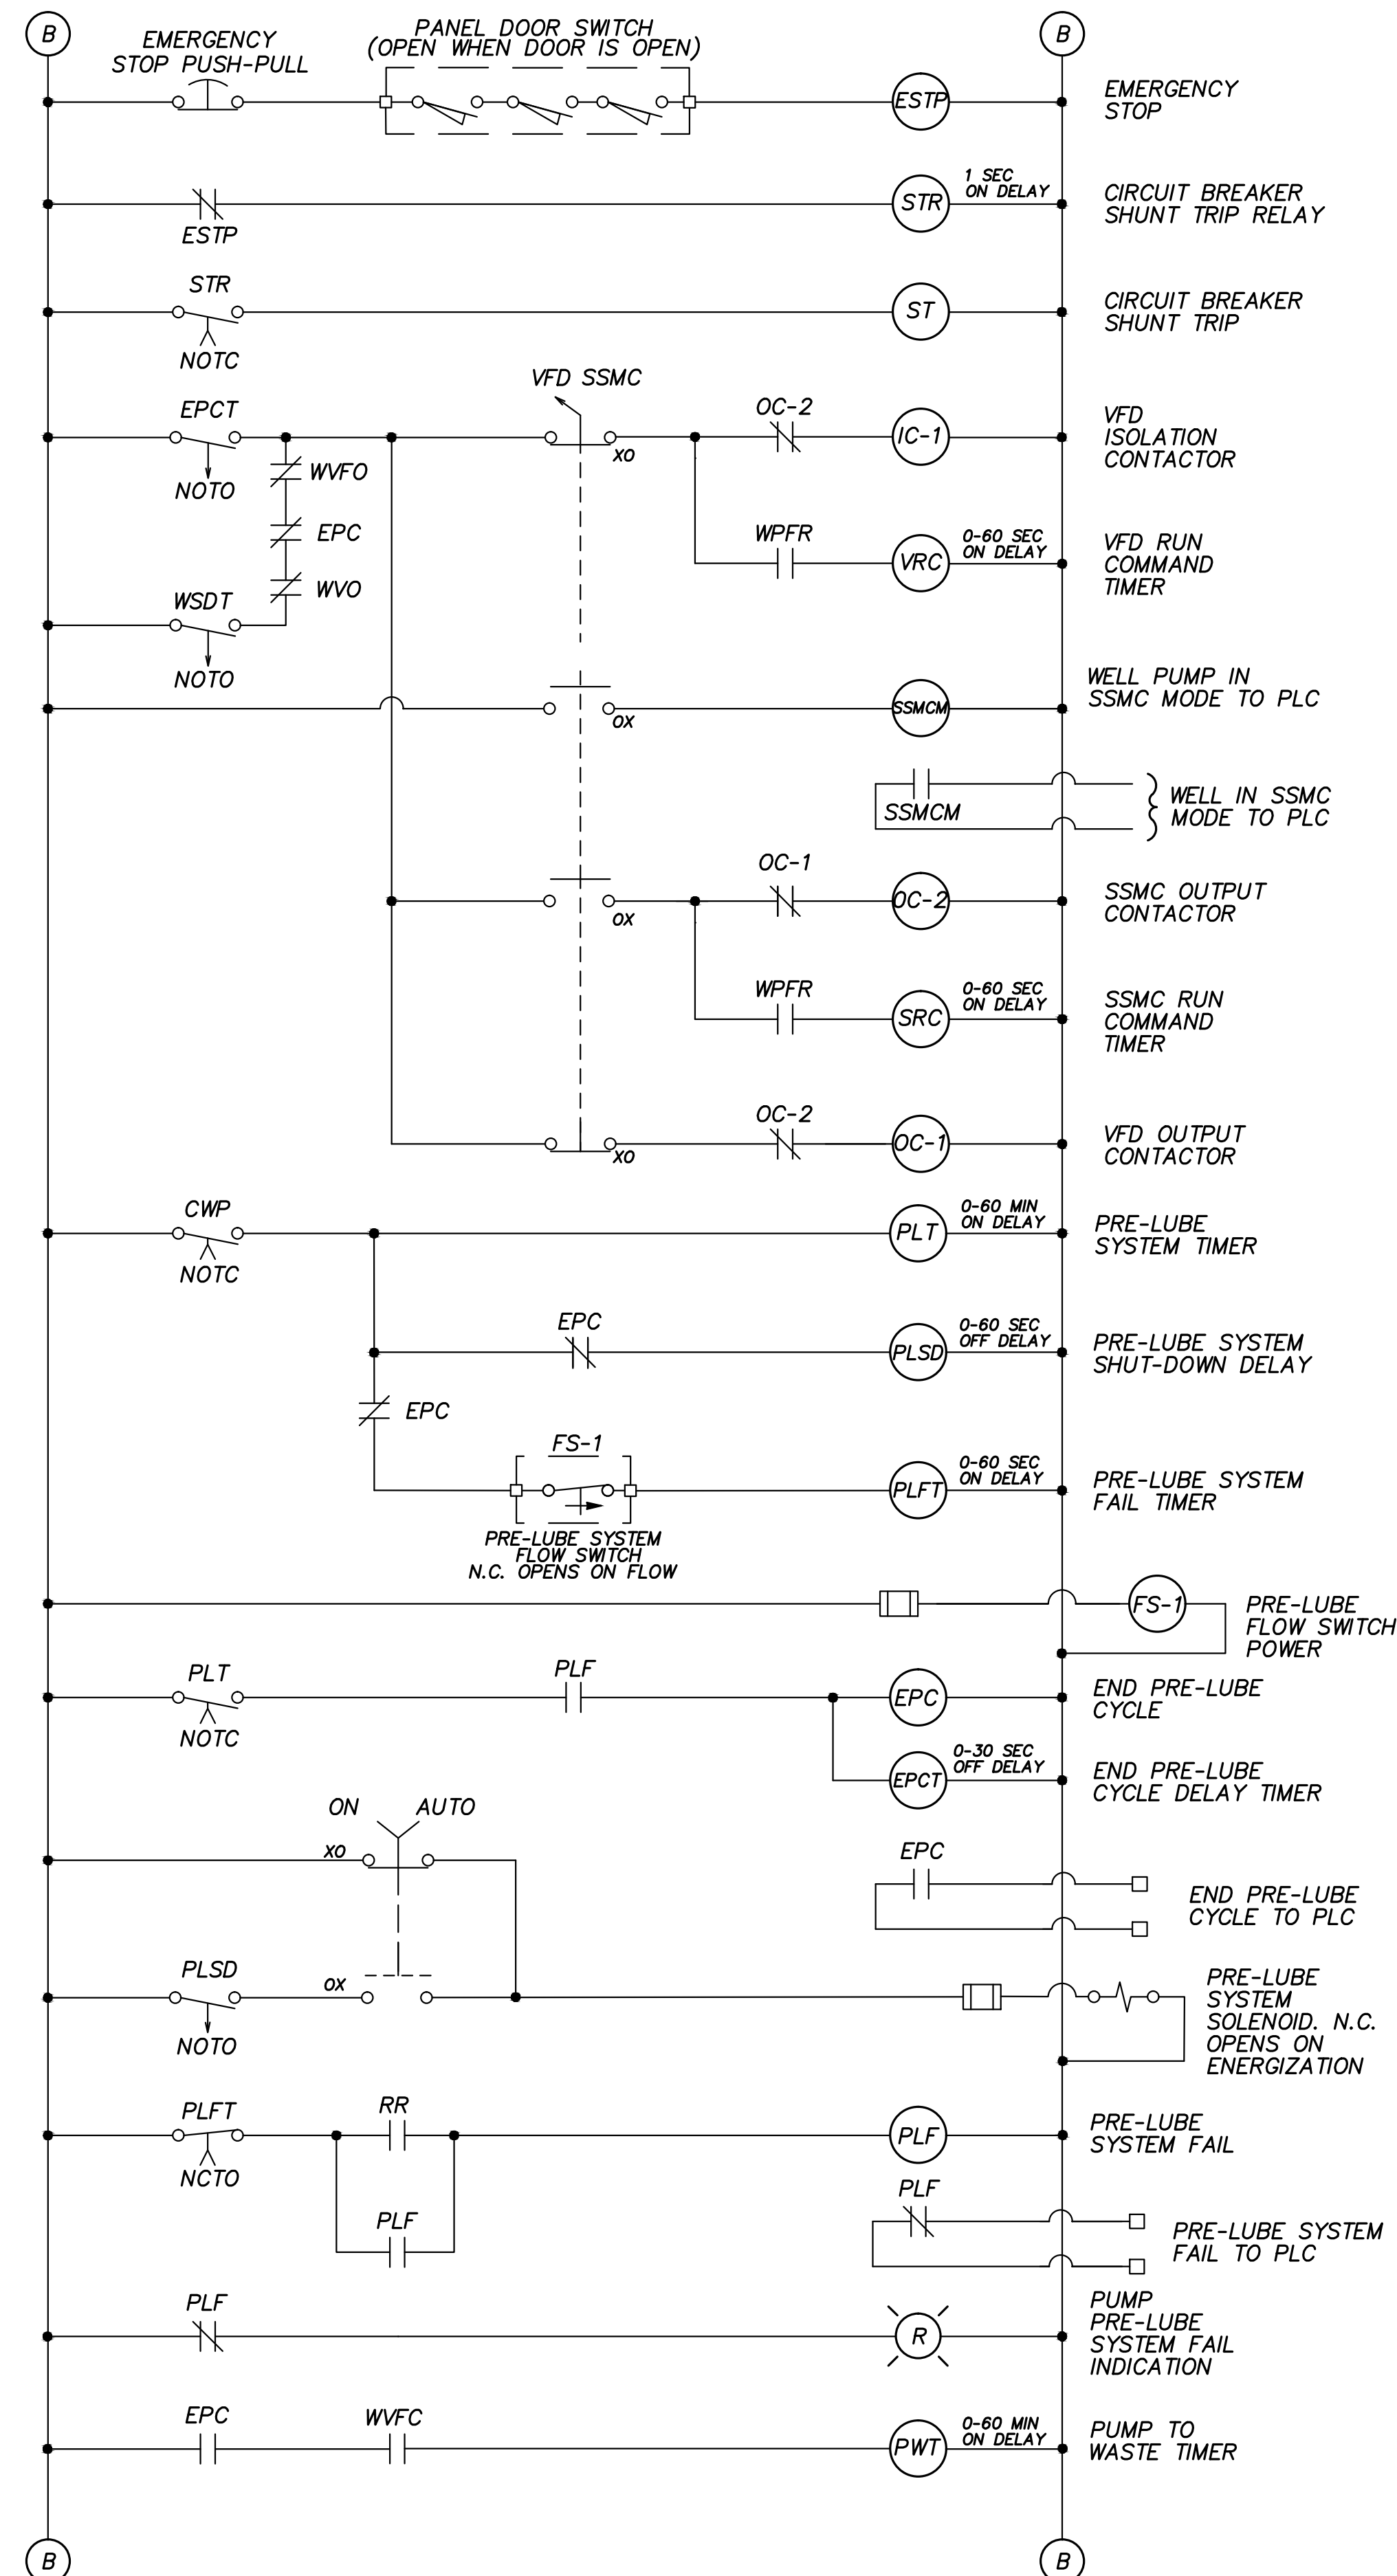

Designed by D. BAKER	Drawn by M.U. R.U.	Checked by G. HOBSON
PLANS PREPARED UNDER SUPERVISION OF GARY J. HOBSON R.C.E. No. 40779		
Date JULY 2017		


Reference Plans for these Improvements		REVISIONS		App'd
Date	By			

AKM AKM CONSULTING ENGINEERS
553 WALD IRVINE, CA. 92618
(949) 753-7333


Engineering _____	Department of Water and Power Approval By: <u>Vernon R. Weisman, P.E.</u> 8/4/2017
Operations _____	District Engineer R.C.E. No. 41610

CITY OF CORONA - RESIN TREATMENT OF NITRATE SOURCES	Drawing No. 13-038U
WELLS 32 AND 33 EQUIPPING WELL VFD CONTROL DIAGRAM II	E-5A
	Sht. 19A of 21



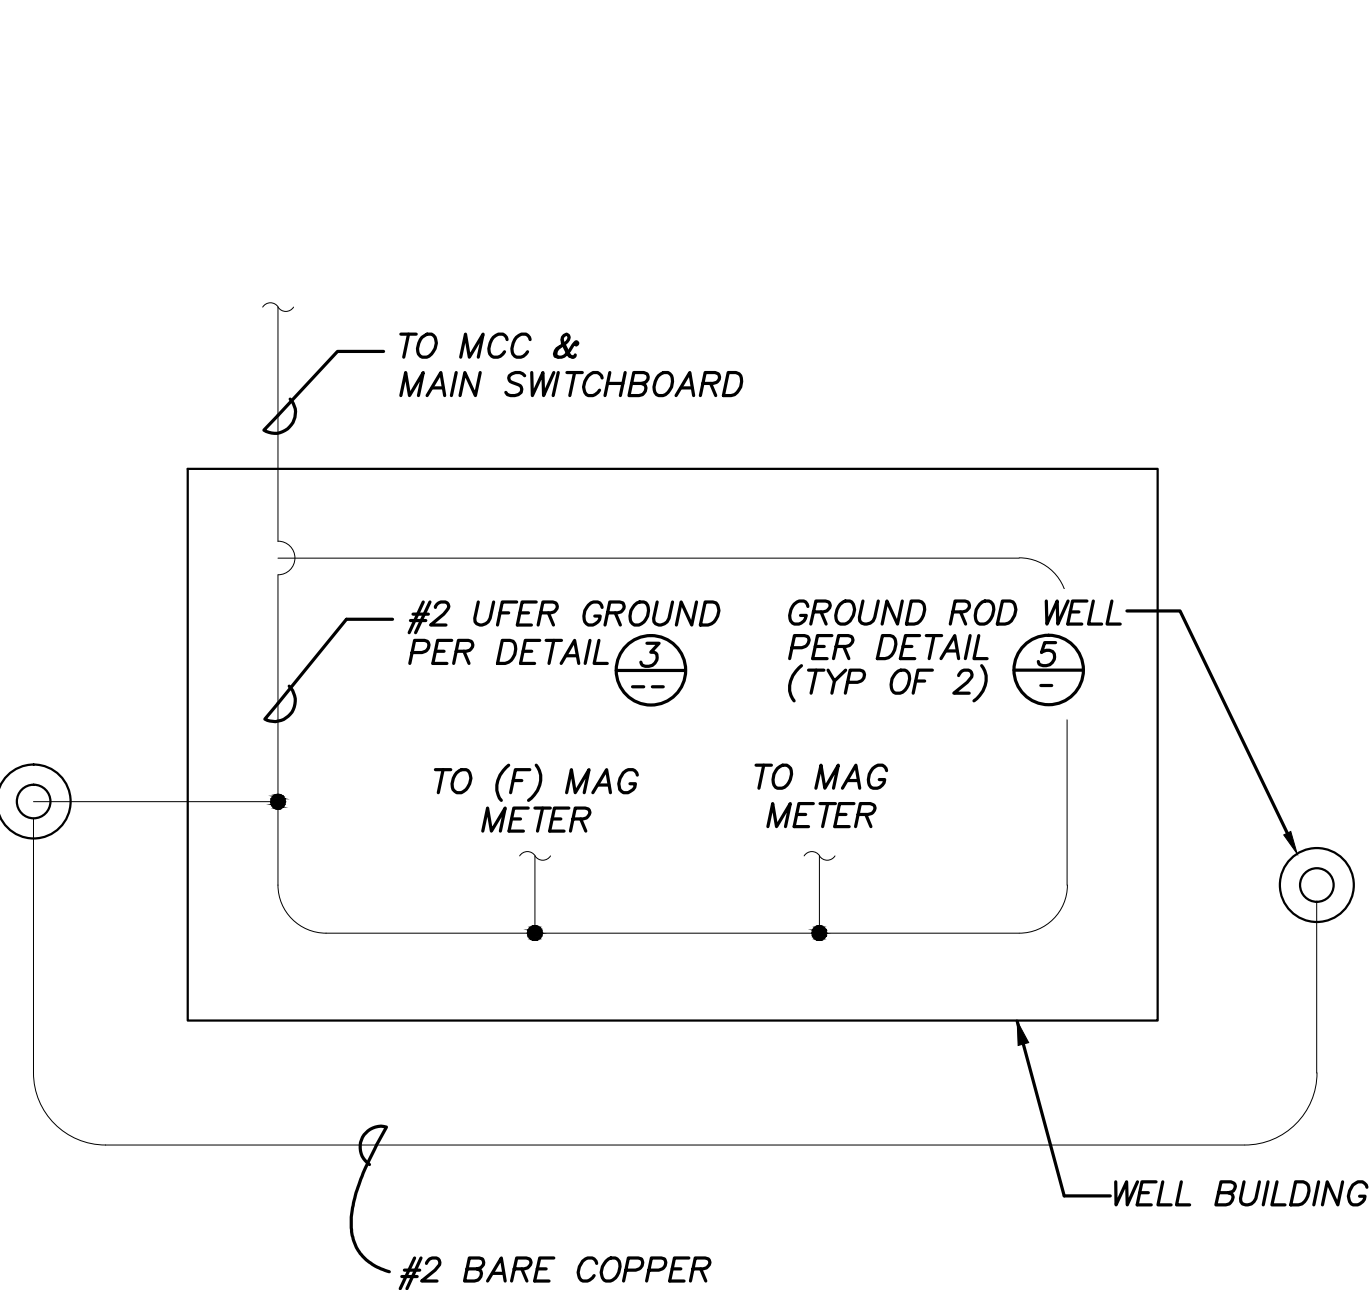


ELECTRICAL GROUNDING SYSTEM PLAN (1) NOT TO SCALE

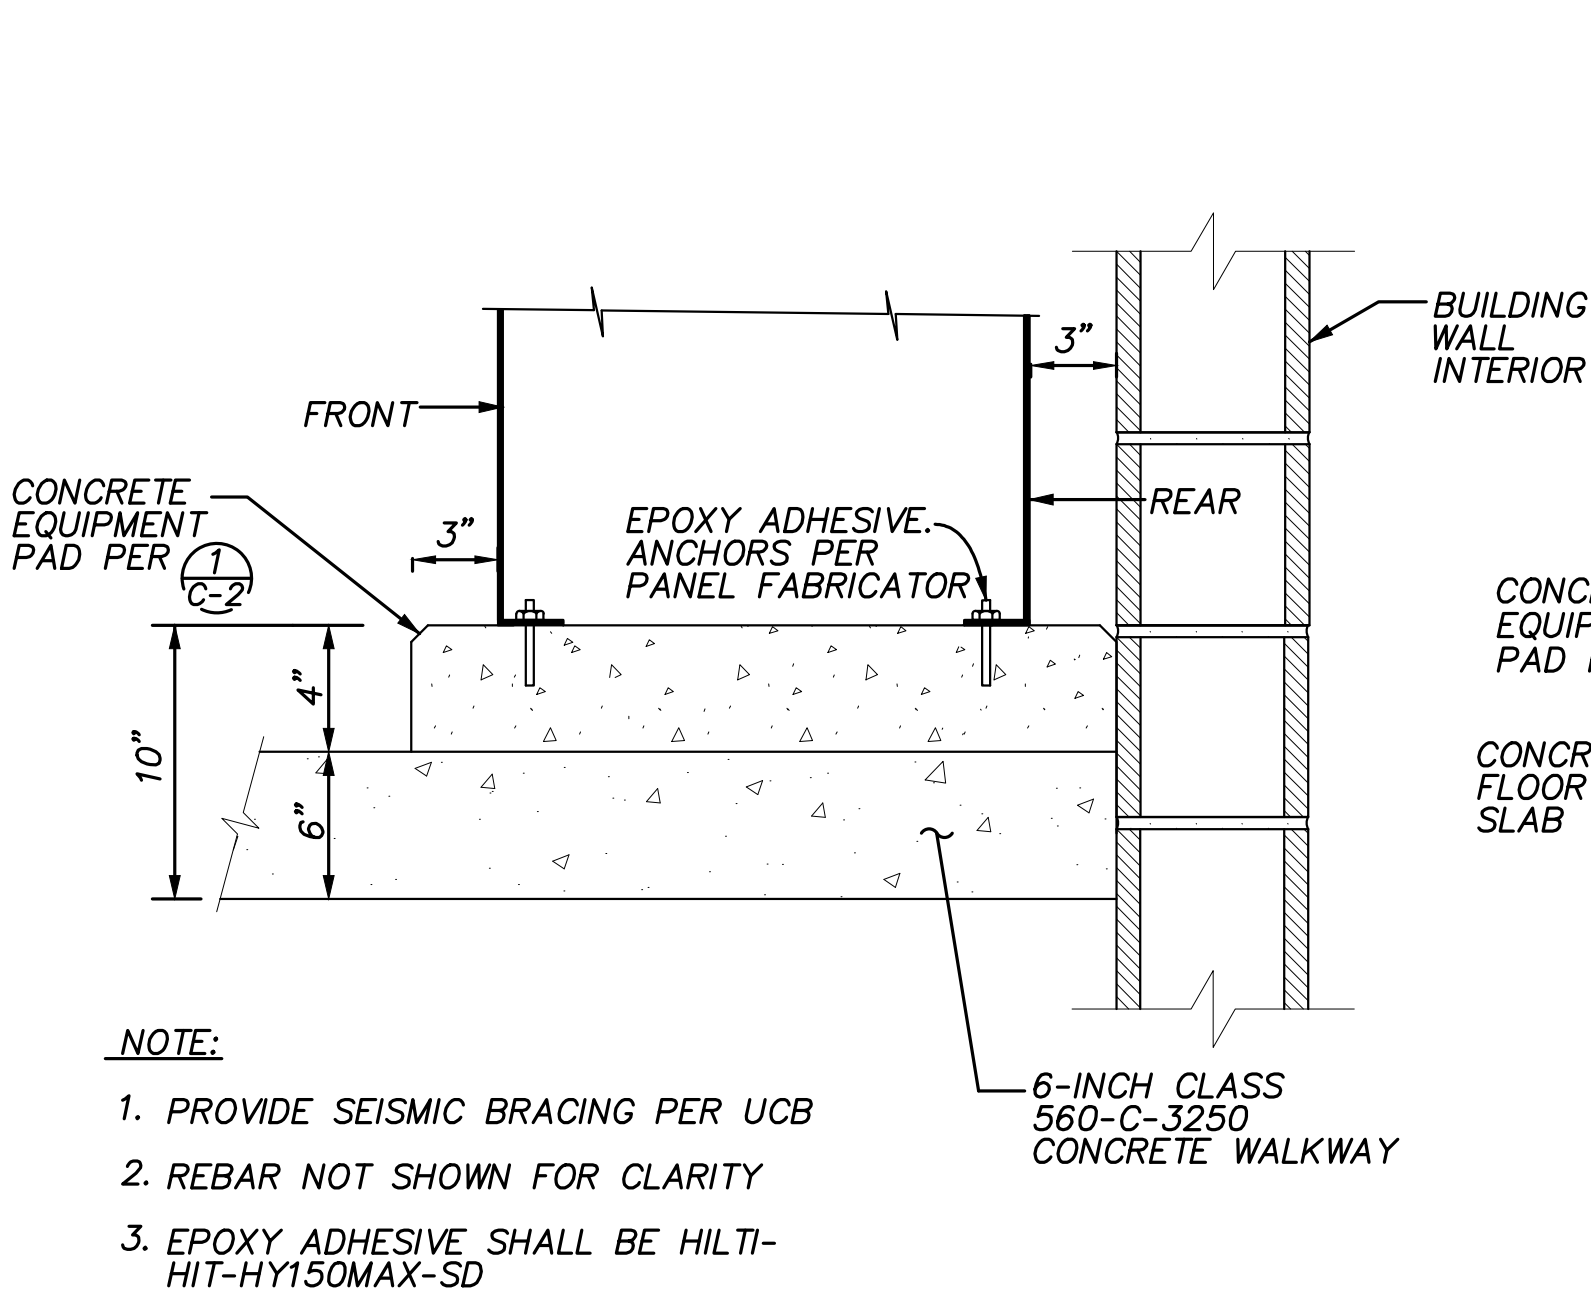


- NOTE:
1. PROVIDE SEISMIC BRACING PER UCB
 2. REBAR NOT SHOWN FOR CLARITY
 3. EPOXY ADHESIVE SHALL BE HILTI-HIT-HY150MAX-SD

SWITCHBOARD MOUNTING

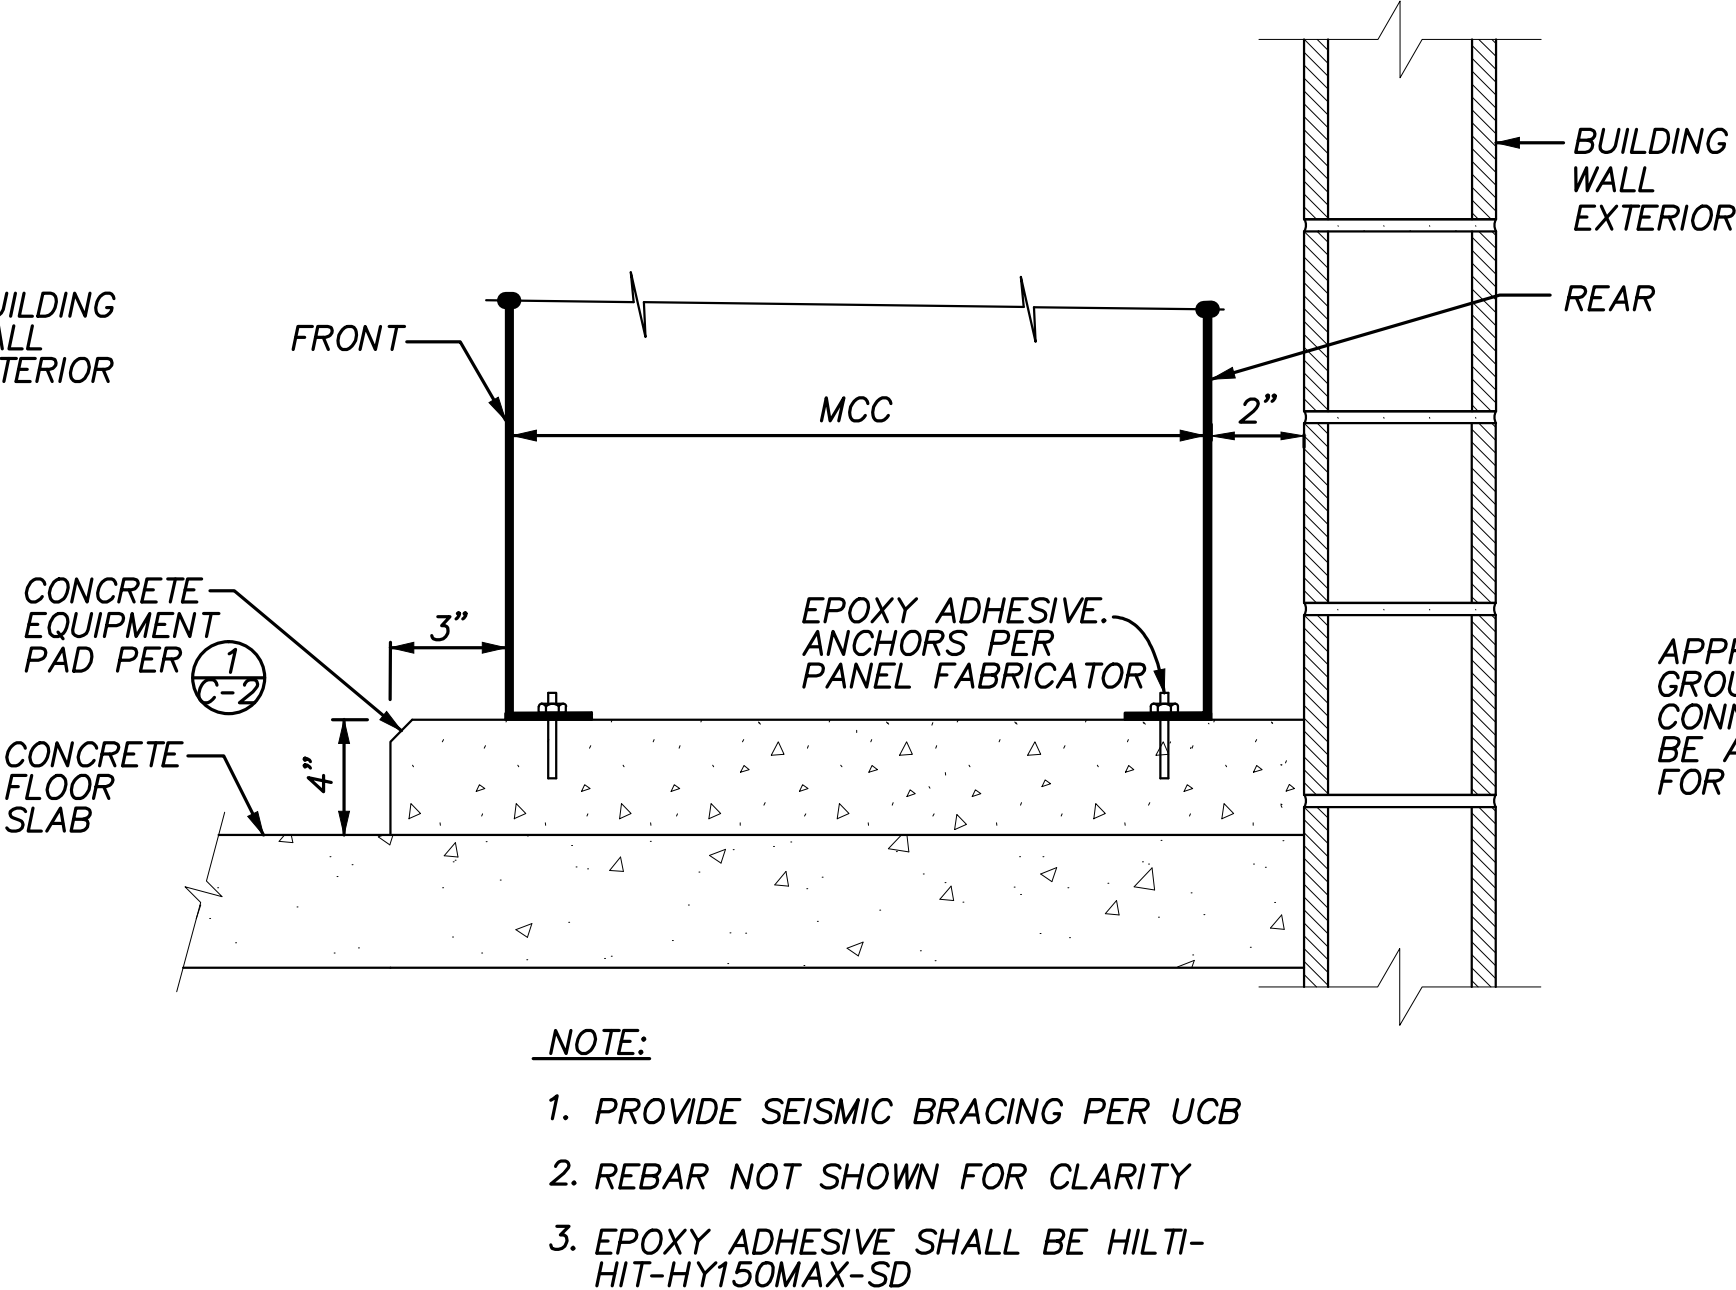


- NOTE:
1. PROVIDE SEISMIC BRACING PER UCB
 2. REBAR NOT SHOWN FOR CLARITY
 3. EPOXY ADHESIVE SHALL BE HILTI-HIT-HY150MAX-SD


MCC MOUNTING

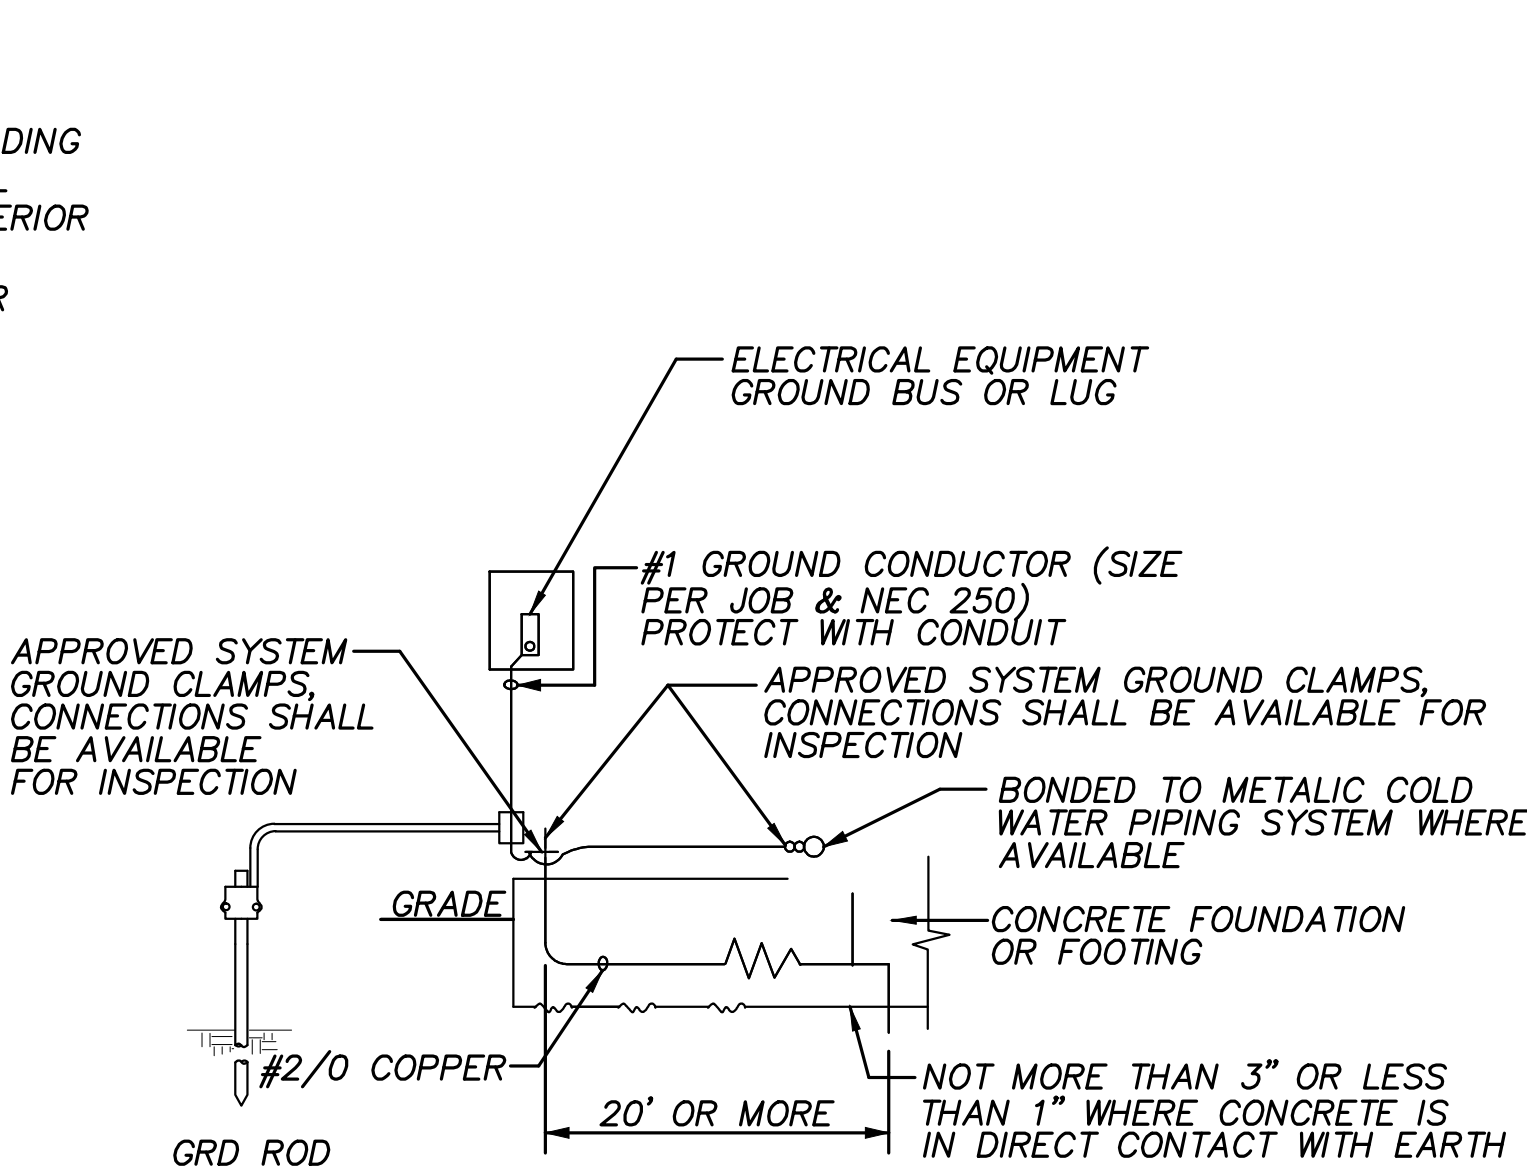


CONCRETE ENCASED (UFER) GROUND DETAIL (3) NOT TO SCALE

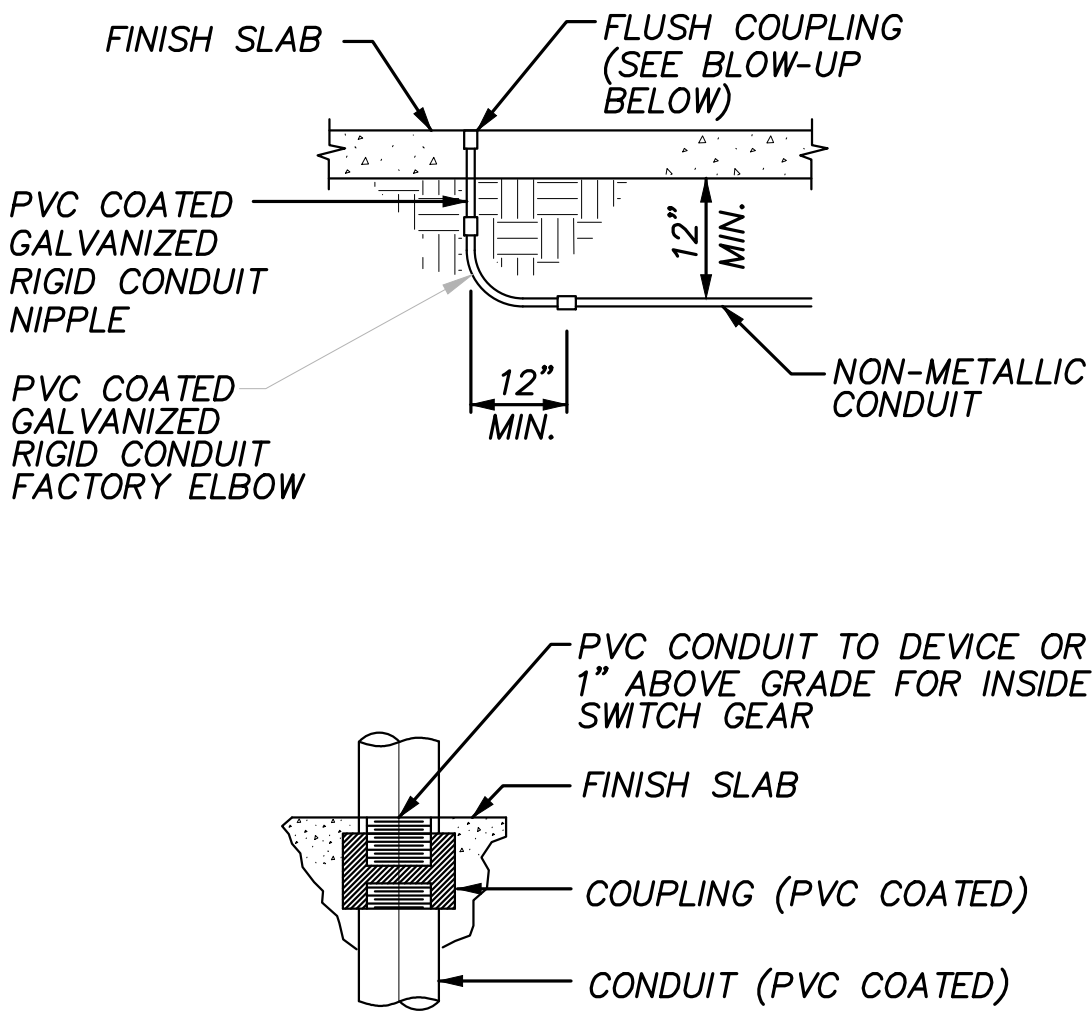


RISER FROM NON METALLIC CONDUIT DETAIL (4) NOT TO SCALE

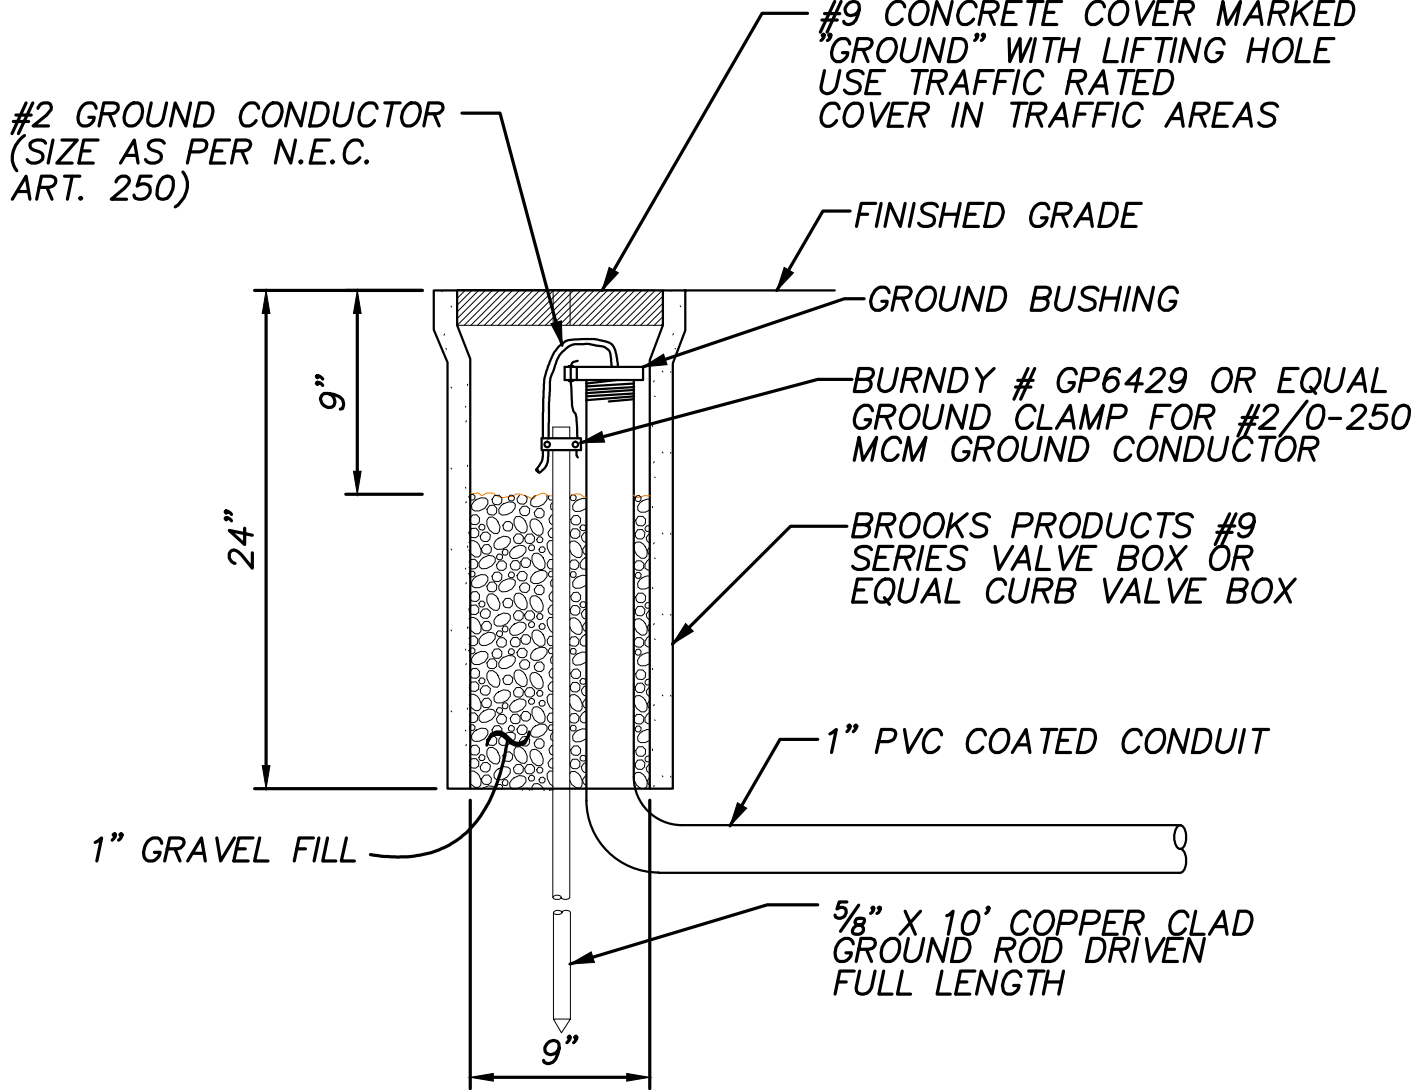

GROUND ROD DETAIL (5) NOT TO SCALE

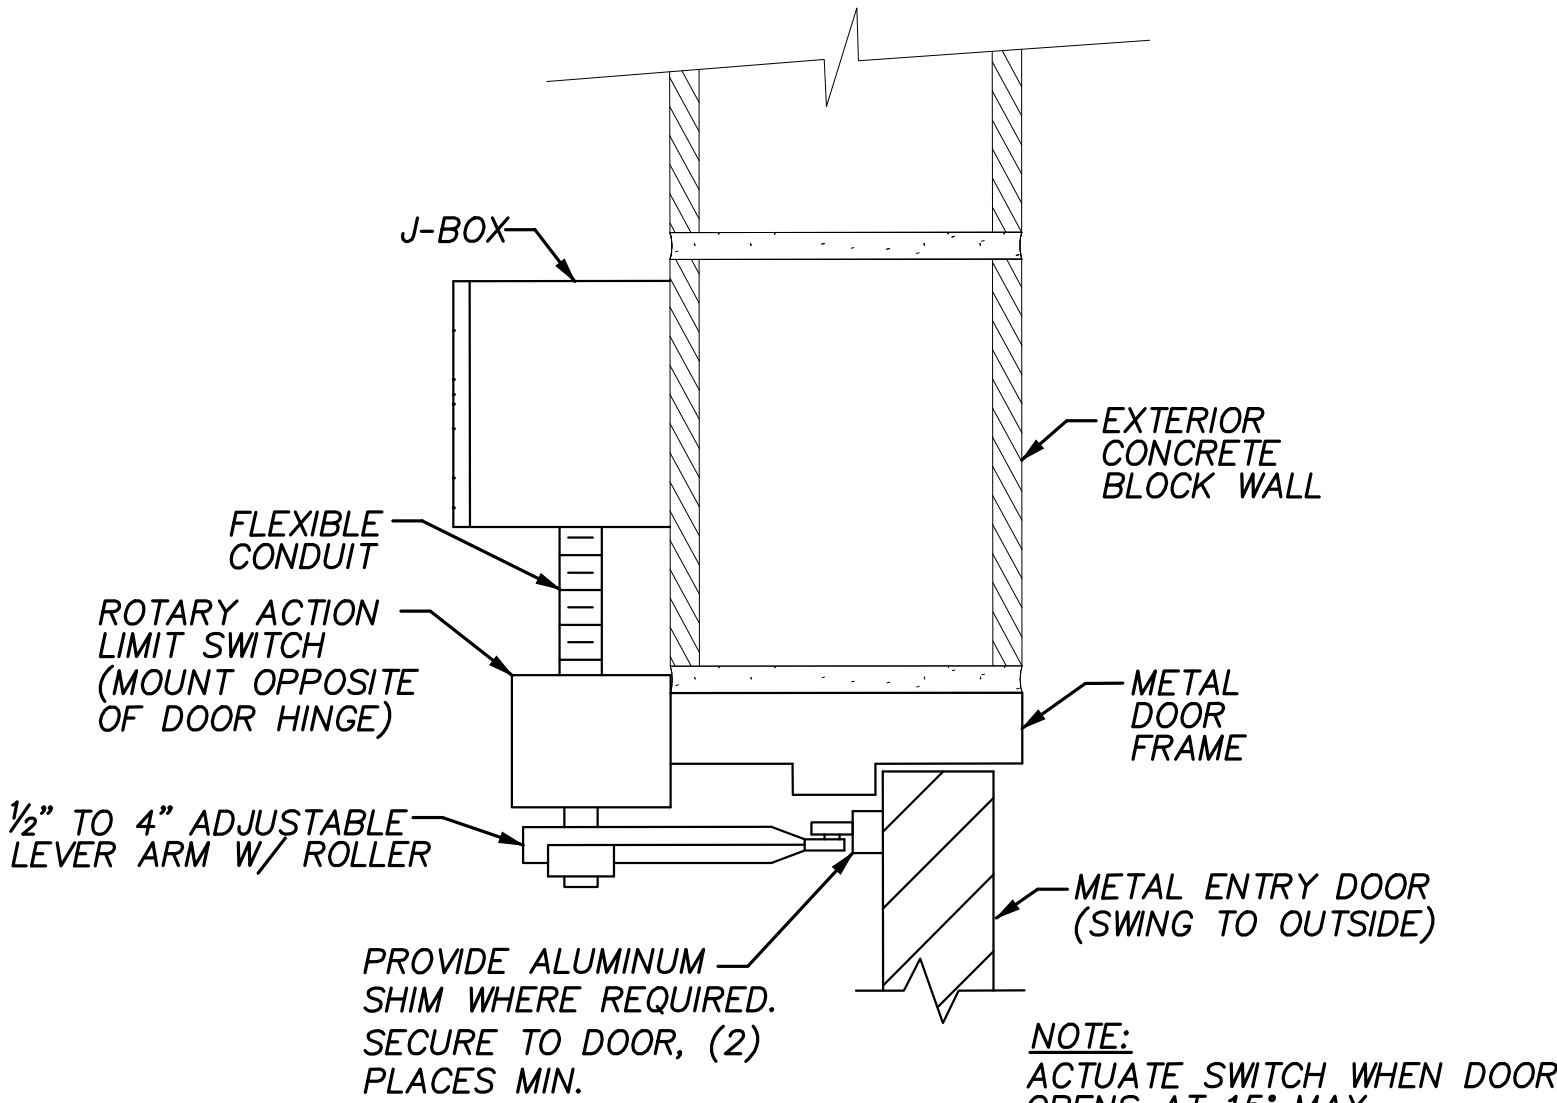


DOOR ENTRY SWITCH (6) NOT TO SCALE

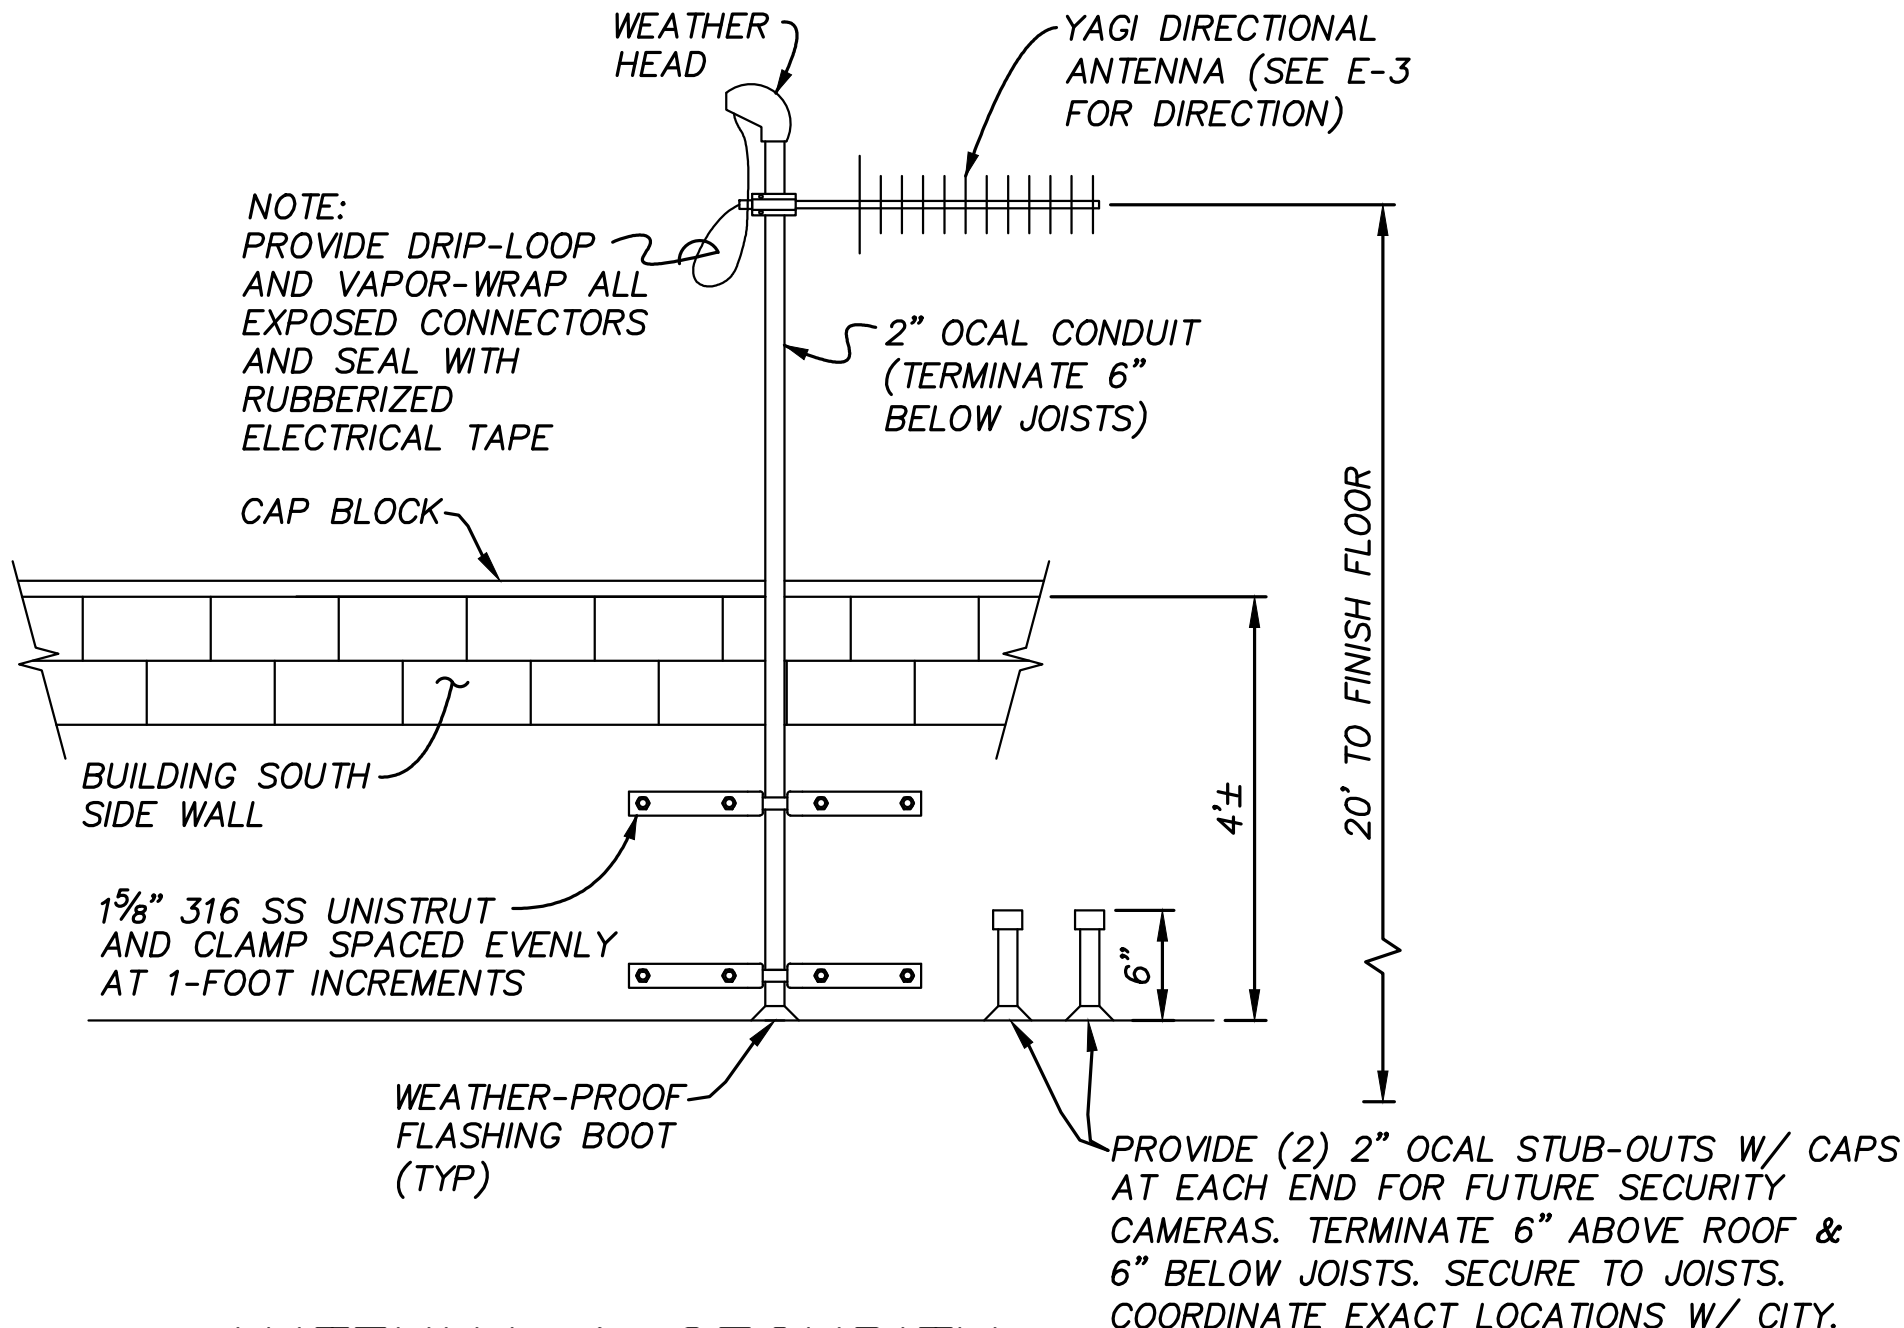

ANTENNA & SECURITY CAMERA STUB-OUT DETAIL (7) NOT TO SCALE

AKM JOB No. 0761209.00

Underground Service Alert
Call: TOLL FREE

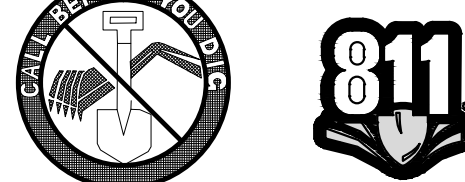


TWO WORKING DAYS BEFORE YOU DIG

0 1/2 1 24x36 FORMAT
IF THIS BAR MEASURES 1" THEN
DRAWING SCALE IS AS NOTED
0 1/4 1/2 12x18 FORMAT
WARNING IF THIS BAR MEASURES
1 1/2" THEN DRAWING IS NOT FULL
SCALE AND IS 50% REDUCED

Designed by D. BAKER
Drawn by M.U. R.U.
Checked by G. HOBSON
PLANS PREPARED UNDER SUPERVISION OF
GARY J. HOBSON
Date JULY 2017 R.C.E. No. 40779

Reference Plans for these Improvements
Date By
REVISIONS
App'd

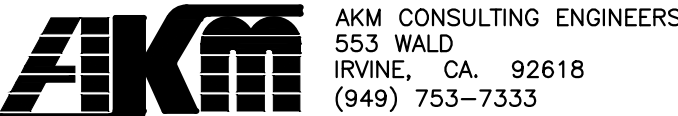


Engineering
Operations

Department of Water and Power Approval
By Vernon R. Weisman, P.E. 8/4/2017
District Engineer
R.C.E. No. 41610

CITY OF CORONA - RESIN TREATMENT OF NITRATE SOURCES
WELLS 32 AND 33 EQUIPPING
GENERAL ELECTRICAL DETAILS

Drawing No. 13-038U
E-6
Sht. 20 of 21



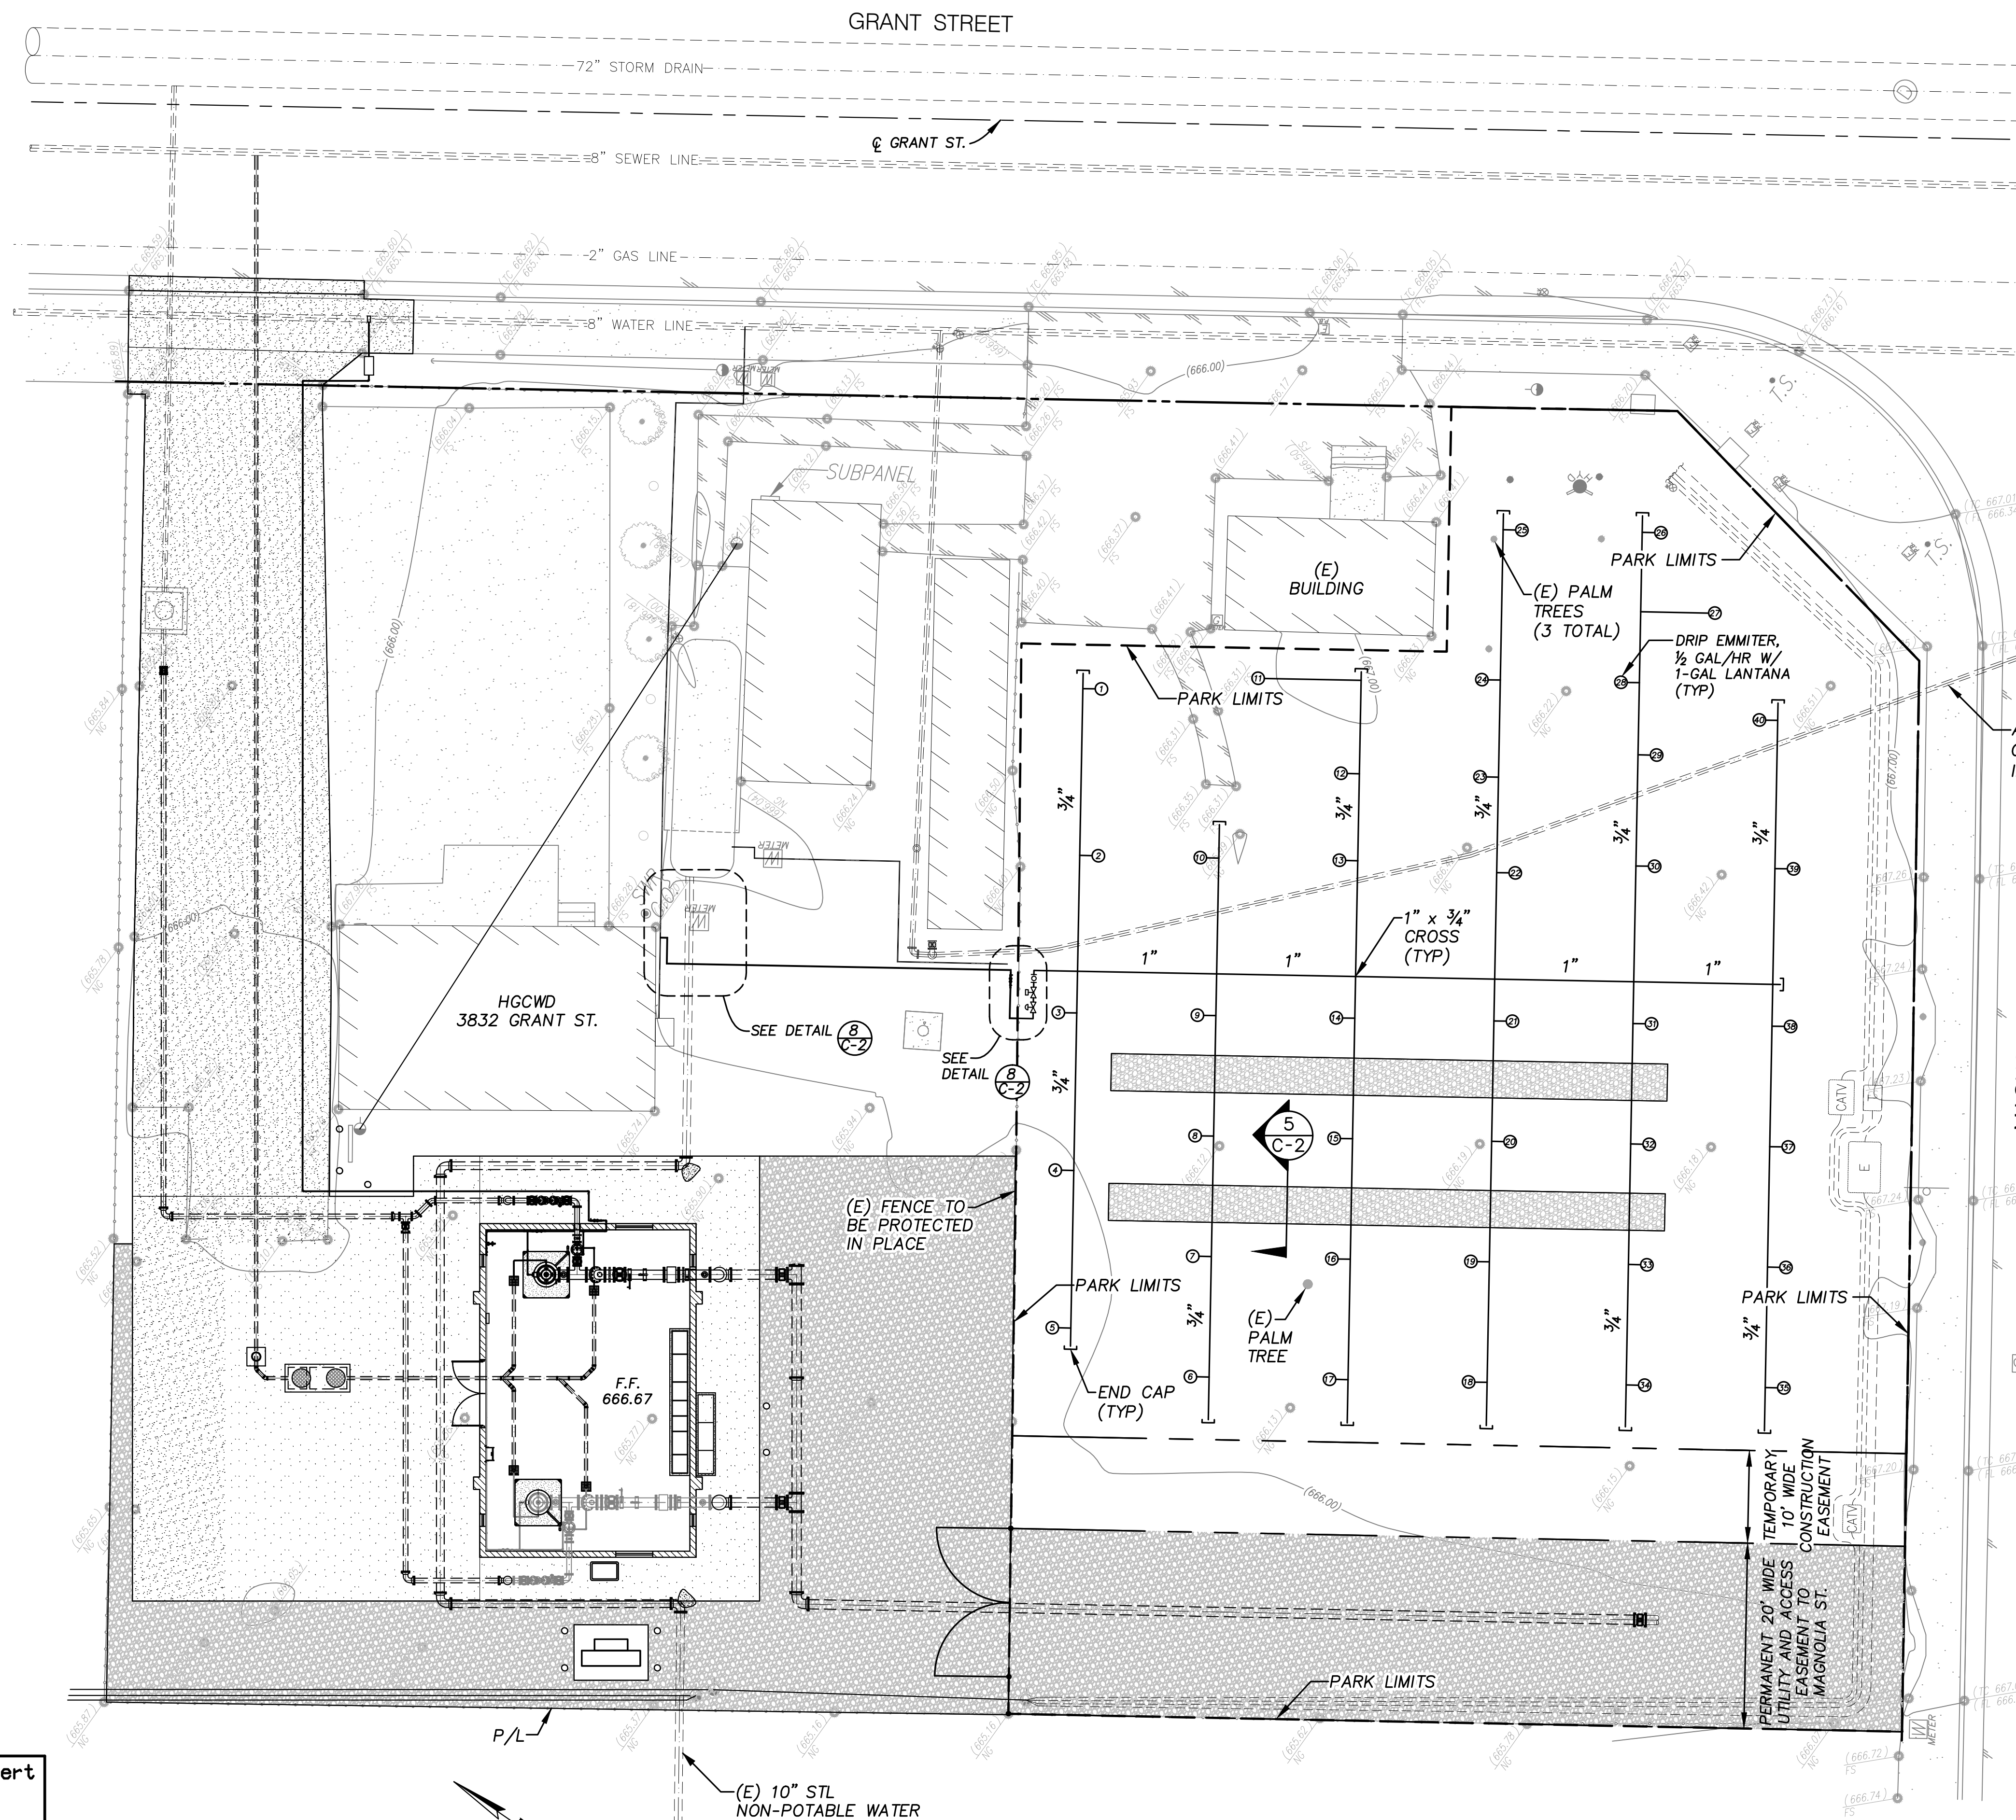

PARK IMPROVEMENT NOTES:

1. CONTRACTOR SHALL REMOVE ALL EXISTING SURFACE VEGETATION AND DEBRIS WITHIN THE PARK LIMITS INDICATED.
2. CONTRACTOR SHALL PROTECT EXISTING IMPROVEMENTS: INCLUDING BURIED: IRRIGATION SYSTEM, WATER MAINS, SCE ELECTRIC UNDERGROUND, FENCING, UTILITY BOXES, AND TREES NOT IDENTIFIED FOR REMOVAL.
3. CONTRACTOR SHALL PROVIDE FINE GRADING TO DIRECT SURFACE FLOW TOWARDS THE CENTER OF THE PARK AND DRAIN TRENCHES.
4. CONTRACTOR SHALL CONSTRUCT 2 (EA) DRAIN TRENCHES 60'-LONG. TRENCHES SHALL CONSIST OF GEOTEXTILE FABRIC THAT COMPLETELY WRAPS 3/4-INCH UNIFORM/CLEAN GRAVEL. 6-INCH OF TOP SOIL SHALL BE PLACED ON TOP OF THE DRAIN TRENCH. SEE SECTIONS 31 05 16 FOR AGGREGATE AND 33 46 26 FOR GEOTEXTILE FABRIC SPECIFICATIONS. THE CITY SHALL LOCATE TRENCH PLACEMENT FOLLOWING FINE GRADING.
5. CONSTRUCT DRIP IRRIGATION SYSTEM PER DRAWING L-1 AND TIE-IN TO (E) WATER SUPPLY PER DETAIL 8, DRAWING C-2.
6. CONTRACTOR SHALL PROVIDE AND INSTALL FORTY (40) 1-GALLON SIZE "PURPLE TRAILING LANTANA" (L. MONTEVIDENSIS) PER PLAN, ONE AT EACH DRIP EMITTER.
7. CONTRACTOR SHALL PROVIDE 2-INCH MULCH LAYER OVER THE PARK LIMITS INDICATED, EXCLUDING THE CRUSHED ROCK UTILITY AND ACCESS EASEMENT. MULCH SHALL BE UNDERPLAYED BY A GEOTEXTILE WEED BARRIER WITH OVERLAPPING SEAMS. SEE 31 05 19 FOR GEOTEXTILE FABRIC SPECIFICATIONS.

APPROXIMATE LOCATION
OF 6" C900 WATERLINE
IN 10" STEEL CASING

SITE PLAN



CAUTION! OVERHEAD POWER LINES

AKM JOB No. 0761209.00

Underground Service Alert
Call: TOLL FREE



TWO WORKING DAYS BEFORE YOU DIG

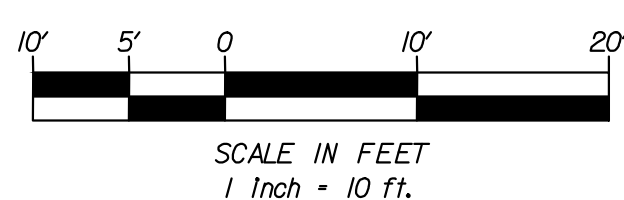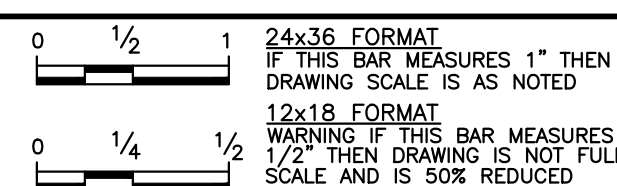

Designed by D. BAKER Drawn by M.U. R.U. Checked by G. HOBSON
PLANS PREPARED UNDER SUPERVISION OF
Date JULY 2017 GARY J. HOBSON R.C.E. No. 40779

Reference Plans for these Improvements

Date

By

REVISIONS

App'd



AKM CONSULTING ENGINEERS
553 WALD
IRVINE, CA. 92618
(949) 753-7333

Engineering
Operations

Department of Water and Power Approval
By: [Signature] 8/4/2017
Vernon R. Weisman, P.E.
District Engineer
R.C.E. No. 41610

CITY OF CORONA - RESIN TREATMENT OF NITRATE SOURCES
WELLS 32 AND 33 EQUIPPING
LANDSCAPING AND IRRIGATION PLAN

Drawing No. 13-038U
L-1
Sht. 21 of 21

